

RE: Verhoff Machine and Welding
Report
Drinking Water Program
Putnam County
PWS ID: OH6943312

RECEIVED

FEB 16 2017

OHIO E.P.A.
N.W.D.O.

February 14, 2017

To whom it may concern ,

I am the operator of record for the public water supplies in the envelope, the information is for the lead and copper mapping and sample locations as indicated by law. Should you have any questions please feel free to contact me.

Thank You

Steve Backus

(419) 302-3166

Stevebackus64@gmail.com

Verhoff Machine and Welding

7300 Rd. 18

Continental, OH. 45831



419-596-3202

PWS- OH6943312

- Verhoff Machine and Welding is a Nontransient Noncommunity System
- VMW is a small family owned fabrication facility

The current system is supplied by 1 well pump that passes thru alternating softeners and then thru a series of retention tanks. That then has peroxide injected to oxidize the h₂s in the incoming water. Then water comes in contact with UV disinfection and then passes thru a small R/O system to a 2000 gal. tank for usage.

The system consist of entirely of pvc to the fixtures on the system.

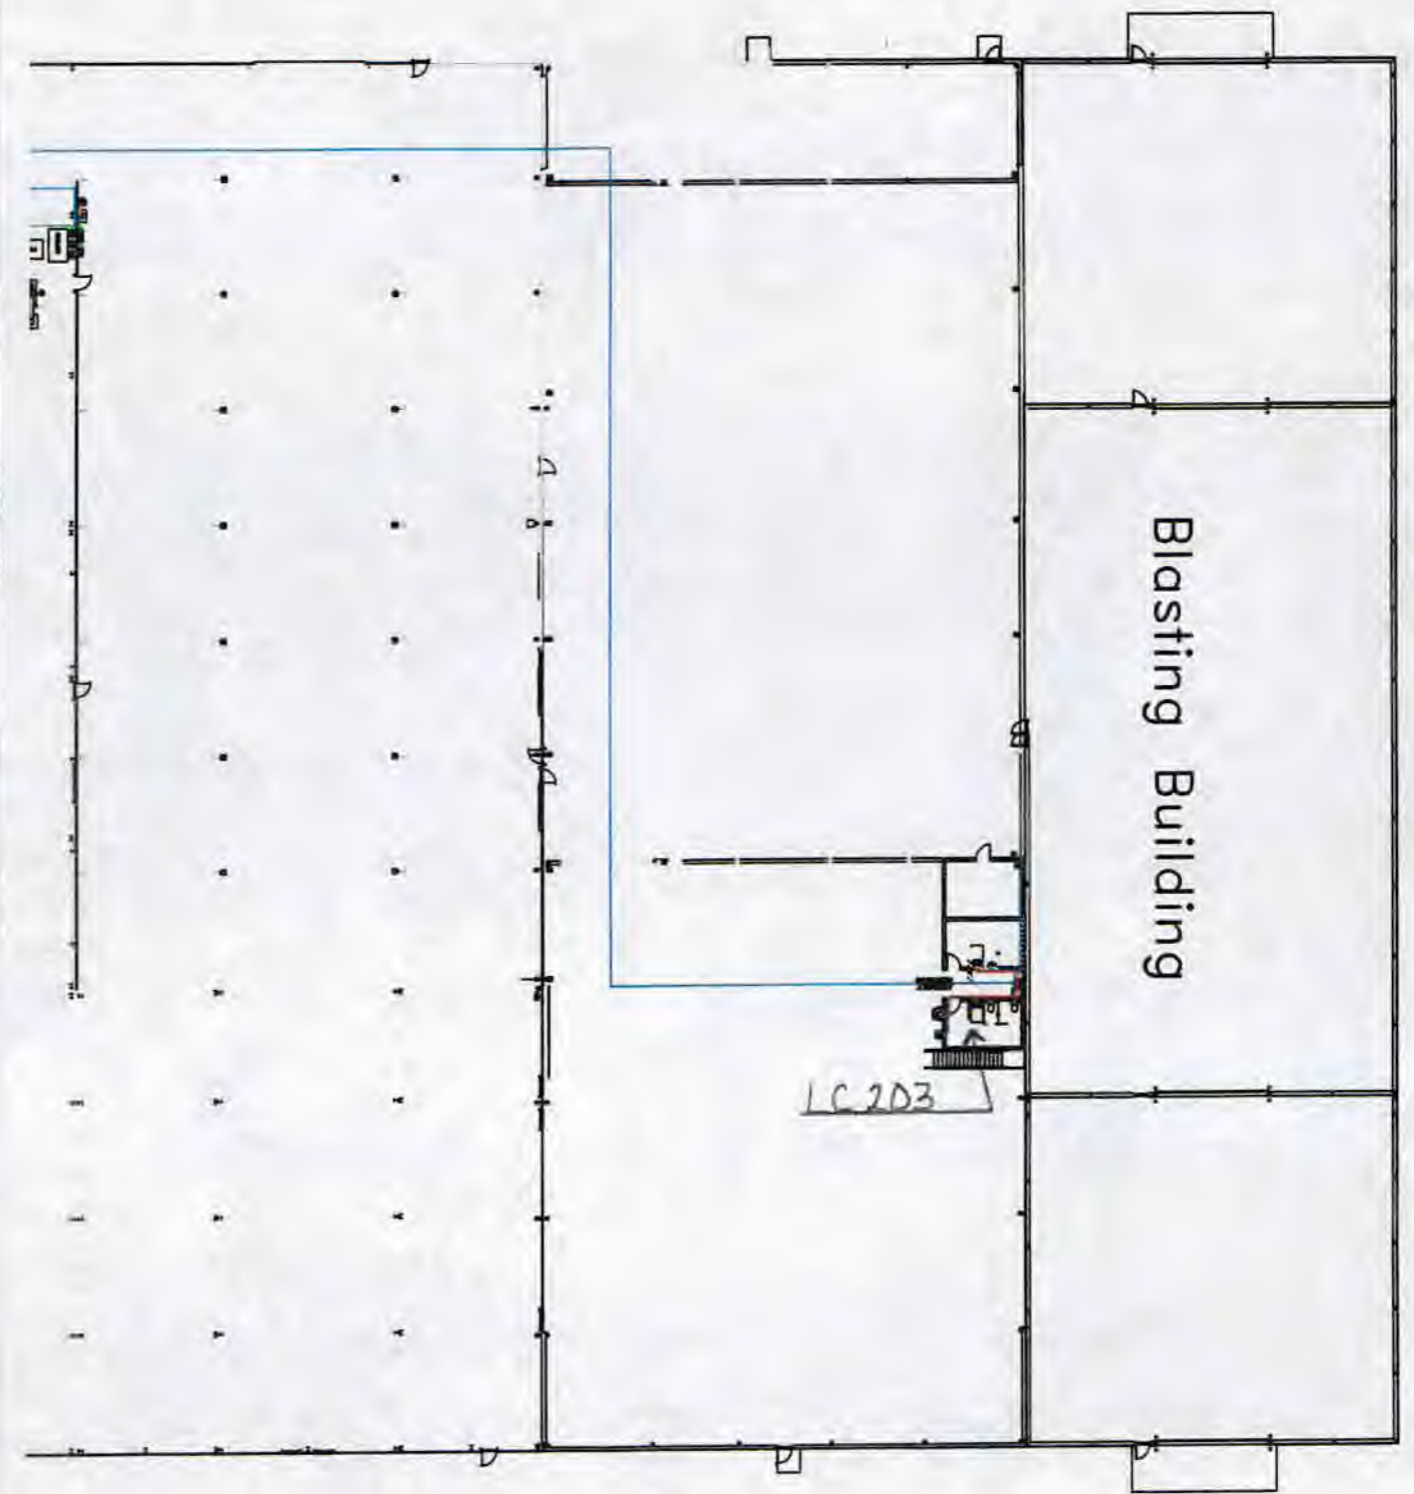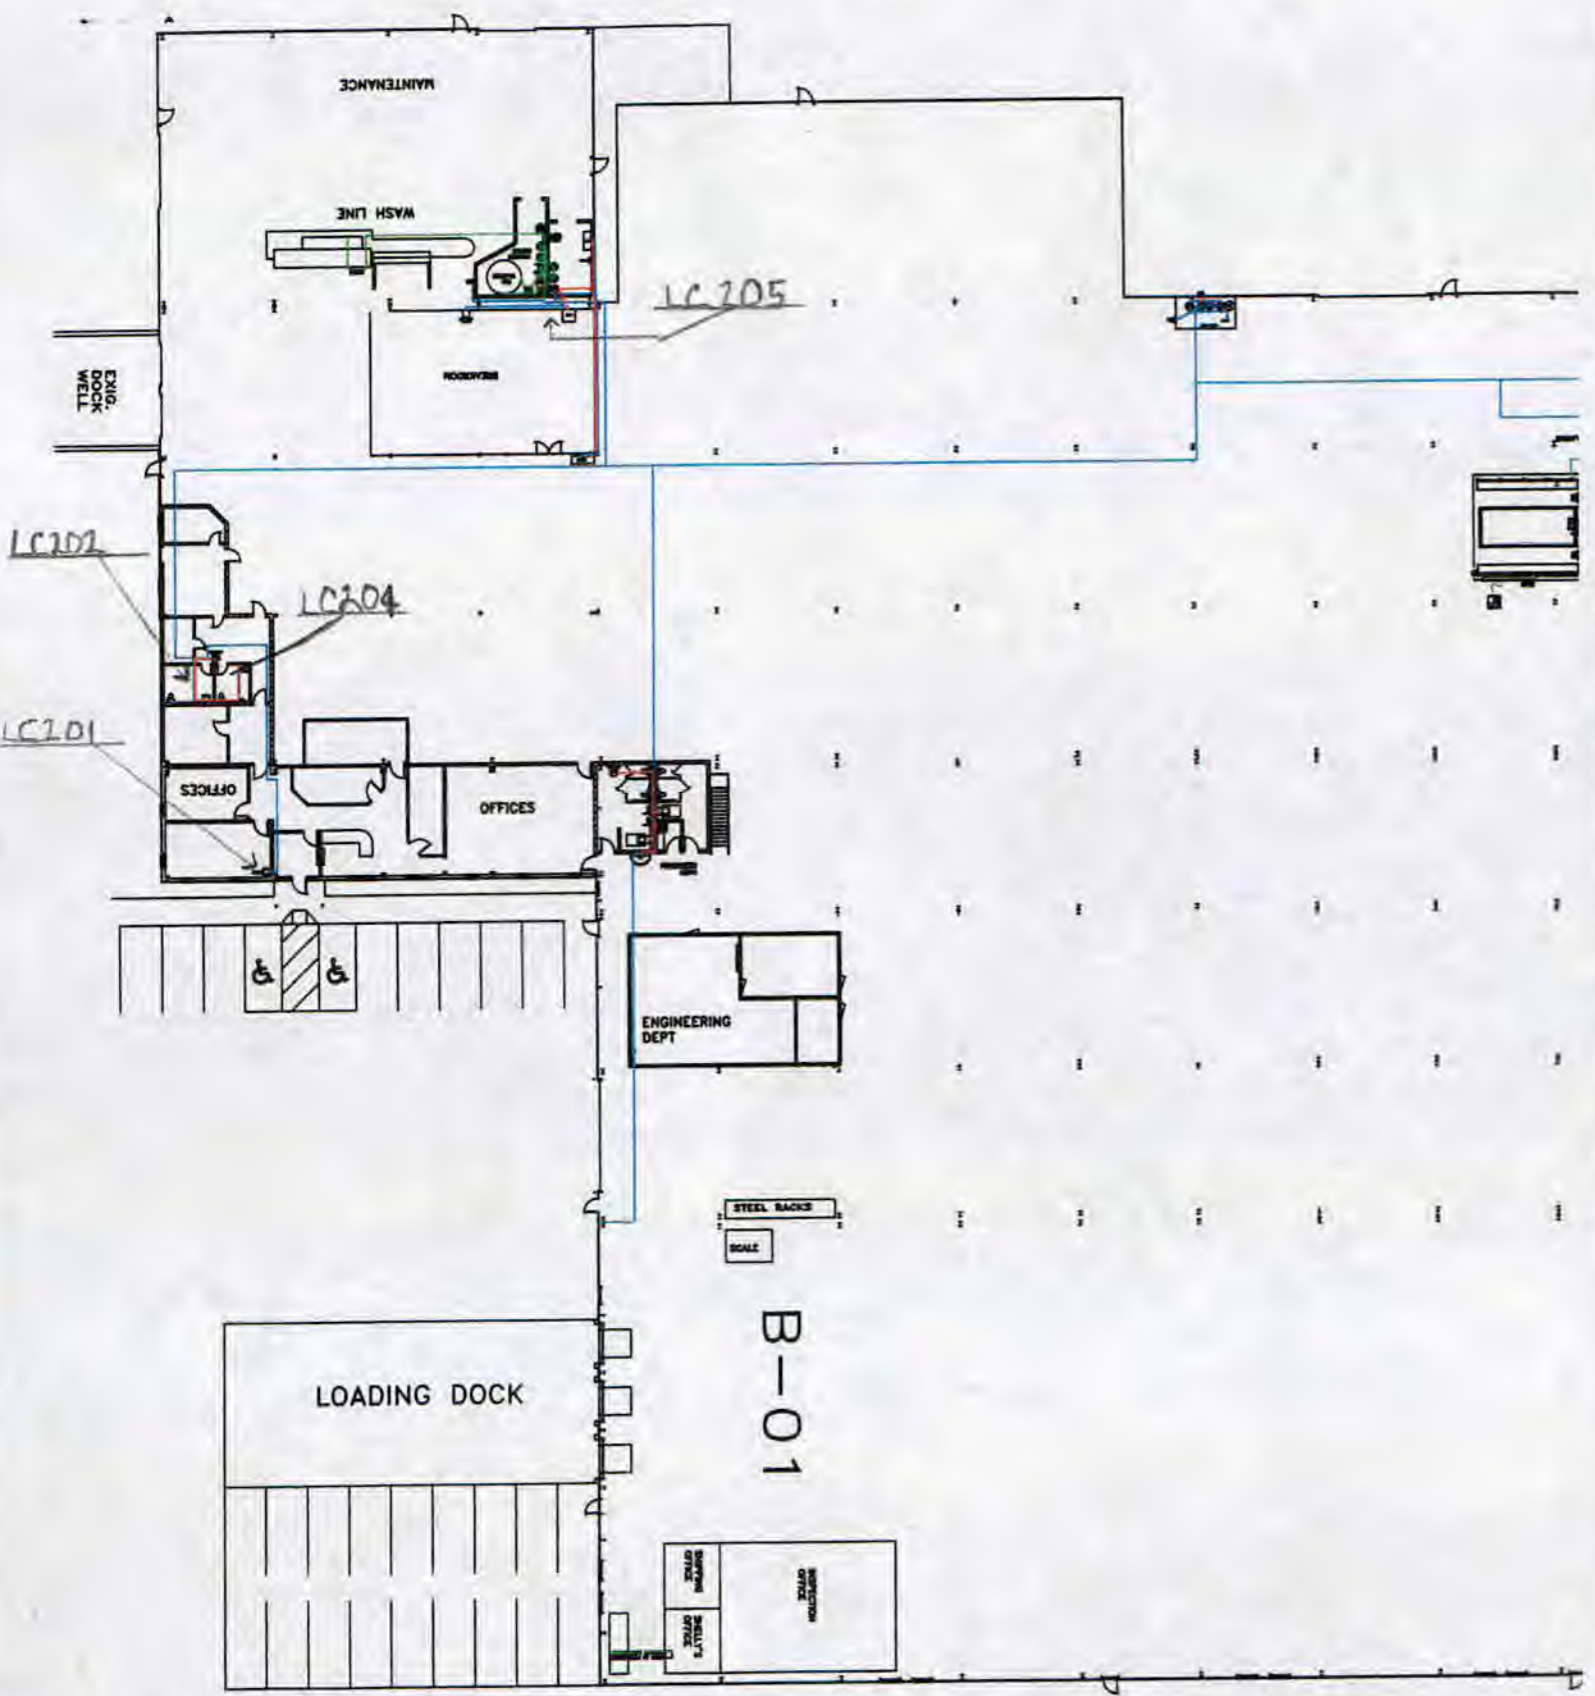



RECEIVED
 FEB 16 2017
 OHIO E.P.A.
 N.W.D.O.

Spreadsheet for lead and copper sample sites

* = Required field

Please return to Michael.deal@epa.ohio.gov with subject "Lead and Copper"

PWS ID*	PWS Name*	SMP ID*	Tier Site*	Street Address*	City*	State*	Zip*	Tap Location*	Resident Name*
OH6943312	Verhoff Machine a	LC201	Other	7300 Rd.18	Continental	OH	45831	Conference Room	Joe Verhoff
OH6943312	Verhoff Machine a	LC202	Other	7300 Rd.18	Continental	OH	45831	Office RR sink	Joe Verhoff
OH6943312	Verhoff Machine a	LC203	Other	7300 Rd.18	Continental	OH	45831	ladies RR new sho	Joe Verhoff
OH6943312	Verhoff Machine a	LC204	Other	7300 Rd.18	Continental	OH	45831	mens RR sink	Joe Verhoff
OH6943312	Verhoff Machine a	LC205	Other	7300 Rd.18	Continental	OH	45831	break room sink	Joe Verhoff
		LC206							
		LC207							
