

RE: Oak Haven Residential Care
Report
Drinking Water Program
Putnam County
PWS ID: OH6901012

Oak Haven Residential Care

152 N. Main St.

Cloverdale, OH.45827

419-488-2310

PWS # OH6901012

RECEIVED

FEB 16 2017

**OHIO E.P.A.
N.W.D.O.**

- Previously Paradise Oaks built appx. 1968 as a nursing home facility.
- Was purchased by Trilogy health care appx in the late 90's to 20's
- A private individual owned it appx. 3 years after that
- The current owner has owned the building since around 2013

The past owners have slowly changed all of the piping in the facility from copper piping to pvc piping.


All of the fixtures are of newer modern no lead brass fixtures.

There was an instance in 2016 where there was a lead exceedance the piping and the old fixtures were removed and replaced with newer fixtures and since there has been no problems.

The wells that supply the facility have plastic lines from the well pump to the treatment system in the building.

The treatment system consists of Cl_2 injection to oxidize the H_2S in two 270 gal. retention tanks.

The water then passes through the carbon filter through two softeners. There is then Cl_2 added back to the system for disinfection.

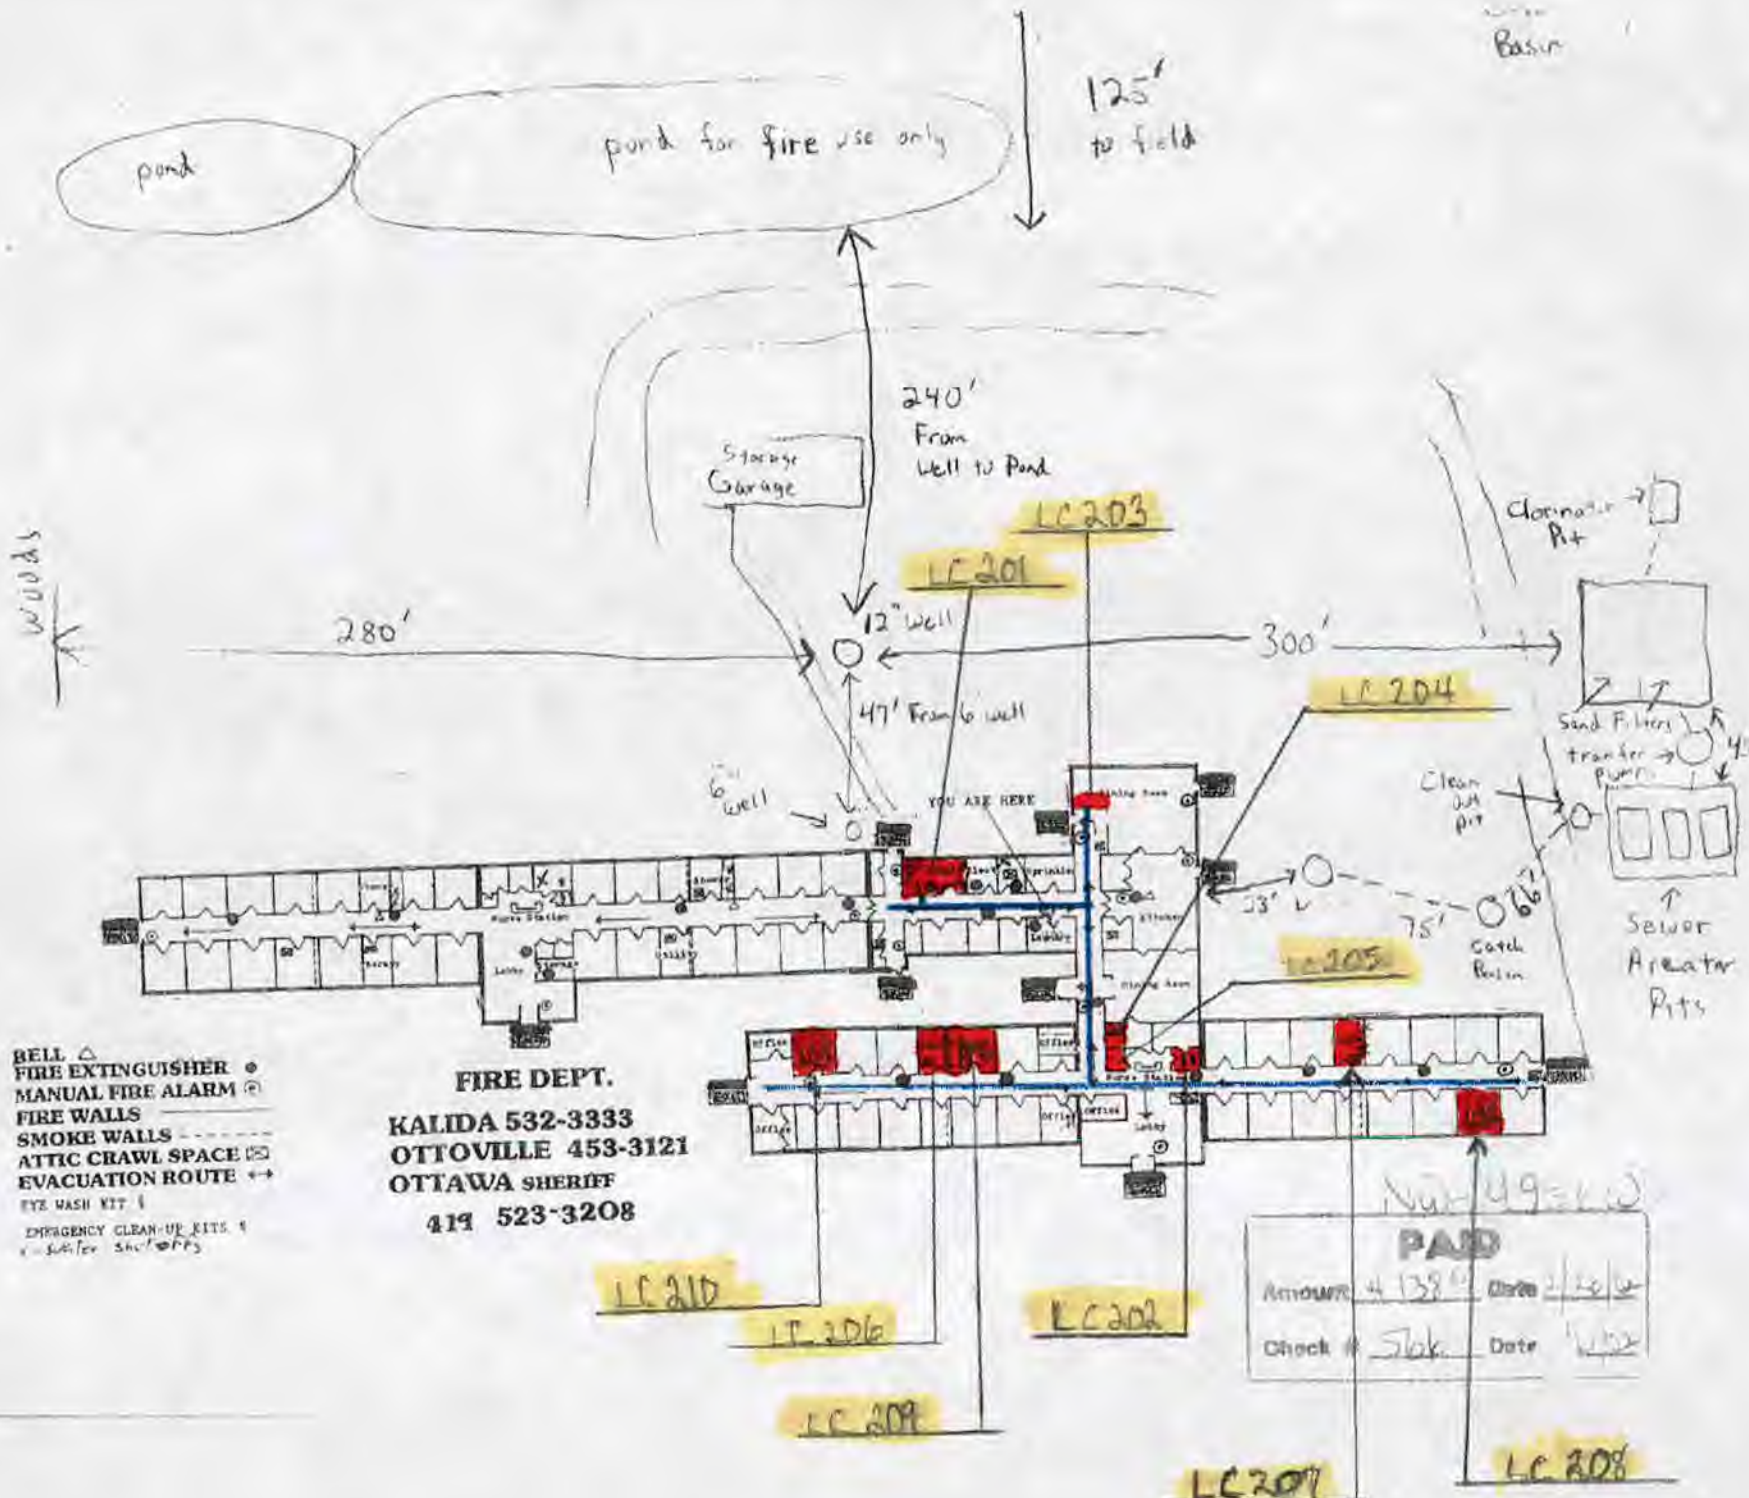

- BELL Δ
- FIRE EXTINGUISHER \circ
- MANUAL FIRE ALARM \oplus
- FIRE WALLS
- SMOKE WALLS
- ATTIC CRAWL SPACE \square
- EVACUATION ROUTE \leftrightarrow
- EYE WASH KIT $\{$
- EMERGENCY CLEAN-UP KITS $\{$
- WATER SHUT OFF $\{$

PAID
 Amount \$ 138.00 Date 1/15/06
 Check # 566 Date 1/15/06