


Bainbrook-PWSID OH 2803112 9 Laurel Springs - PWSID OH 2804112
 8250 Bainbrook Dr. 8005 Bainbrook Dr.
 Chagrin Falls OH 44024 Chagrin Falls OH 44024
 Contact Tim Rachek 440.591.0362

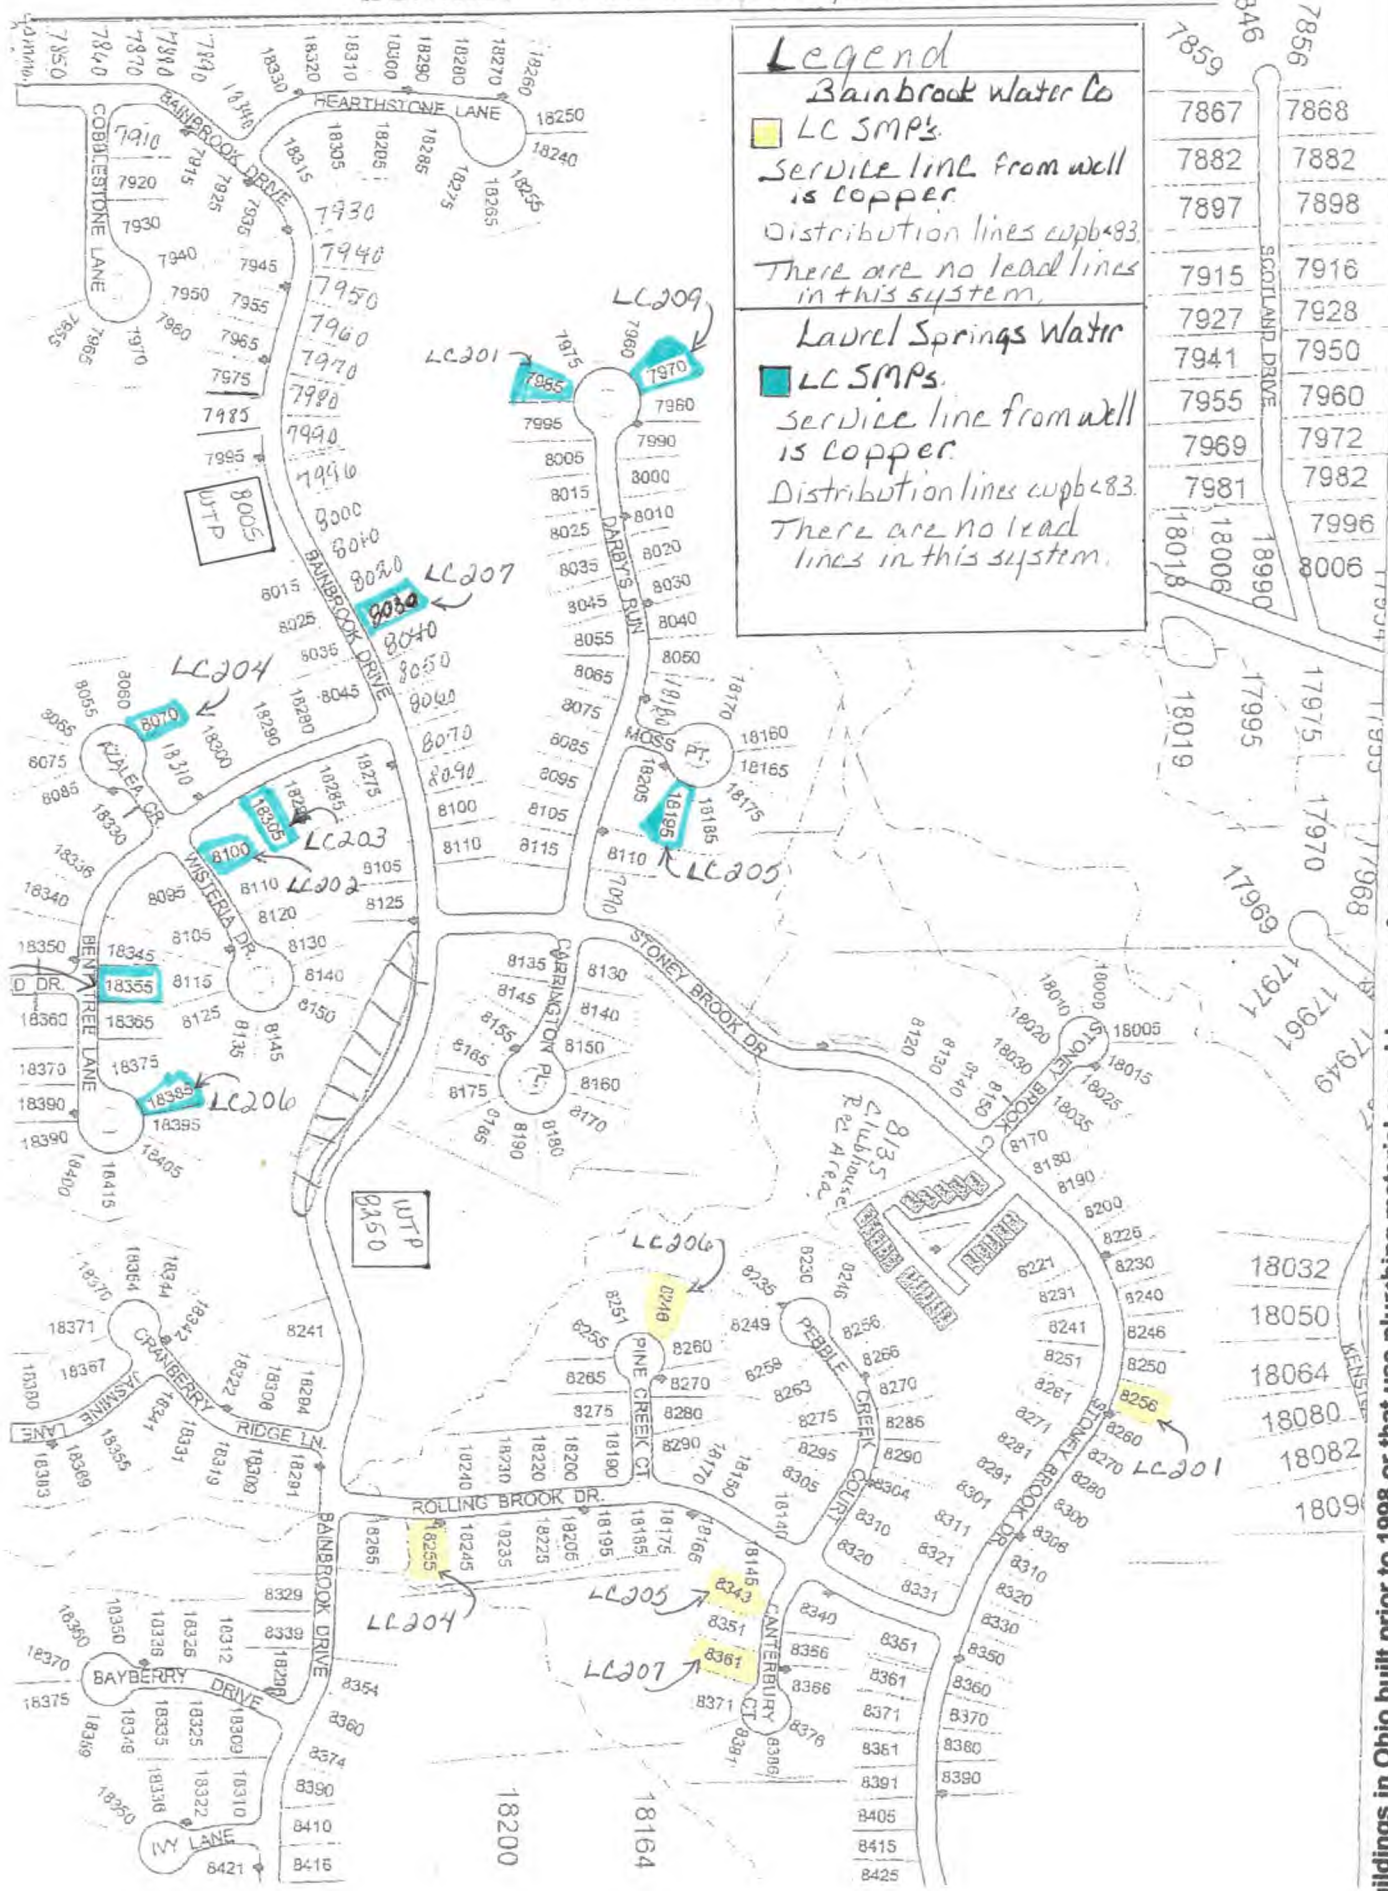

Legend

Bainbrook Water Co
 ■ LC SMPs.
 Service line from well is copper.
 Distribution lines cwp < 83.
 There are no lead lines in this system.

Laurel Springs Water
 ■ LC SMPs.
 Service line from well is copper.
 Distribution lines cwp < 83.
 There are no lead lines in this system.

7859	7856
7867	7868
7882	7882
7897	7898
7915	7916
7927	7928
7941	7950
7955	7960
7969	7972
7981	7982
18018	7996
18006	8006
18990	

"Buildings in Ohio built prior to 1998 or that use plumbing material or solder manufactured before 1998 may have materials with greater than 8% lead and are at a higher risk of contributing lead to the drinking water than materials manufactured after 1998. In addition, building built and plumbing material manufactured after 2014 were required to have less than 0.25% lead by weight and have the lowest risk for contributing lead to the drinking water. It should be noted however that, although prohibited, some use of leaded solder or leaded components may have occurred after the prohibitions became effective."