

RE: Lyons Village
Report
Drinking Water Program
Fulton County
PWS ID: OH2600603


Village of Lyons, OH

Water Distribution Map / LCR MAPPING

2017

RECEIVED
 FEB 21 2017
 OHIO E.P.A.
 N.W.D.O.

N
 4
 Not To Scale

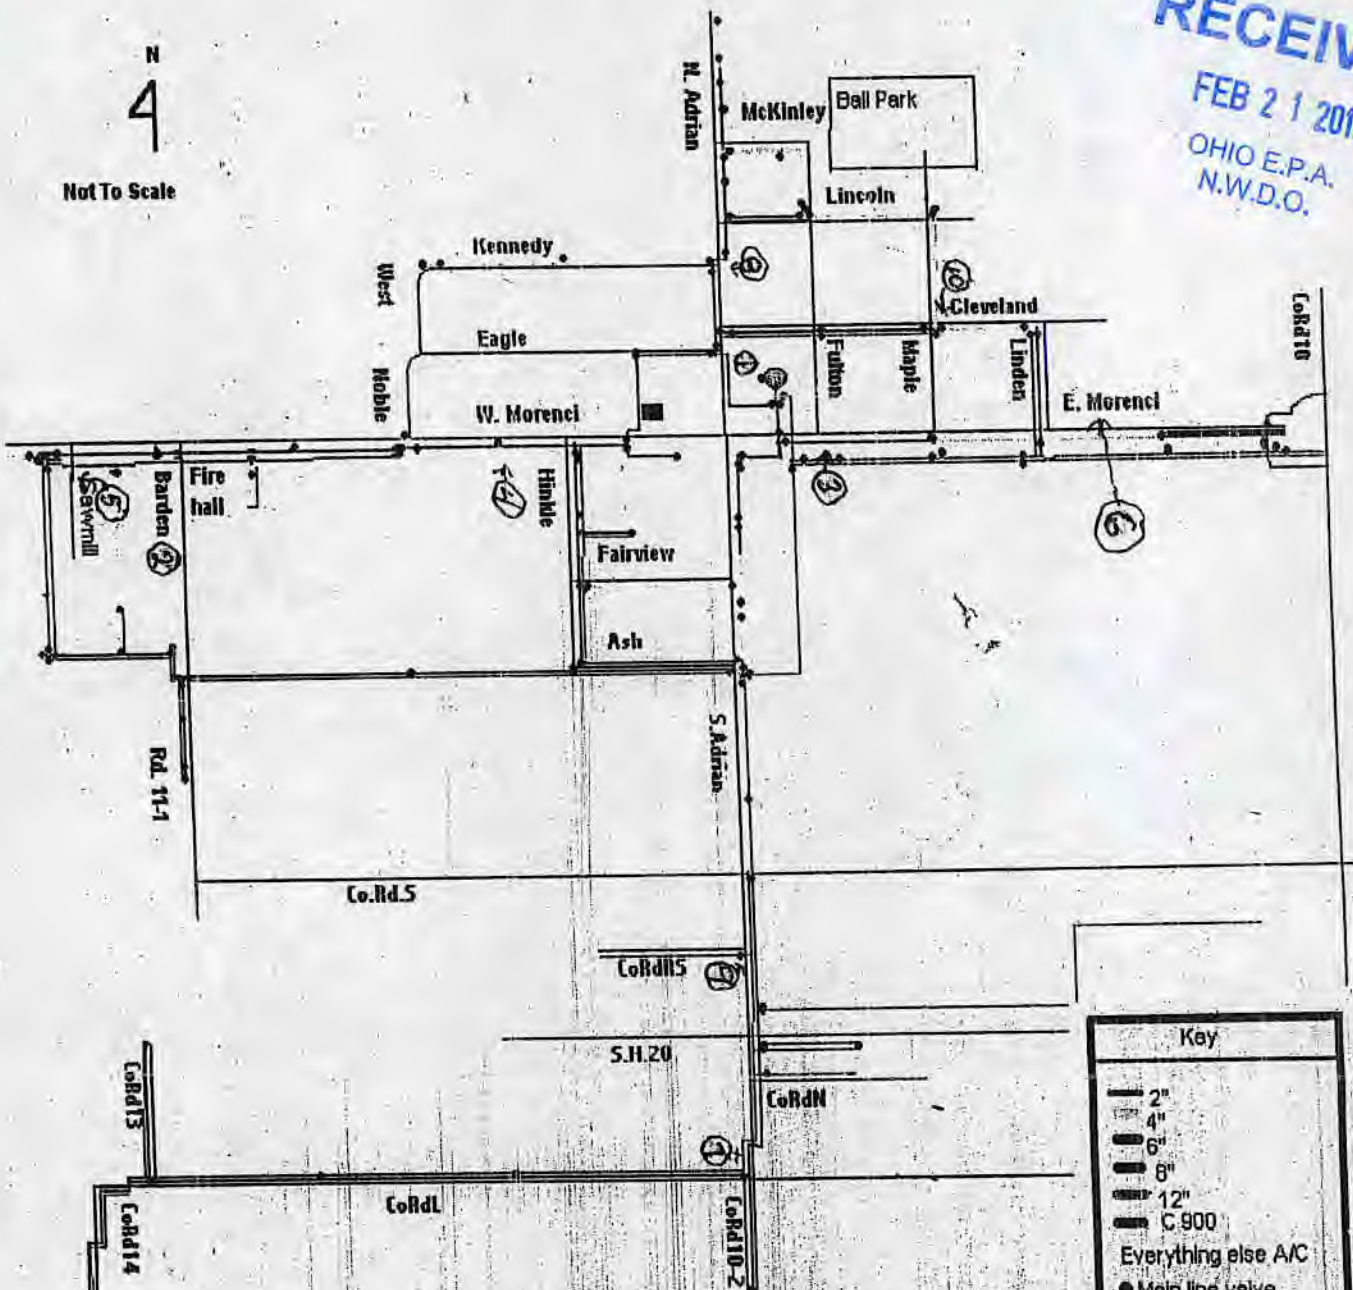

Key	
	2"
	4"
	6"
	8"
	12"
	C 900
Everything else A/C	
	Main line valve
	Fire Hydrant
	Village Hall

SMP ID*	Tier Site*	Street Address*
LC201	Tier 1	122 N. Adrain St.
LC202	Tier 1	108 Barden St.
LC203	Tier 1	204 E. Morenci St.
LC204	Tier 1	305 W. Morenci St.
LC205	Tier 1	505 W. Morenci St.
LC206	Tier 1	417 E. Morenci St.
LC207	Tier 1	12065 co. rd. 10-2
LC208	Tier 1	310 N. Adrain St.
LC209	Tier 1	14441 co. rd. 10-3
LC210	Tier 1	381 Cleveland St.

Buildings in Ohio built prior to 1998 or that use plumbing material or solder manufactured before 1998 may have materials with greater than 8% lead and are at a higher risk of contributing lead to the drinking water than materials manufactured after 1998. In addition, buildings built and plumbing materials manufactured after 2014 were required to have less than 0.25% lead by weight and have the lowest risk for contributing lead to the drinking water. It should be noted however that, although prohibited, some use of leaded solder or leaded components may have occurred after the prohibitions became effective.

- The Village of Lyons, OH has no known lead lines in the distribution system.
- Distribution System
- 1948 Water Tower and most of distribution System. (AC)
 - 1983 Pump House on road 14 to the corner of 10-2 and S. (C900)
 - 2006 Ash St. to road 11-1. (C900)
 - 2007 Sawmill St. (C900)
 - 2010 Linden St. (C900)
 - 2012 Ash St. to 11-1 (C900)