



- LEGEND
- LEAD
 - NON-LEAD
 - UNKNOWN


GRANDVIEW MHP B

SCALE : SEE BAR SCALE

NOTES:

1. ALL PIPING IN PWS IS MADE OF PLASTIC.
2. THERE ARE NO LEAD SERVICE LINES OR MAINS.
3. MOST OF THE HOMES ARE 1998 OR OLDER.
4. DUE HOME MODEL AGES, ALL OR MOST HOMES LIKELY CONTAIN LEAD SOLDER (WITHIN THE HOMES). THAT IS WHY MAP IS HIGHLIGHTED IN YELLOW TO INDICATE THAT HOMES LIKELY CONTAIN LEAD SOLDER.
5. BUILDINGS IN OHIO BUILT PRIOR TO 1998 OR THAT USE PLUMBING MATERIAL OR SOLDER MANUFACTURED BEFORE 1998 MAY HAVE MATERIALS WITH GREATER THAN 8% LEAD AND ARE AT A HIGHER RISK OF CONTRIBUTING LEAD TO THE DRINKING WATER THAN MATERIALS MANUFACTURED AFTER 1998. IN ADDITION, BUILDINGS BUILT AND PLUMBING MATERIALS MANUFACTURED AFTER 2014 WERE REQUIRED TO HAVE LESS THAN 0.25% LEAD BY WEIGHT AND HAVE THE LOWEST RISK FOR CONTRIBUTING LEAD TO THE DRINKING WATER. IT SHOULD BE NOTED HOWEVER THAT, ALTHOUGH PROHIBITED, SOME USE OF LEADED SOLDER OR LEADED COMPONENTS MAY HAVE OCCURRED AFTER THE PROHIBITIONS BECAME EFFECTIVE.

GRANDVIEW MHP B
 8750 COLUMBUS RD.
 MT. VERNON, OHIO 43050
 PHONE # (740) 397-5692
 PWS ID # OH4202212

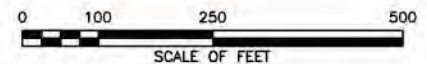

NORTH

