
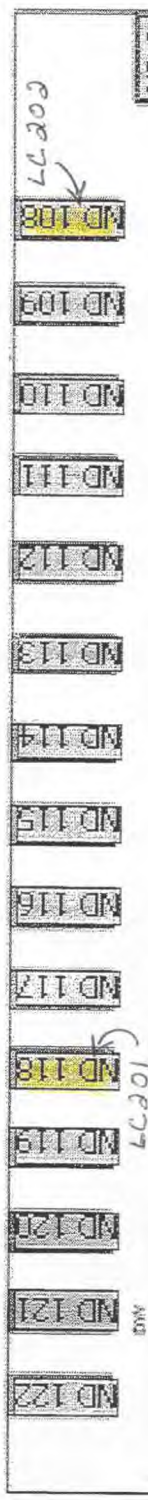


well #

New Dover MHP
11480 St. Rt. 36, Marietta, OH 43040

Pub ID OH8000012
Contact Tammy Scott 937.707.7724

S P R I N G D R A L E B R O A D

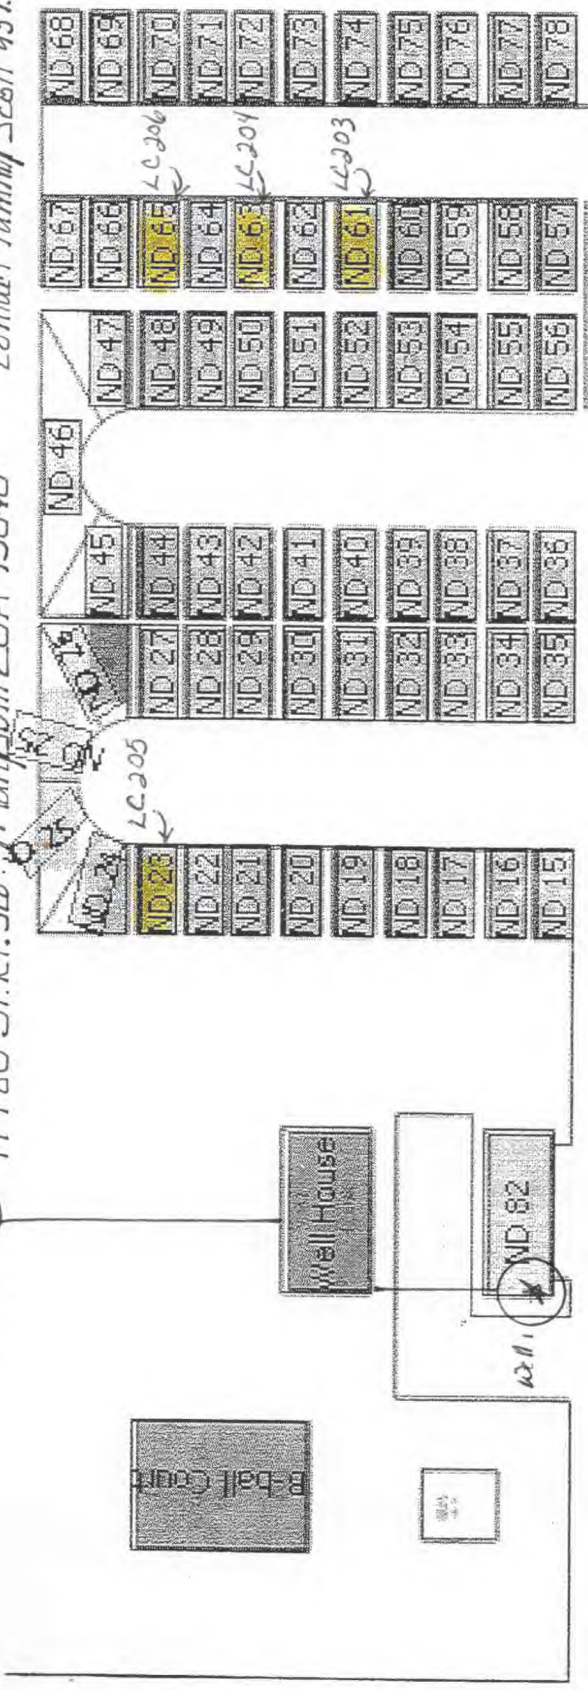

"Buildings in Ohio built prior to 1998 or that use plumbing material or solder manufactured before 1998 may have materials with greater than 8% lead and are at a higher risk of contributing lead to the drinking water than materials manufactured after 1998. In addition, building built and plumbing material manufactured after 2014 were required to have less than 0.25% lead by weight and have the lowest risk for contributing lead to the drinking water. It should be noted however that, although prohibited, some use of leaded solder or leaded components may have occurred after the prohibitions became effective."


Water lines are copper > 82.
There are no lead lines in this system.

