


RE: Tri-County Block and Brick  
Report  
Drinking Water Program  
Fulton County  
PWS ID: OH2637912


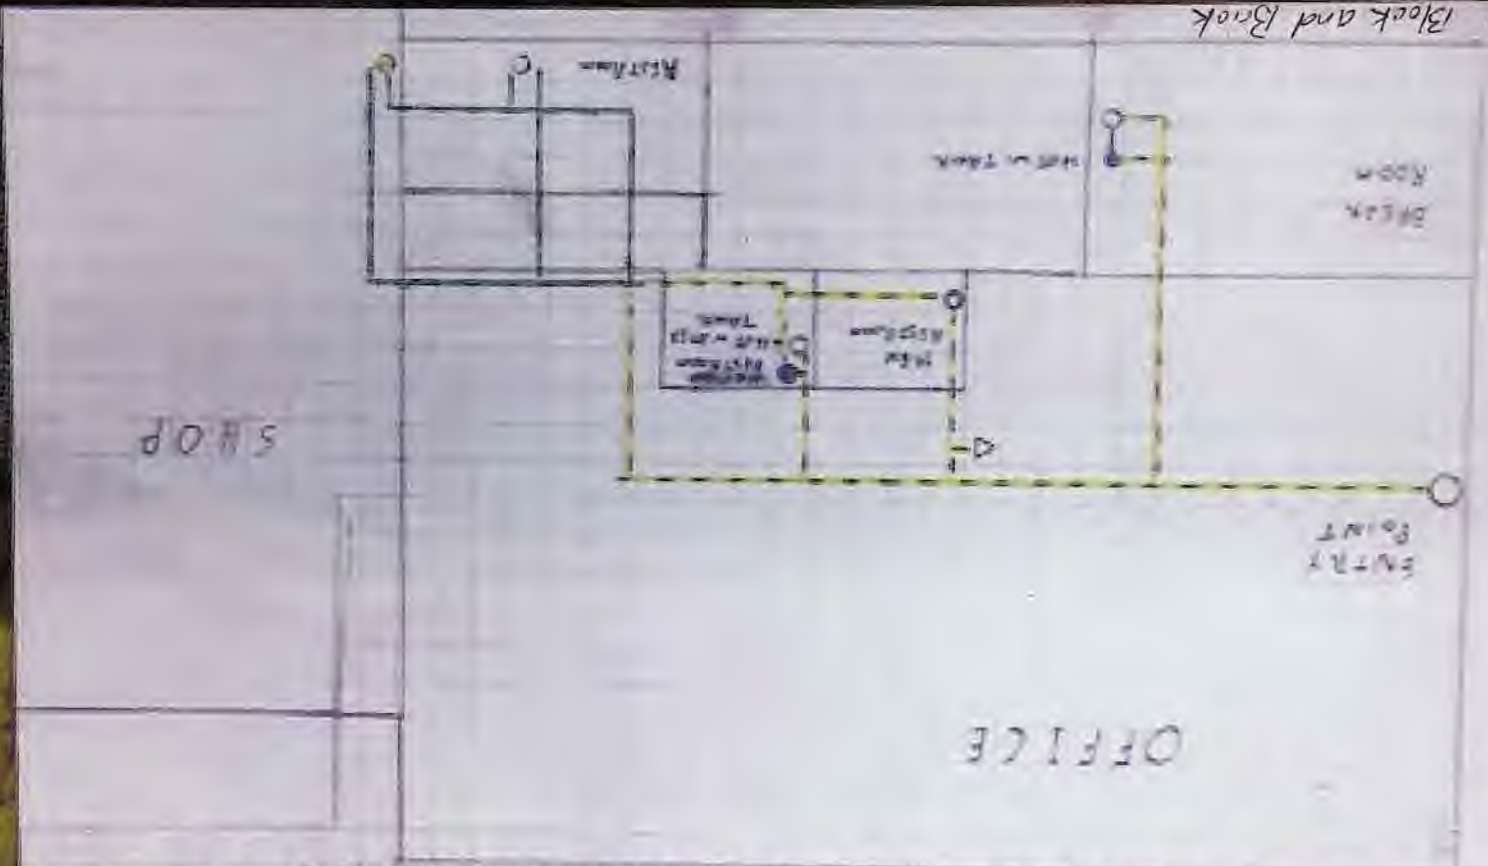


DDAGW - NWDO

FEB 22 2017

RECEIVED

- LEAD
- NON-LEAD
- NO INFORMATION
- HOT WATER TANK
- LEAD/NO INFORMATION
- WATER FOUNTAIN

NORTH






# Airport Hwy

RECEIVED

FEB 22 2017

DDAGW - NWDO



-  LEAD
-  NON-LEAD
-  HOT WATER TANK
-  NO INFORMATION
-  SINK

TRI COUNTY BLOCK & BRICK INC TIM COOLEY 1428 US 20A SWANSEA ONTO 91558  
WELL

