



RE: S and K Products Company  
Report  
Drinking Water Program  
Mercer County  
PWS ID: OH5440312

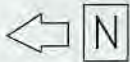

S&K PRODUCTS CO.  
PWS ID #5440312  
Service Line Mapping

Building address: 4540 US Rte 127  
Cclina, Ohio 45022  
Tel: 419-268-2244

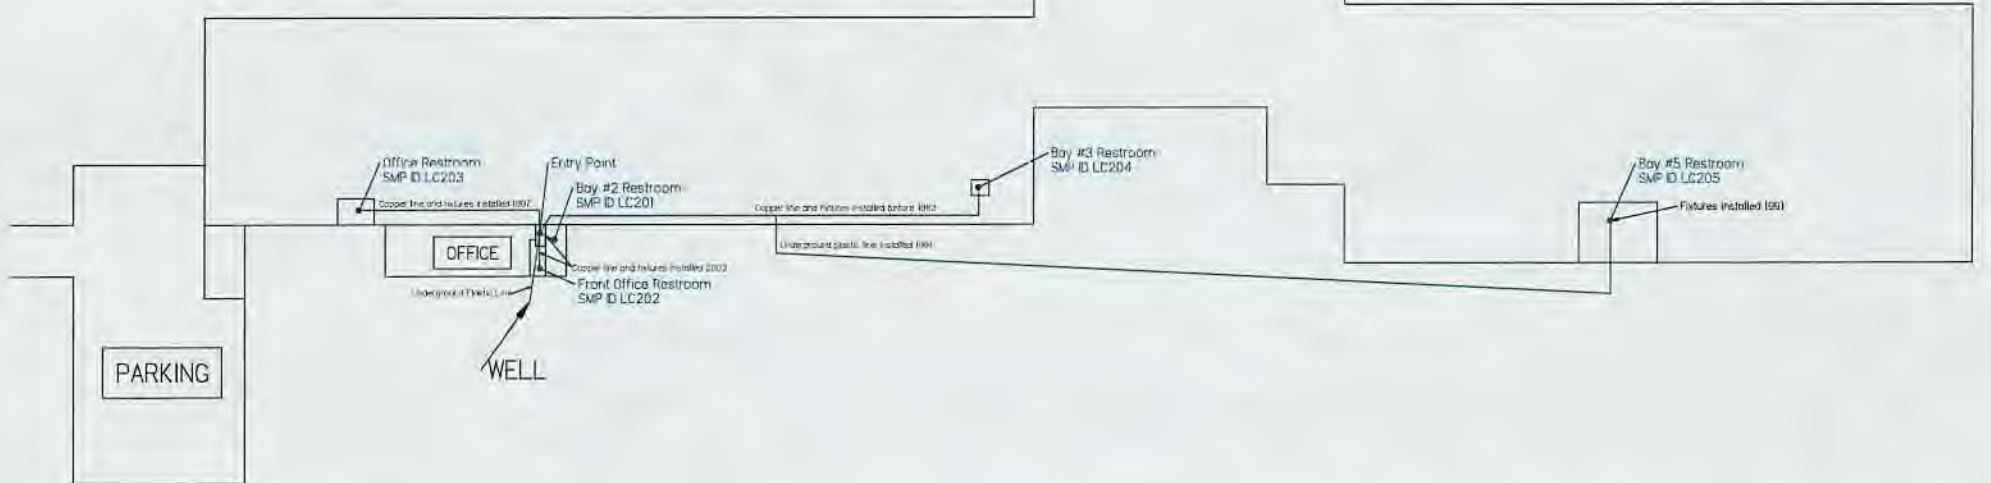

US RTE 127

**RECEIVED**

JAN 30 2017

DDAGW - NWDO