

AK Steel Corporation

COSHOCTON WORKS
17400 STATE ROUTE 16
COSHOCTON, OHIO 43812

TELEPHONE 740.829.2341

2017 FEB 27 AM 10:56

February 24, 2017

Ms. Michael Carper
OEPA – DDAGW
2195 Front Street
Logan, OH 43138

To Whom It May Concern:

Enclosed is the 2017 HB 512 Drawing and Tier 1 sites for collecting Lead and Copper Samples for AK Steel Corporation Coshocton Works.




Please contact me with any questions regarding this report. I can be contacted at the above address or by telephone at (740) 829-4315.

Sincerely,

A handwritten signature in black ink that reads 'Kelly Jo Long'.

Kelly Jo Long
Environmental Engineer
AK Steel - Coshocton Works

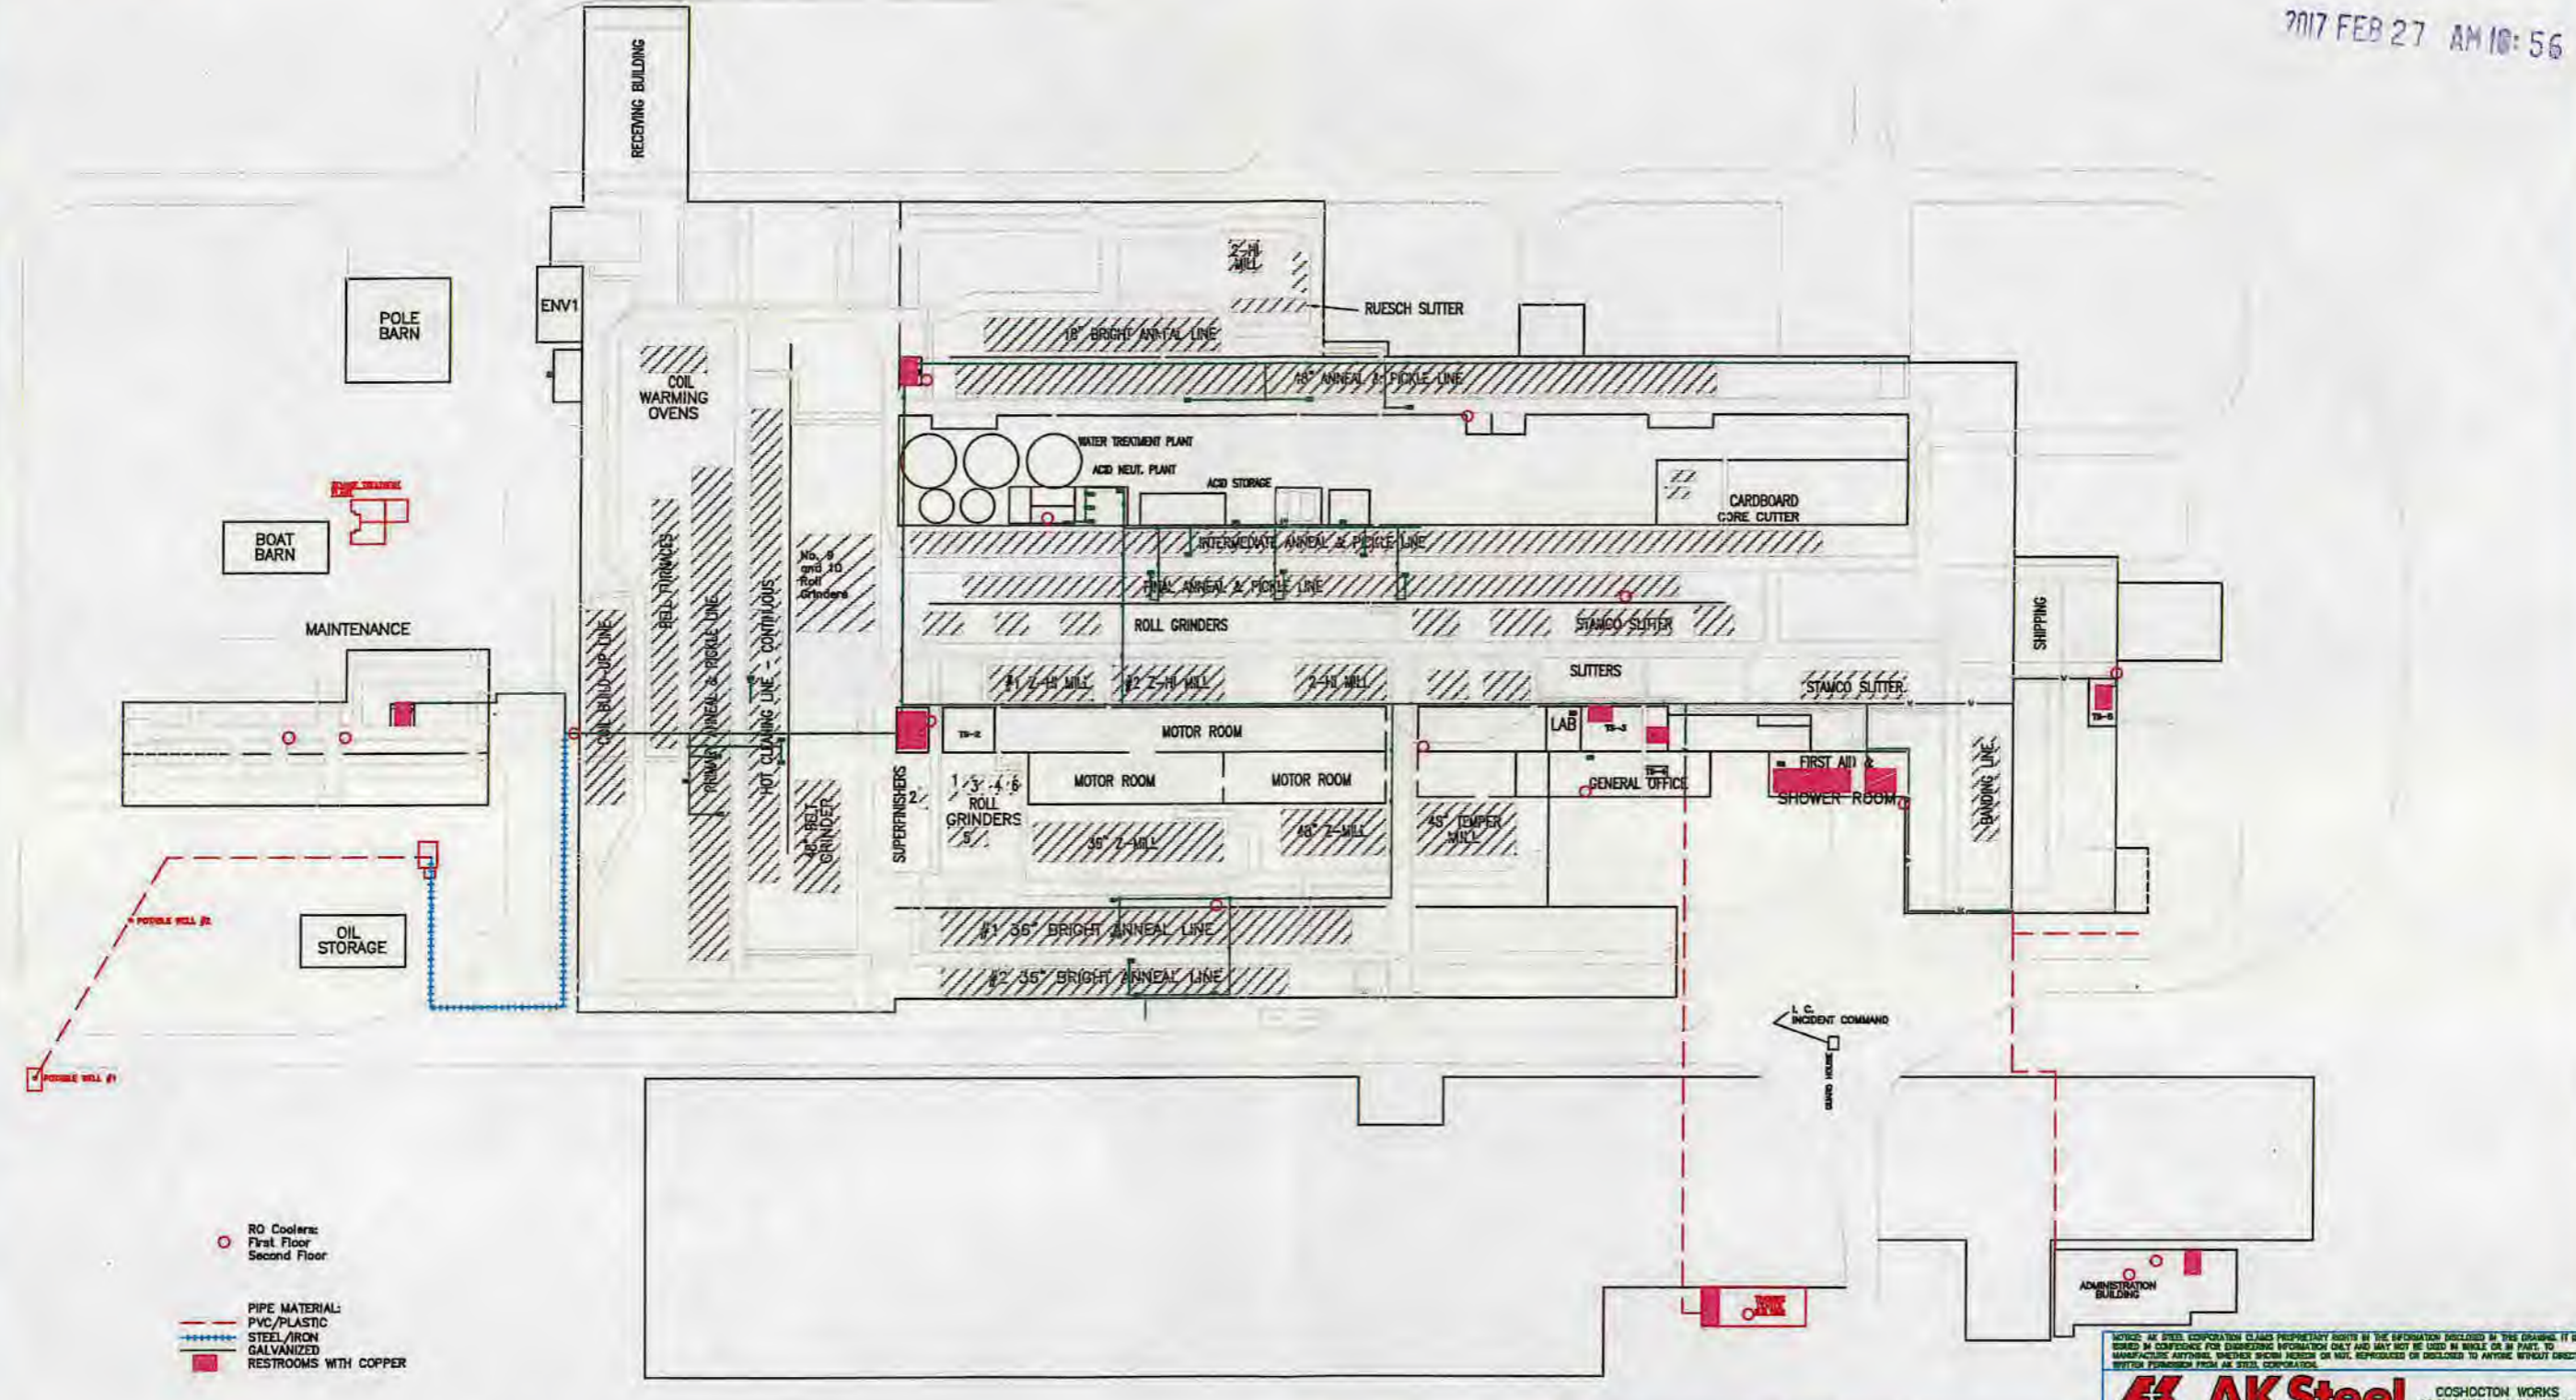

RO Coolers:
First Floor
Second Floor

PIPE MATERIAL:
PVC/PLASTIC
STEEL/IRON
GALVANIZED
RESTROOMS WITH COPPER

- RESTROOM FACILITY DESCRIPTIONS**
- R1: SHIPPING AREA; MEN, WOMEN, ADA APPROVED
 - R2: PLANT SHOWERS; MEN, WOMEN
 - R3: MAIN MILL AISLE; MEN, WOMEN
 - R4: 24" BLDG. AREA; MEN, WOMEN
 - R5: 48" BLDG. AREA; MEN, WOMEN
 - R6: MAINTENANCE SHOP; MEN
 - R7: OFFICE AREA; MEN, ADA APPROVED
 - R8: OFFICE AREA; WOMEN, ADA APPROVED
 - R9: UPPER OFFICE AREA; WOMEN
 - R10: UPPER OFFICE AREA; MEN
 - R11: MAINTENANCE SHOP; UNISEX, ADA APPROVED

**EQUIPMENT LAYOUT
COSHOCTON PLANT**

REV	DATE	BY	CHK	REMARKS

EQUIP. NO.	BLDG. NO.	REV.	DATE	NAME	DESCRIPTION


NOTICE: AK STEEL CORPORATION CLAIMS PROPRIETARY RIGHTS IN THE INFORMATION INCLUDED IN THIS DRAWING. IT IS ISSUED IN CONFIDENCE FOR ENGINEERING INFORMATION ONLY AND MAY NOT BE USED IN WHOLE OR IN PART, TO MANUFACTURE ANYTHING, UNLESS SPECIFIC NOTICE OR A/C. REPRODUCED OR DISCLOSED TO ANYONE WITHOUT WRITTEN PERMISSION FROM AK STEEL CORPORATION.

AK Steel COSHOCTON WORKS
COSHOCTON, OHIO 43812

DEPT.	COSHOCTON WORKS
UNIT	PLANT LAYOUT
SUBJECT	EGRESS & AISLE LAYOUT
SECTOR	DOORS, SHELTERS & EYE WASH LOCATIONS

MC. GDS
 SCALE 1"=75'
 DATE 07/21/05
 CHECKED FOR SAFETY DEVICES

DWG. No.	REFERENCE	REV.	DESCRIPTION
903-0203	GENERAL LAYOUT		

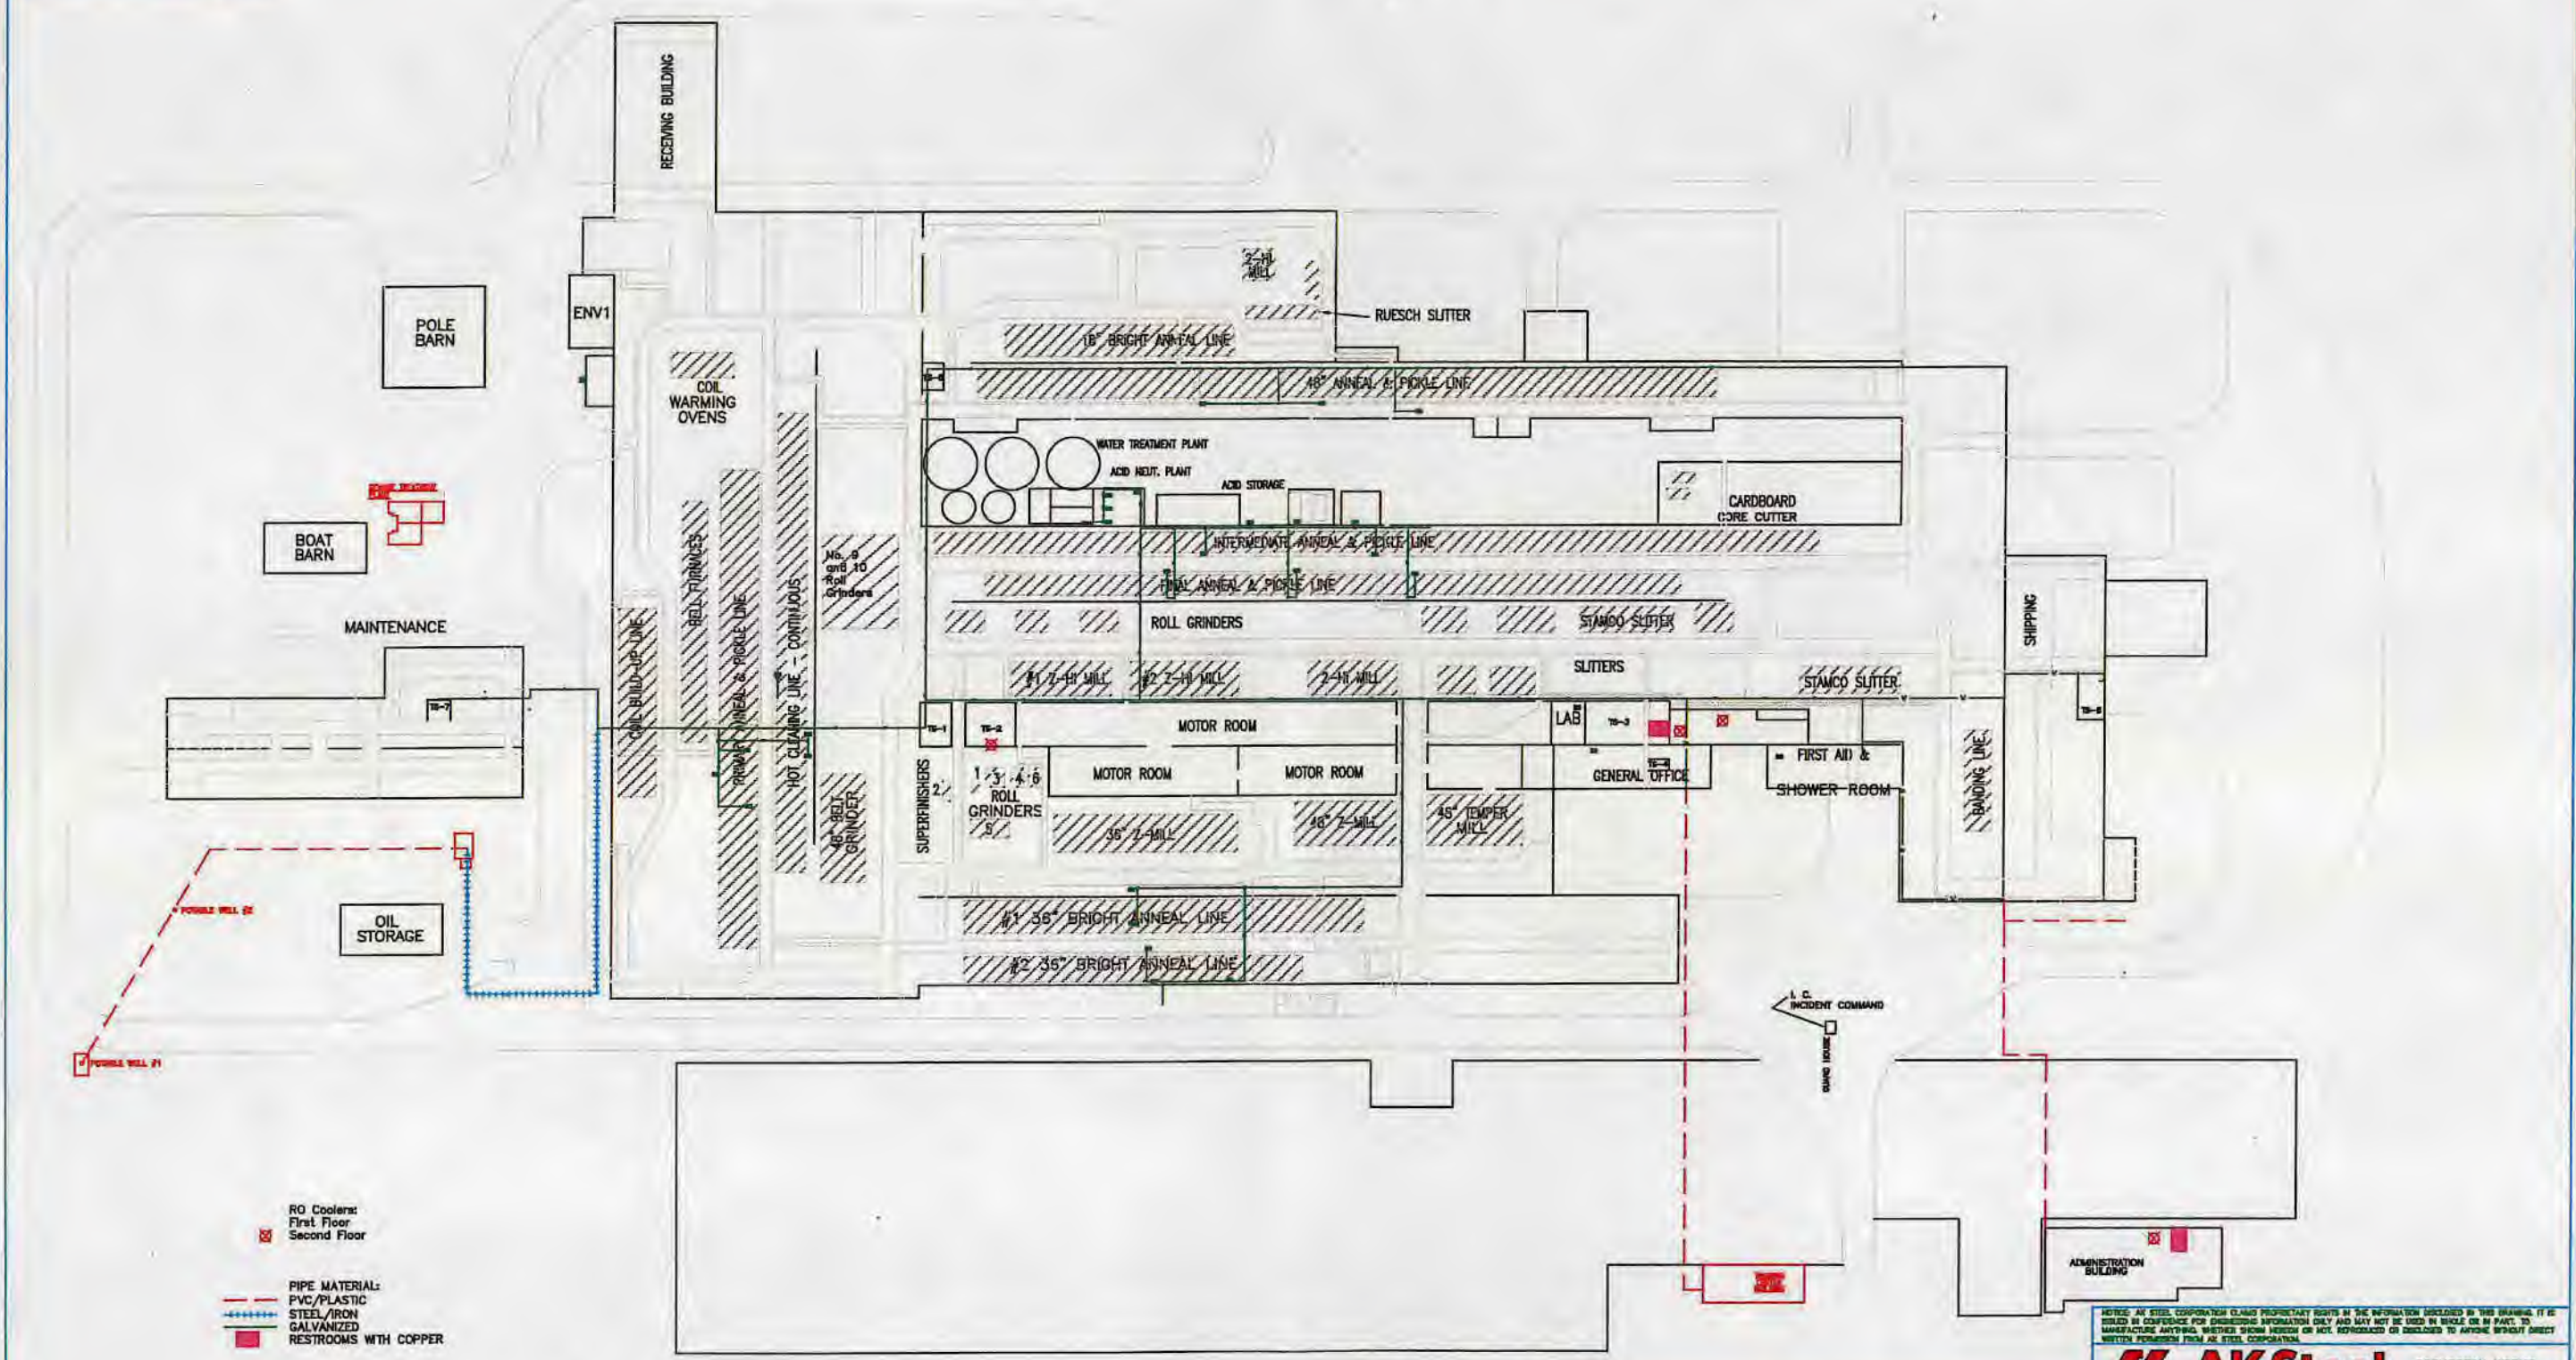

RO Coolers:
 First Floor
 Second Floor

PIPE MATERIAL:
 - - - - - PVC/PLASTIC
 - - - - - STEEL/IRON
 - - - - - GALVANIZED
 ■ RESTROOMS WITH COPPER

RESTROOM FACILITY DESCRIPTIONS

- R1: SHIPPING AREA; MEN, WOMEN, ADA APPROVED
- R2: PLANT SHOWERS; MEN, WOMEN
- R3: MAIN MILL AISLE; MEN, WOMEN
- R4: 24" BLDG. AREA; MEN, WOMEN
- R5: 48" BLDG. AREA; MEN, WOMEN
- R6: MAINTENANCE SHOP; MEN
- R7: OFFICE AREA; MEN, ADA APPROVED
- R8: OFFICE AREA; WOMEN, ADA APPROVED
- R9: UPPER OFFICE AREA; WOMEN
- R10: UPPER OFFICE AREA; MEN
- R11: MAINTENANCE SHOP; UNISEX, ADA APPROVED

**EQUIPMENT LAYOUT
 COSHOCTON PLANT**

DWG. No.	REFERENCE	REV. DESCRIPTION
903-0203	GENERAL LAYOUT	

<table border="1" style="width: 100%;"> <thead> <tr> <th>REV.</th> <th>DATE</th> <th>BY</th> <th>CHK</th> <th>REMARKS</th> </tr> </thead> <tbody> <tr><td> </td><td> </td><td> </td><td> </td><td> </td></tr> <tr><td> </td><td> </td><td> </td><td> </td><td> </td></tr> </tbody> </table>			REV.	DATE	BY	CHK	REMARKS											<table border="1" style="width: 100%;"> <thead> <tr> <th>EQUIP. NO.</th> <th>BLDG. NO.</th> </tr> </thead> <tbody> <tr><td> </td><td> </td></tr> <tr><td> </td><td> </td></tr> <tr><td> </td><td> </td></tr> <tr><td> </td><td> </td></tr> <tr><td> </td><td> </td></tr> <tr><td> </td><td> </td></tr> <tr><td> </td><td> </td></tr> <tr><td> </td><td> </td></tr> <tr><td> </td><td> </td></tr> <tr><td> </td><td> </td></tr> <tr><td> </td><td> </td></tr> </tbody> </table>		EQUIP. NO.	BLDG. NO.																						
			REV.	DATE	BY	CHK	REMARKS																																				
EQUIP. NO.	BLDG. NO.	
<p>CAD FILENAME: PLANT PLOT DATE: 07/20/05 DO NOT SCALE THIS DRAWING</p>	

AK Steel
 COSHOCTON WORKS
 COSHOCTON, OHIO 43812

DEPT. COSHOCTON WORKS	
TITL. PLANT LAYOUT	
SUBJECT. EGRESS & AISLE LAYOUT	
DESCR. DOORS, SHELTERS & EYE WASH LOCATIONS	
DR. GDS	
TR.	
CD.	SCALE 1"=75'
APP.	DATE 07/21/05

NOTICE: AK STEEL CORPORATION CLAIMS PROPRIETARY RIGHTS IN THE INFORMATION CONTAINED IN THIS DRAWING. IT IS INTENDED AS CONFIDENTIAL FOR ENGINEERING INFORMATION ONLY AND MAY NOT BE USED IN WHOLE OR IN PART TO MANUFACTURE ANYTHING, WHETHER SHOWN HEREIN OR NOT, REPRODUCED OR DISCLOSED TO ANYONE WITHOUT DIRECT WRITTEN PERMISSION FROM AK STEEL CORPORATION.