


# DEERSVILLE VILLAGE PWS PWS ID OH3400312

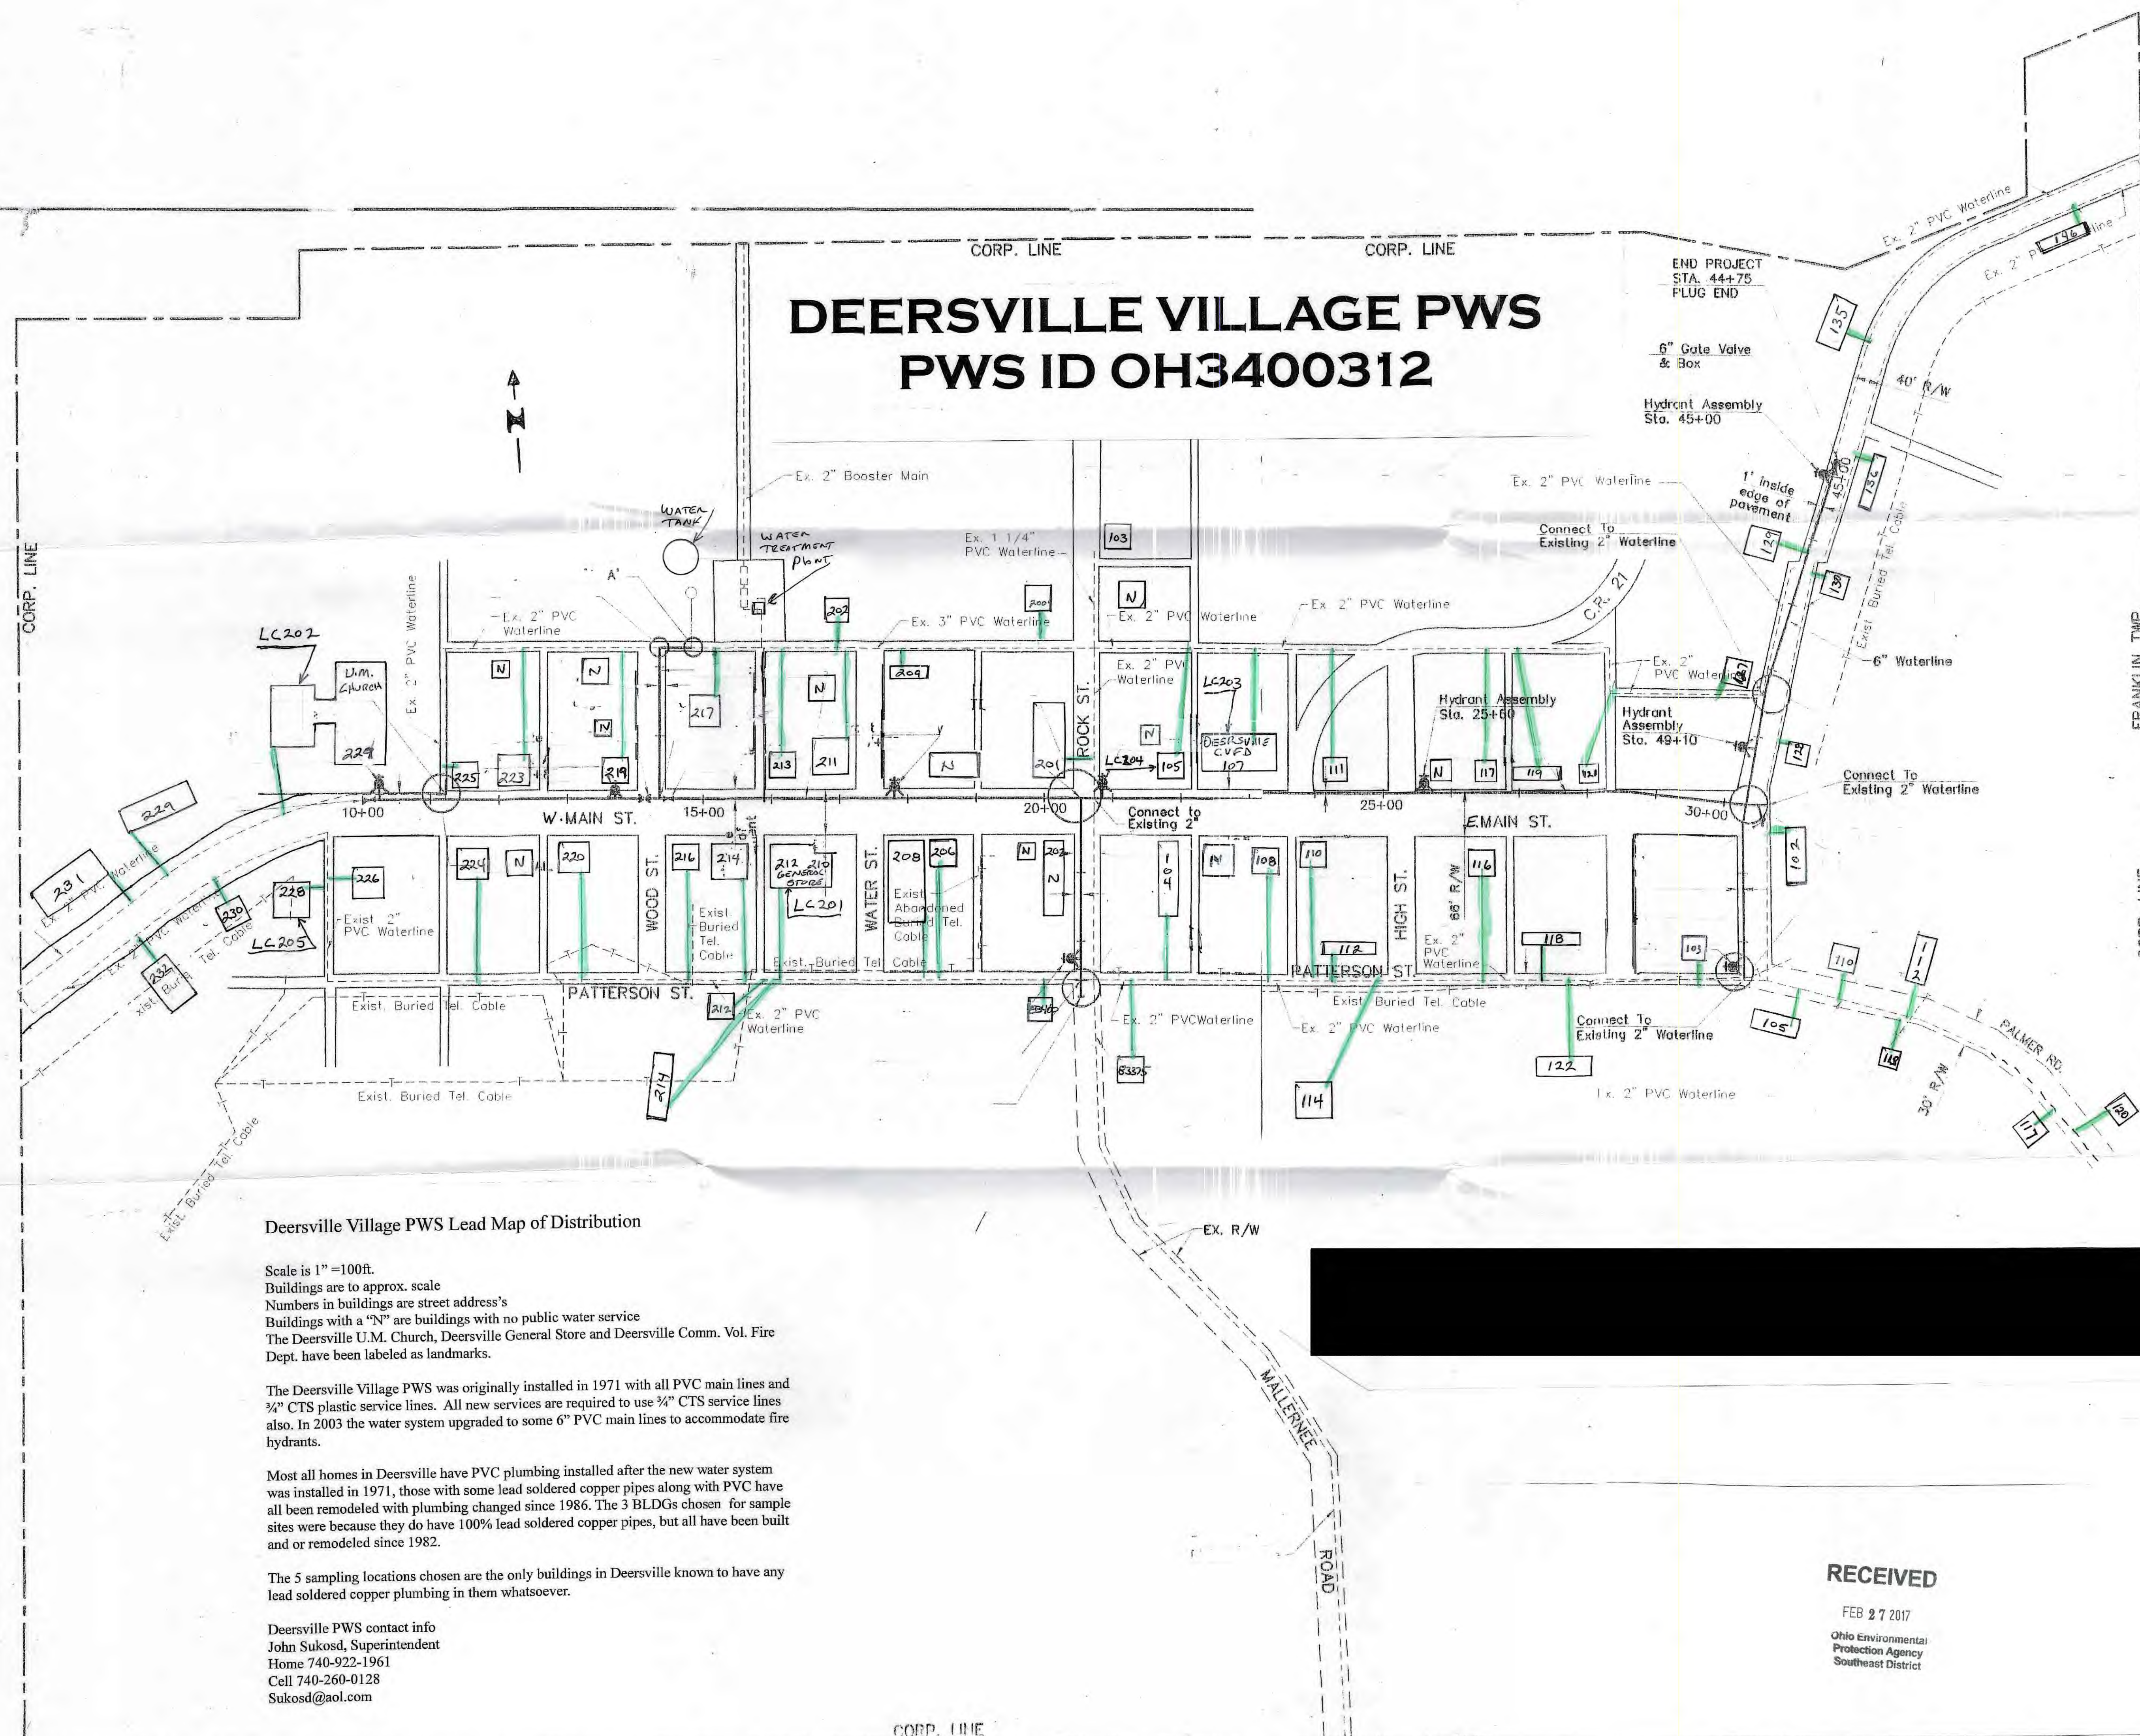

## Deersville Village PWS Lead Map of Distribution

Scale is 1" = 100ft.  
 Buildings are to approx. scale  
 Numbers in buildings are street address's  
 Buildings with a "N" are buildings with no public water service  
 The Deersville U.M. Church, Deersville General Store and Deersville Comm. Vol. Fire Dept. have been labeled as landmarks.

The Deersville Village PWS was originally installed in 1971 with all PVC main lines and 3/4" CTS plastic service lines. All new services are required to use 3/4" CTS service lines also. In 2003 the water system upgraded to some 6" PVC main lines to accommodate fire hydrants.

Most all homes in Deersville have PVC plumbing installed after the new water system was installed in 1971, those with some lead soldered copper pipes along with PVC have all been remodeled with plumbing changed since 1986. The 3 BLDGs chosen for sample sites were because they do have 100% lead soldered copper pipes, but all have been built and or remodeled since 1982.

The 5 sampling locations chosen are the only buildings in Deersville known to have any lead soldered copper plumbing in them whatsoever.

Deersville PWS contact info  
 John Sukosd, Superintendent  
 Home 740-922-1961  
 Cell 740-260-0128  
 Sukosd@aol.com

RECEIVED

FEB 27 2017

Ohio Environmental  
 Protection Agency  
 Southeast District

CORP. LINE