

Company Wrench
 4805 Scooby Lane
 Carroll, OH 43112
 740-654-5304


PWS Name - Company Wrench PWS
 PWS ID - OH2351212
 Type of system - NTNC
 Contact - Brad Hutchinson
 Phone - 740-808-0053
 Email - brad@companywrench.com

Building was constructed in 2005
 Building is lead pipe and solder free
 From well pump to pressure tank is HDPE
 Distribution lines are copper
 w/lead free solder

- Hot Distribution
- Cold Distribution
- Non-Lead Service Entrance
- Pb/EV Sample Locations



Building A 1st Floor

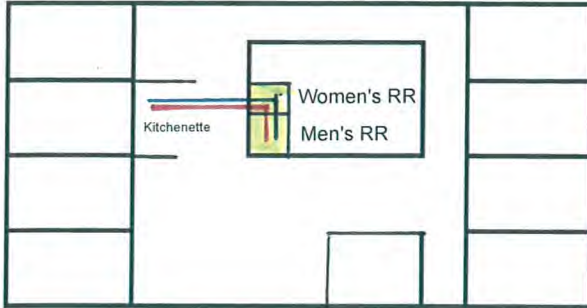

Company Wrench
 4805 Scooby Lane
 Carroll, OH 43112
 740-654-5304


PWS Name - Company Wrench PWS
 PWS ID - OH2351212
 Type of system - NTNC
 Contact - Brad Hutchinson
 Phone - 740-808-0053
 Email - brad@companywrench.com

Building was constructed in 2005
 Building is lead pipe and solder free
 From well pump to pressure tank is **HDPE**
 Distribution lines are copper w/lead free solder

- Hot Distribution
- Cold Distribution
- Pb/Cu Sample Locations



Building A 2nd Floor

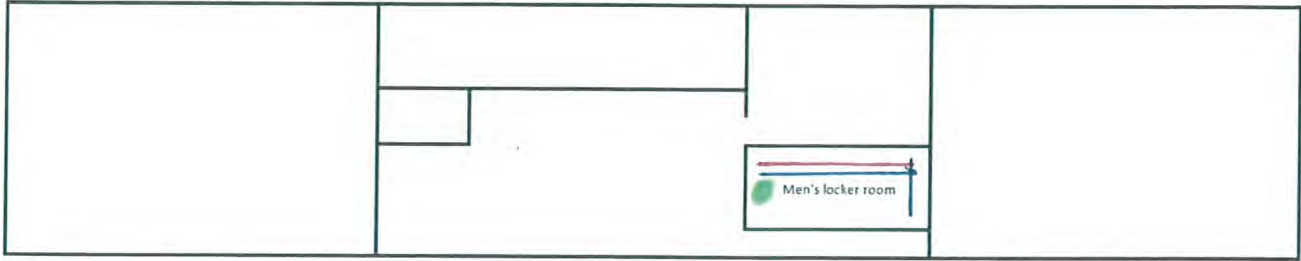

Company Wrench
 4805 Scooby Lane
 Carroll, OH 43112
 740-654-5304


PWS Name - Company Wrench PWS
 PWS ID - OH2351212
 Type of system - NTNC
 Contact - Brad Hutchinson
 Phone - 740-808-0053
 Email - brad@companywrench.com

● Non-Lead Service Entrance
 — Hot Distribution
 — Cold Distribution

Building was constructed in 2007
Building is lead pipe and solder free
From building A to B is HDPE
 Distribution lines are copper
 w/lead free solder



Building B 1st Floor

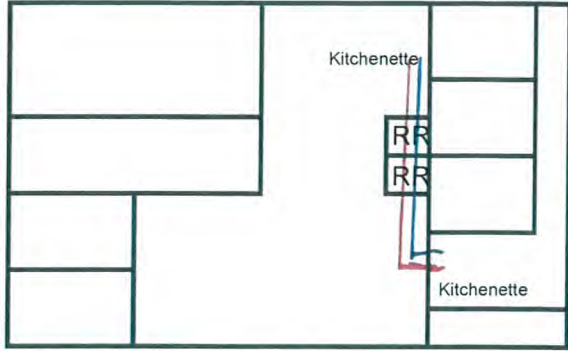

— Hot Distribution
 — Cold Distribution

Company Wrench
 4805 Scooby Lane
 Carroll, OH 43112
 740-654-5304

PWS Name - Company Wrench PWS
 PWS ID - OH2351212
 Type of system - NTNC
 Contact - Brad Hutchinson
 Phone - 740-808-0053
 Email - brad@companywrench.com

Building was constructed in **2007**
 Building is lead pipe and solder free
From building A to B is HDPE
 Distribution lines are copper
 w/lead free solder



Building B 2nd Floor