


HOUSTON PLUMBING PWS
 PWS ID: OH4536412
 724 MONTGOMERY RD NE
 NEWARK, OHIO 43055
 (740)763-3961

- 1/2" COPPER —
- 3/4" COPPER —
- 1" COPPER —
- 3/4" GALVANIZED —
- 1" PLASTIC —
- LEAST LIKELY TO CONTAIN LEAD
- LESS LIKELY TO CONTAIN LEAD
- MOST LIKELY TO CONTAIN LEAD

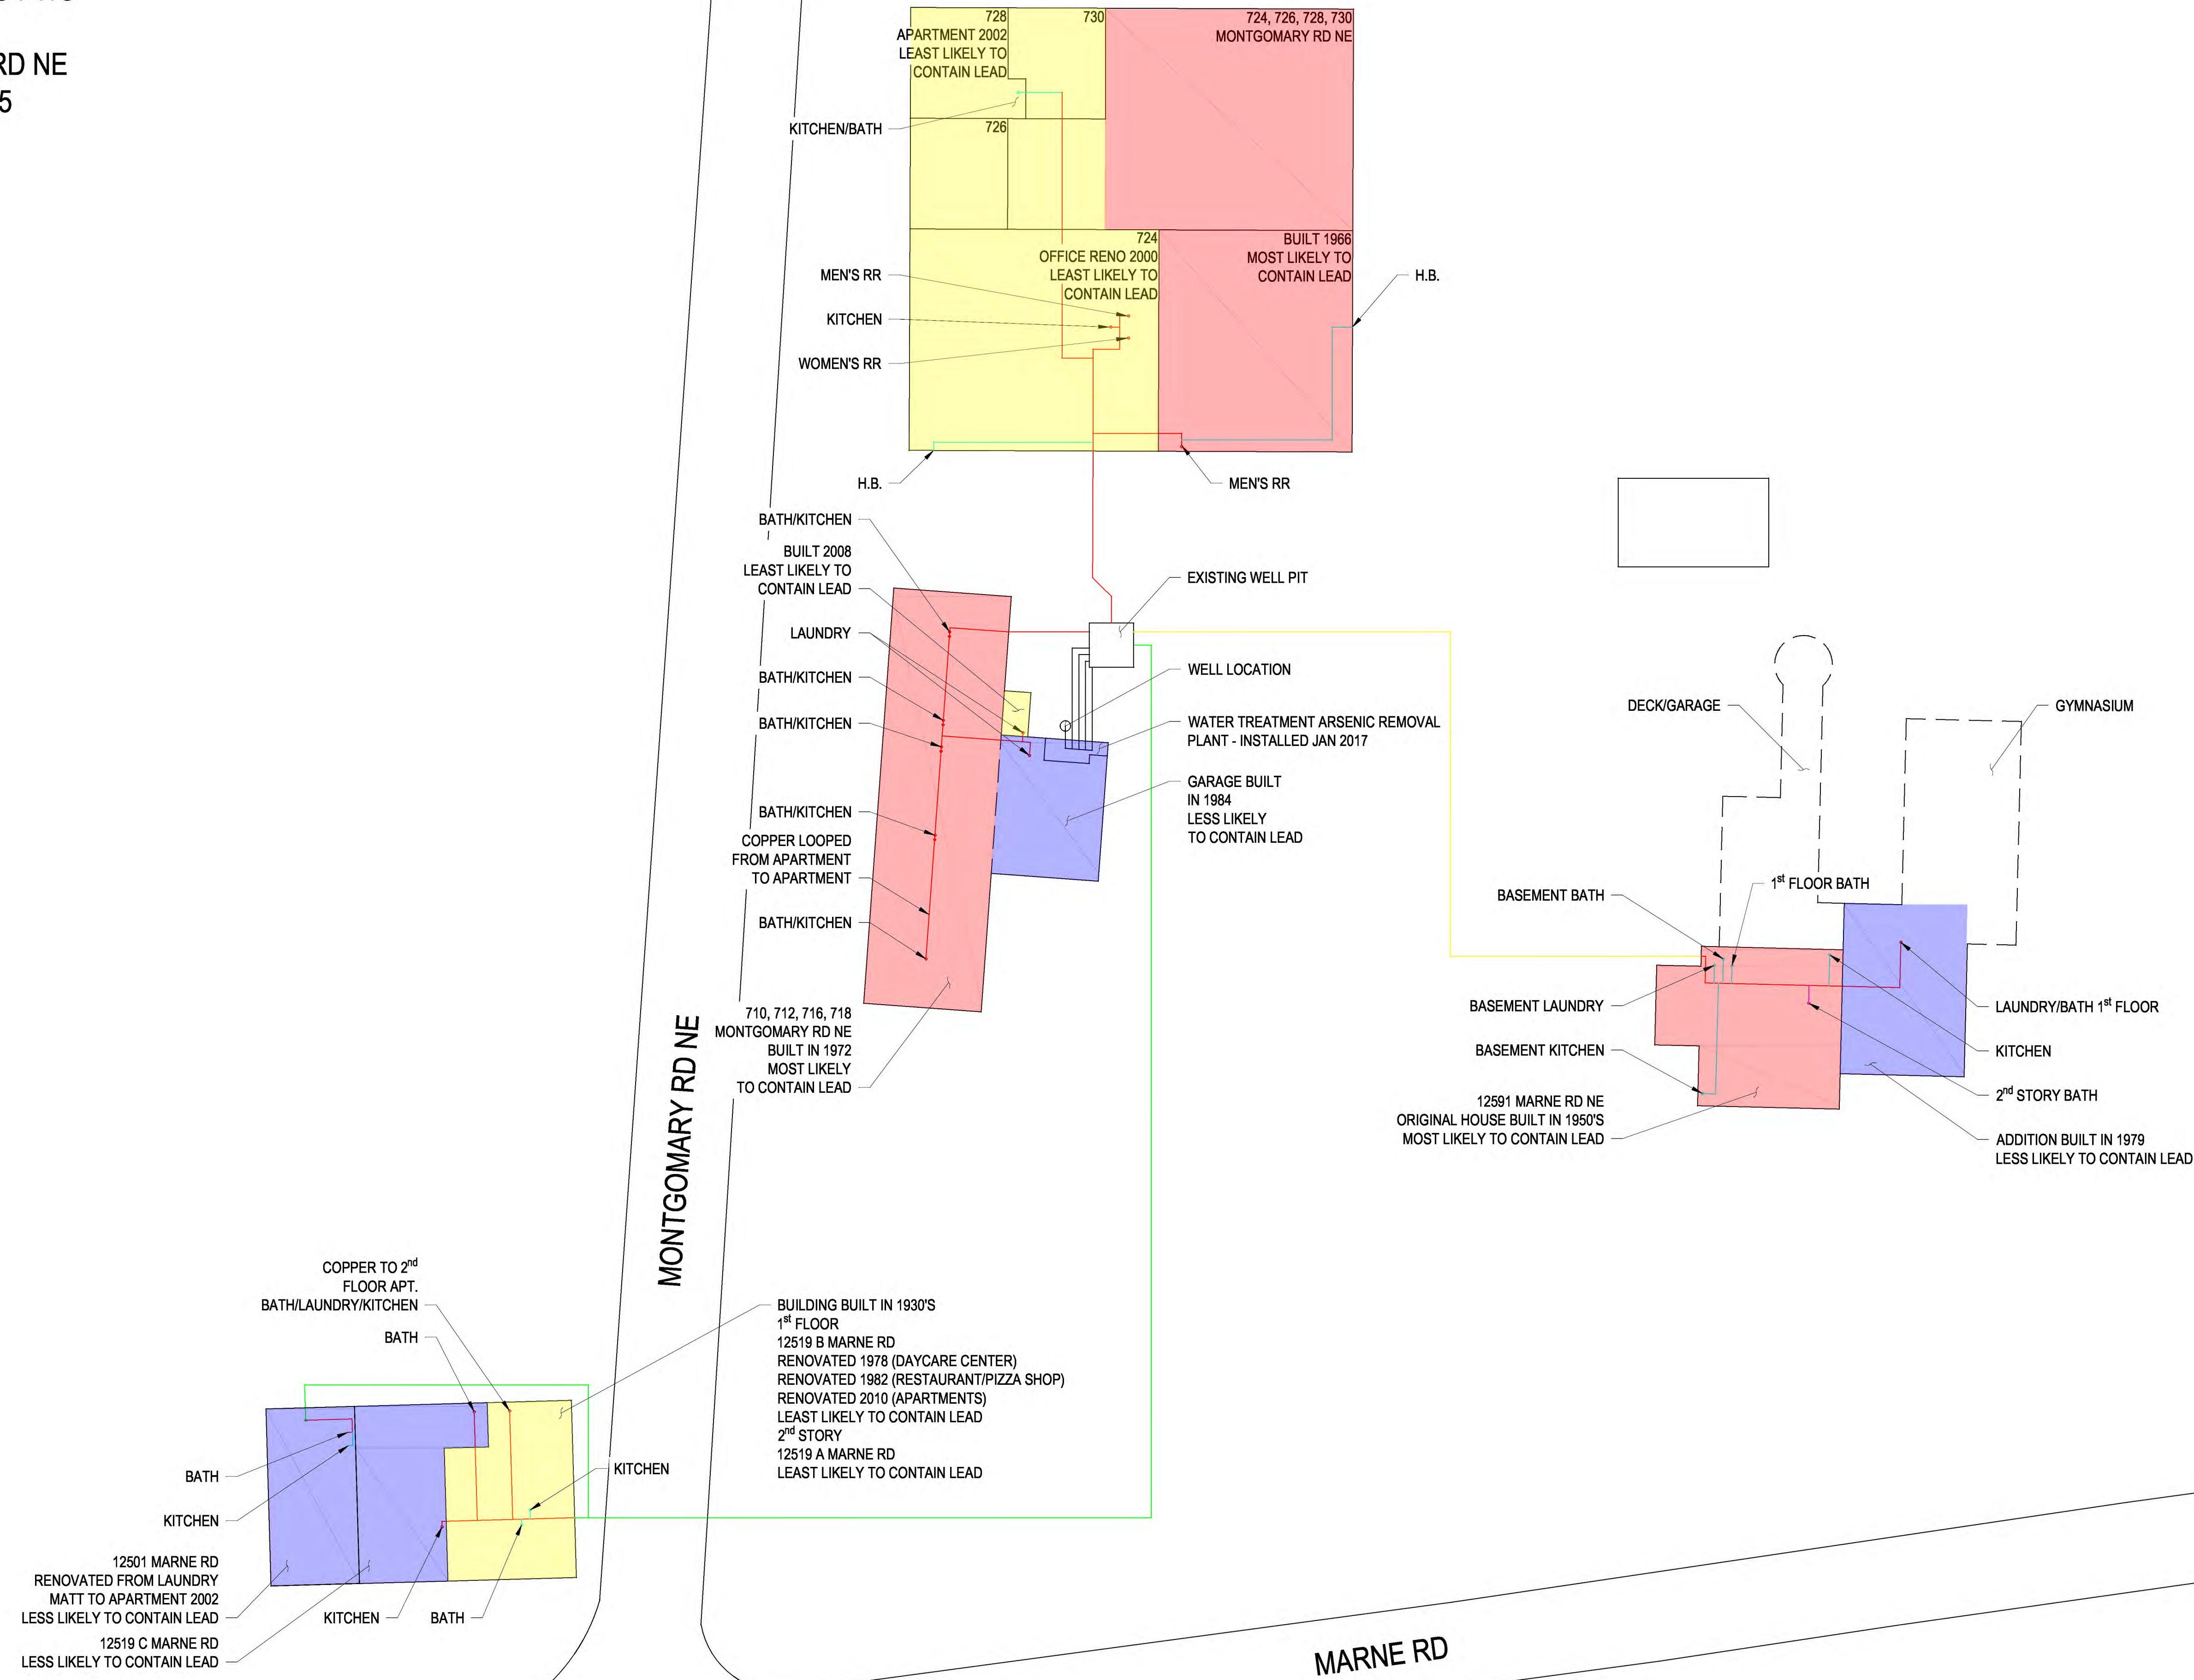

LEAD MAPPING PLAN
 1"=20'

27FEB2017
ISSUED FOR REVIEW

REV	DATE	DESCRIPTION

Lead Mapping

Since 1963
Houston
 Plumbing & Heating

DRAWN KRW	CHECKED RFH
DATE 23FEB2017	
SCALE NOTED	
JOB NO. ---	
DRAWING NO. LM-100	