


The Bowerston Shale Company

1329 Seven Hills Rd NE, Newark OH, 43055
EPA-SMP Lead and Copper Map

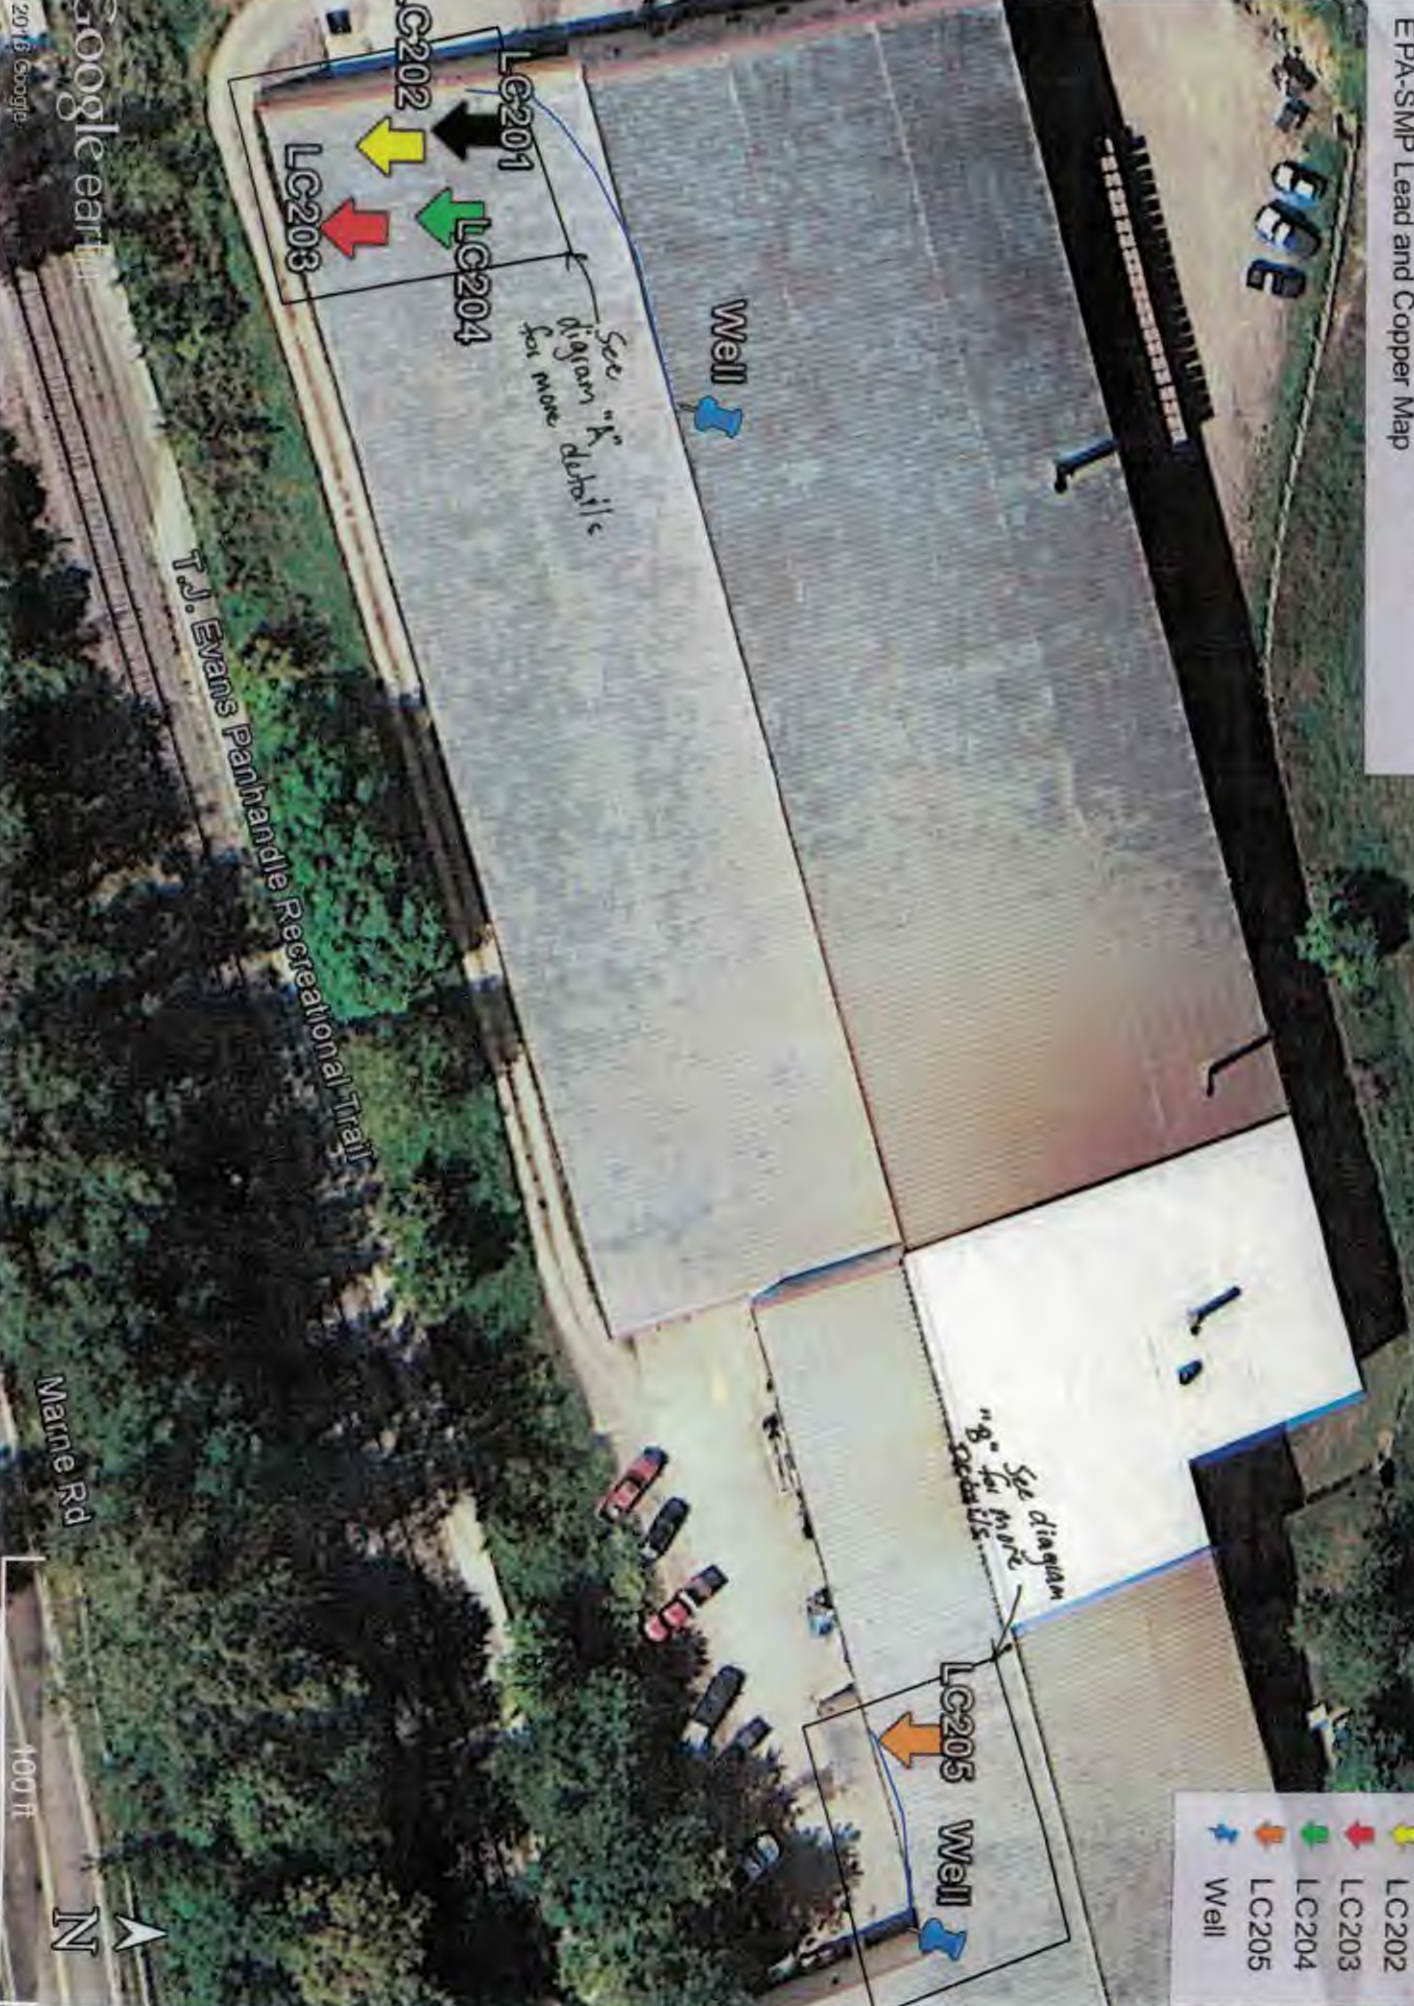

Legend

- LC201
- LC202
- LC203
- LC204
- LC205
- Well

Google earth

© 2013 Google

T.J. Evans Panhandle Recreational Trail

Marne Rd

N

Diagram A

- KEY
- Hot water line
 - Cold water line

* All water fixtures and pipe fittings are brass free and lead free (new 1999)

* Pipes are plastic + copper (new 1999)

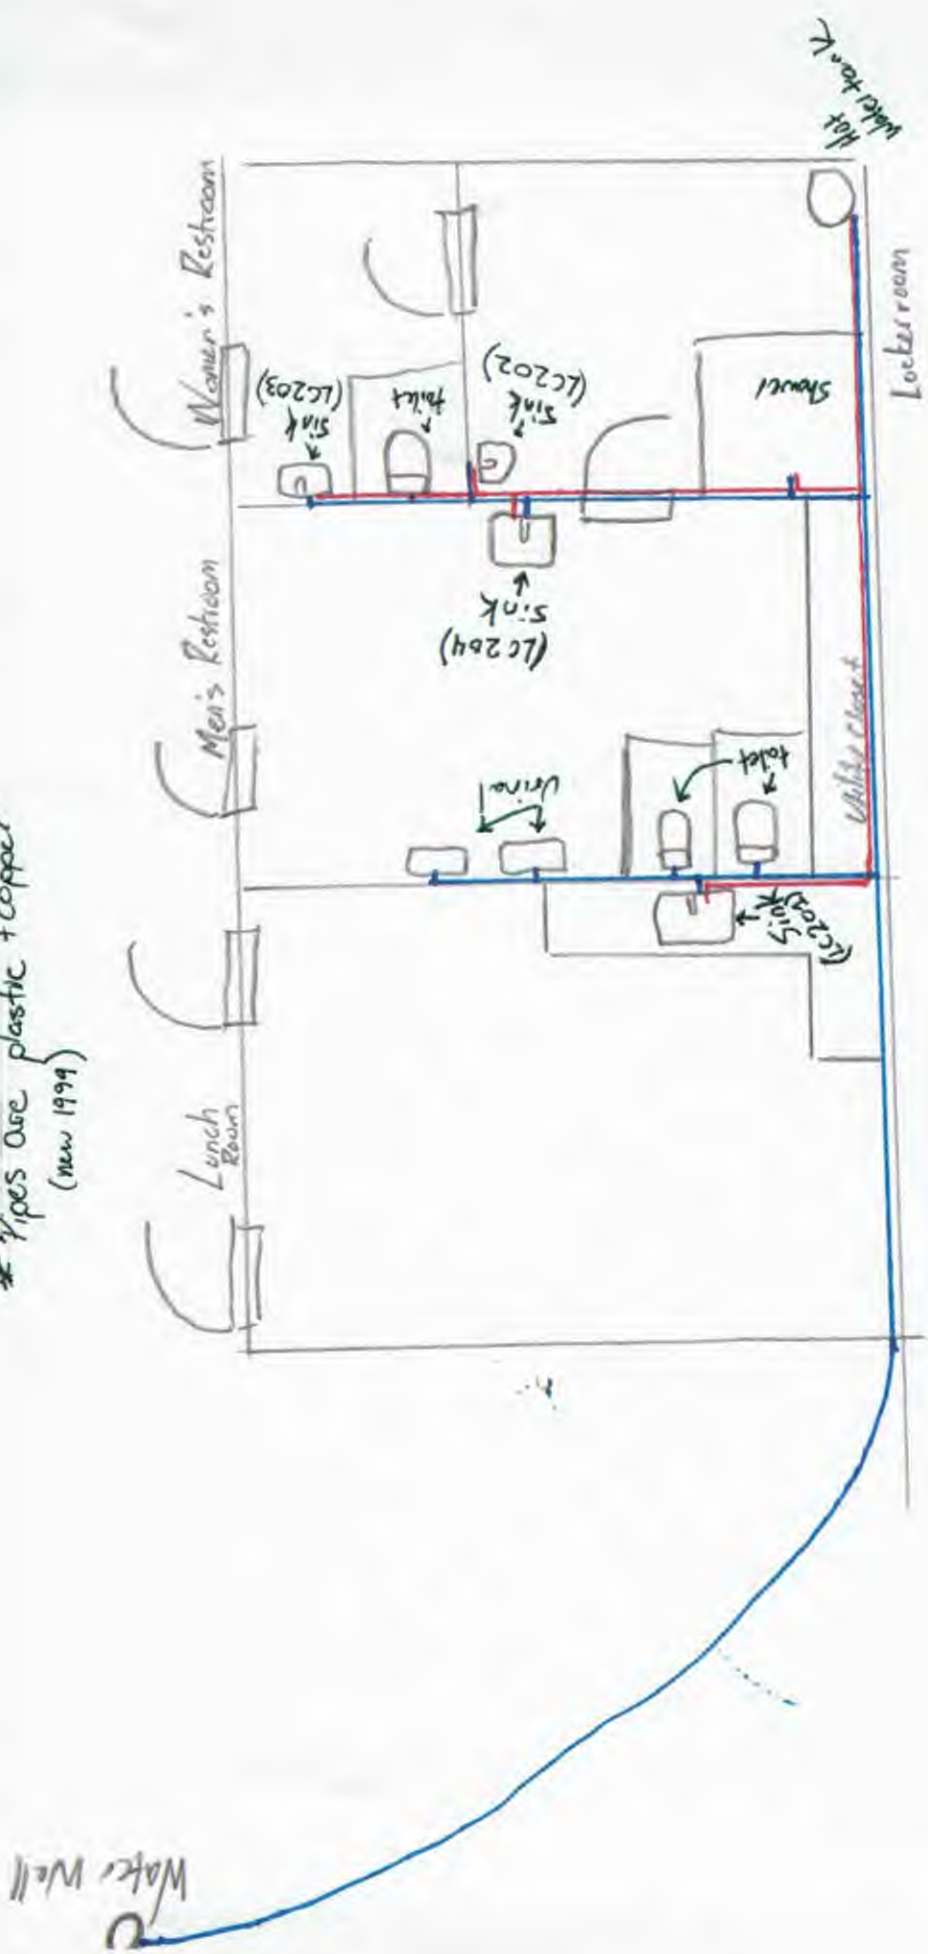


Diagram "A"

****Special Note(s)**

- All water fixtures and pipe fittings are brass and lead free (New 1999)
- Water supply pipes are a combination of plastic and copper with lead free solder (New 1999)

KEY	
Hot Water Supply Line	_____
Cold Water Supply Line	_____

- Key

- Hot water line

- Cold water line

Diagram "B"

* All water fixtures and pipe fittings are brass free and lead free (new 1999)

* Pipes are plastic + copper (new 1999)

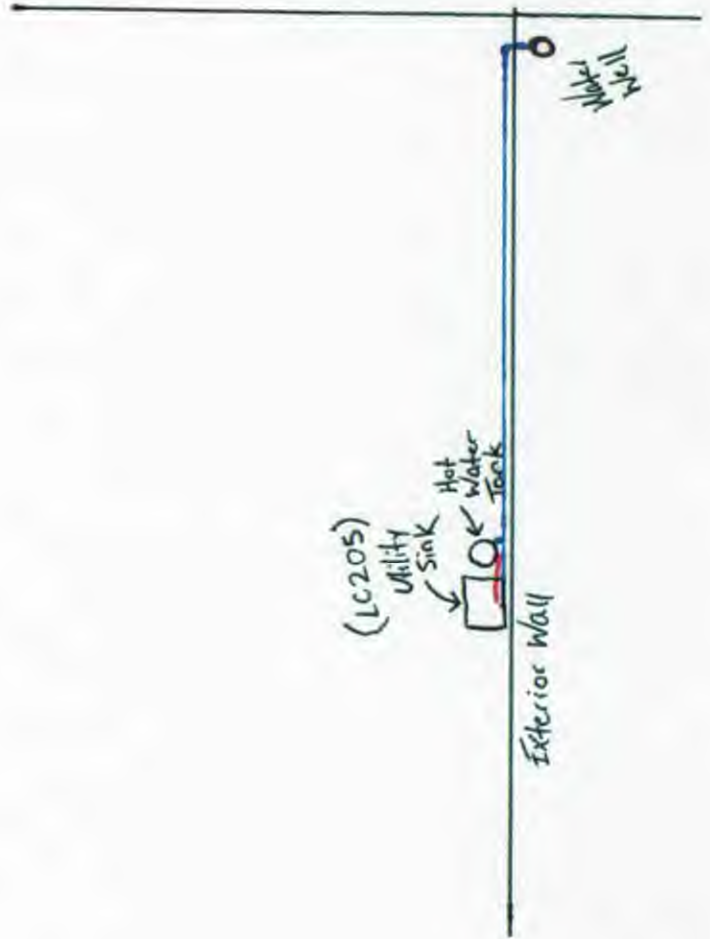


Diagram "B"

**Special Note(s)

- All water fixtures and pipe fittings are brass and lead free (New 1999)
- Water supply pipes are a combination of plastic and copper with lead free solder (New 1999)

