
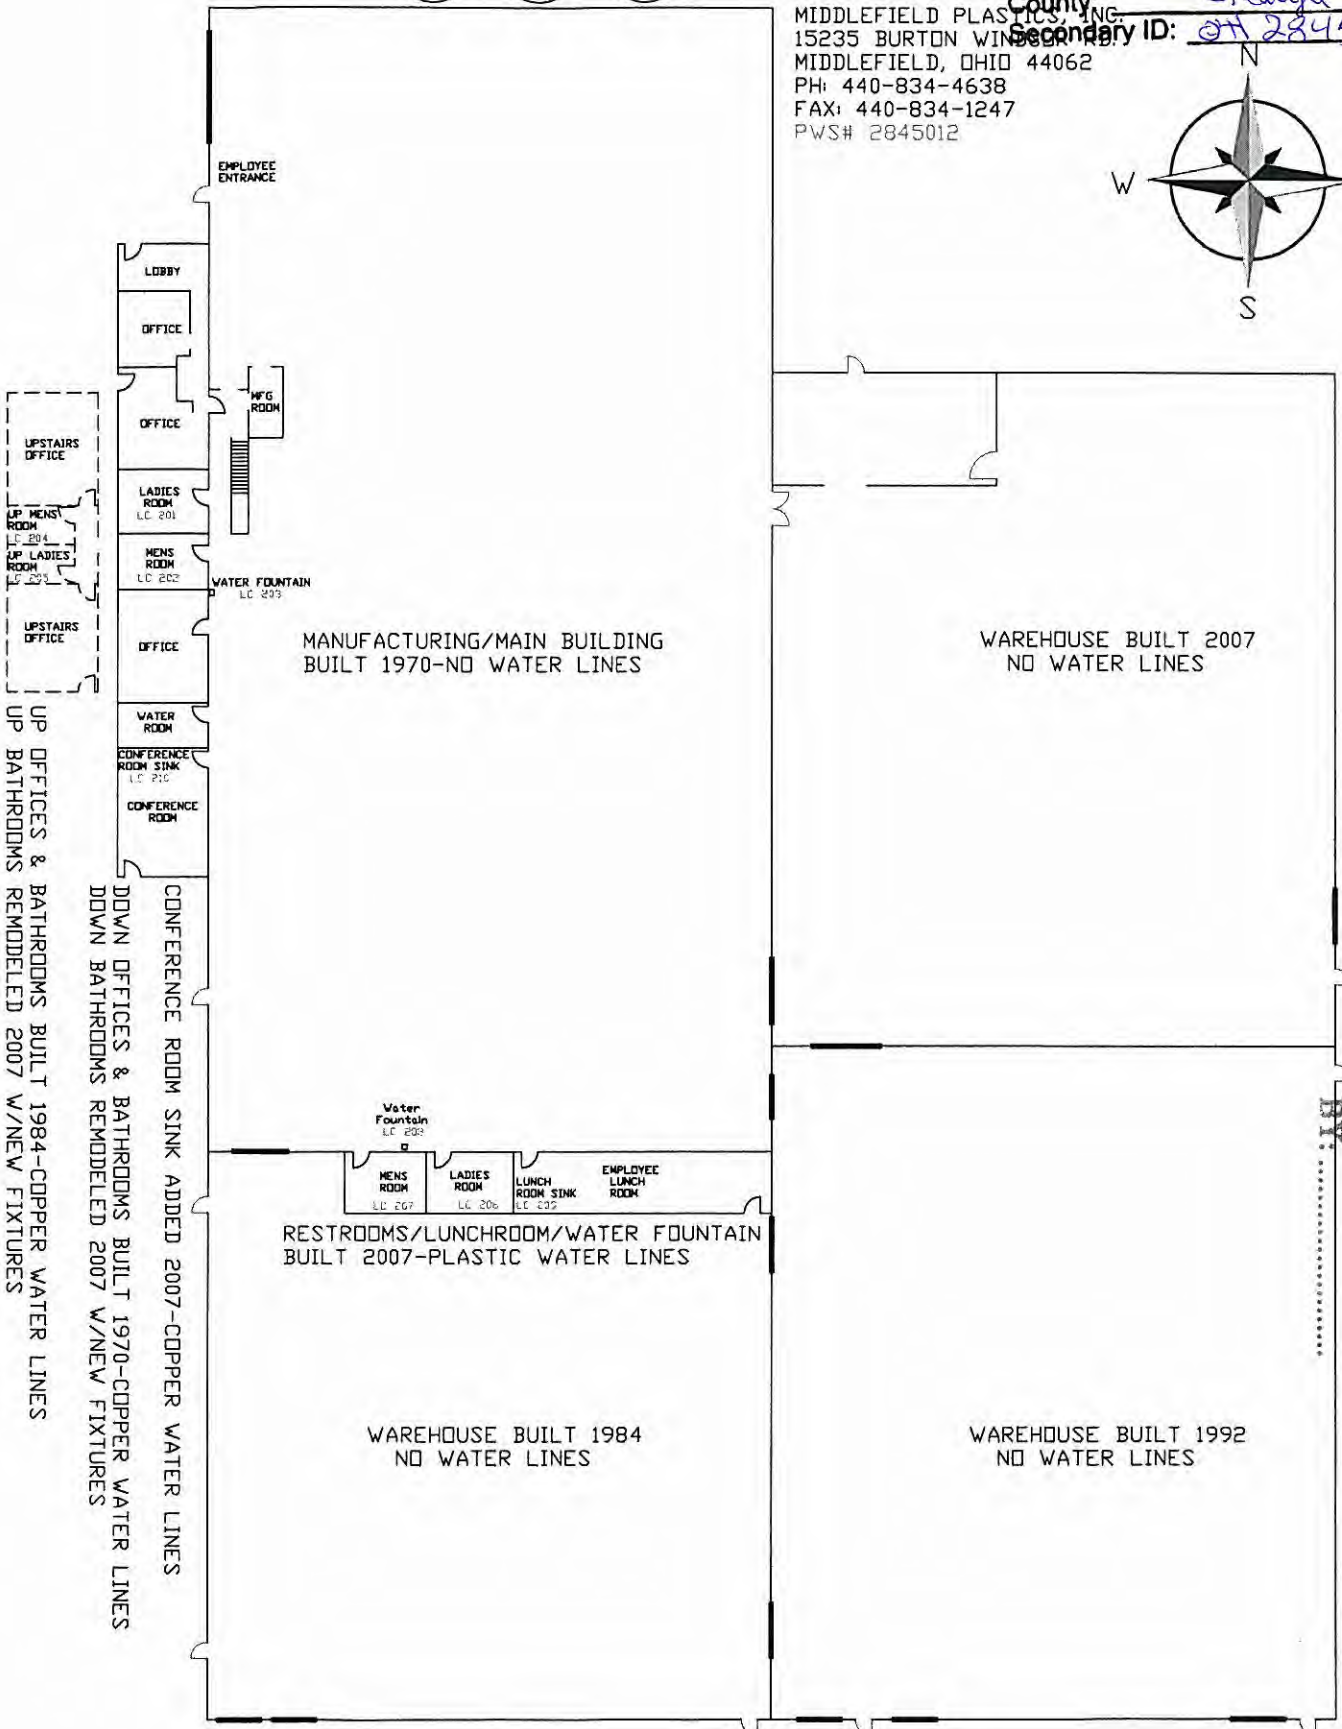
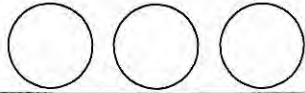


BURTON WINDSOR RD

ROUTE 608 3/4 MILE >>>>>>>>

Entity: Middlefield Plastics
 Doc Type: Report
 Doc Subtype: _____
 Program: DDAGW
 Secondary ID: OH 2845012

MIDDLEFIELD PLASTICS, INC.
 15235 BURTON WINDSOR RD.
 MIDDLEFIELD, OHIO 44062
 PH: 440-834-4638
 FAX: 440-834-1247
 PWS# 2845012

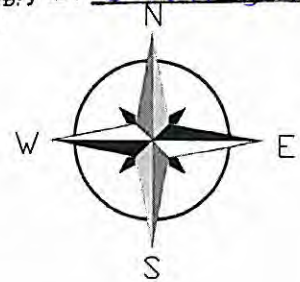

RECEIVED
 11/18/2011

UP OFFICES & BATHROOMS BUILT 1984-COPPER WATER LINES
 CONFERENCE ROOM SINK ADDED 2007-COPPER WATER LINES
 DOWN BATHROOMS REMODELED 2007 W/NEW FIXTURES