




Entity: Hershey Monessori Farm
 Doc Type: Report
 Doc Subtype:
 Program: DDAW
 County: Crawford
 Secondary ID: OH2869012

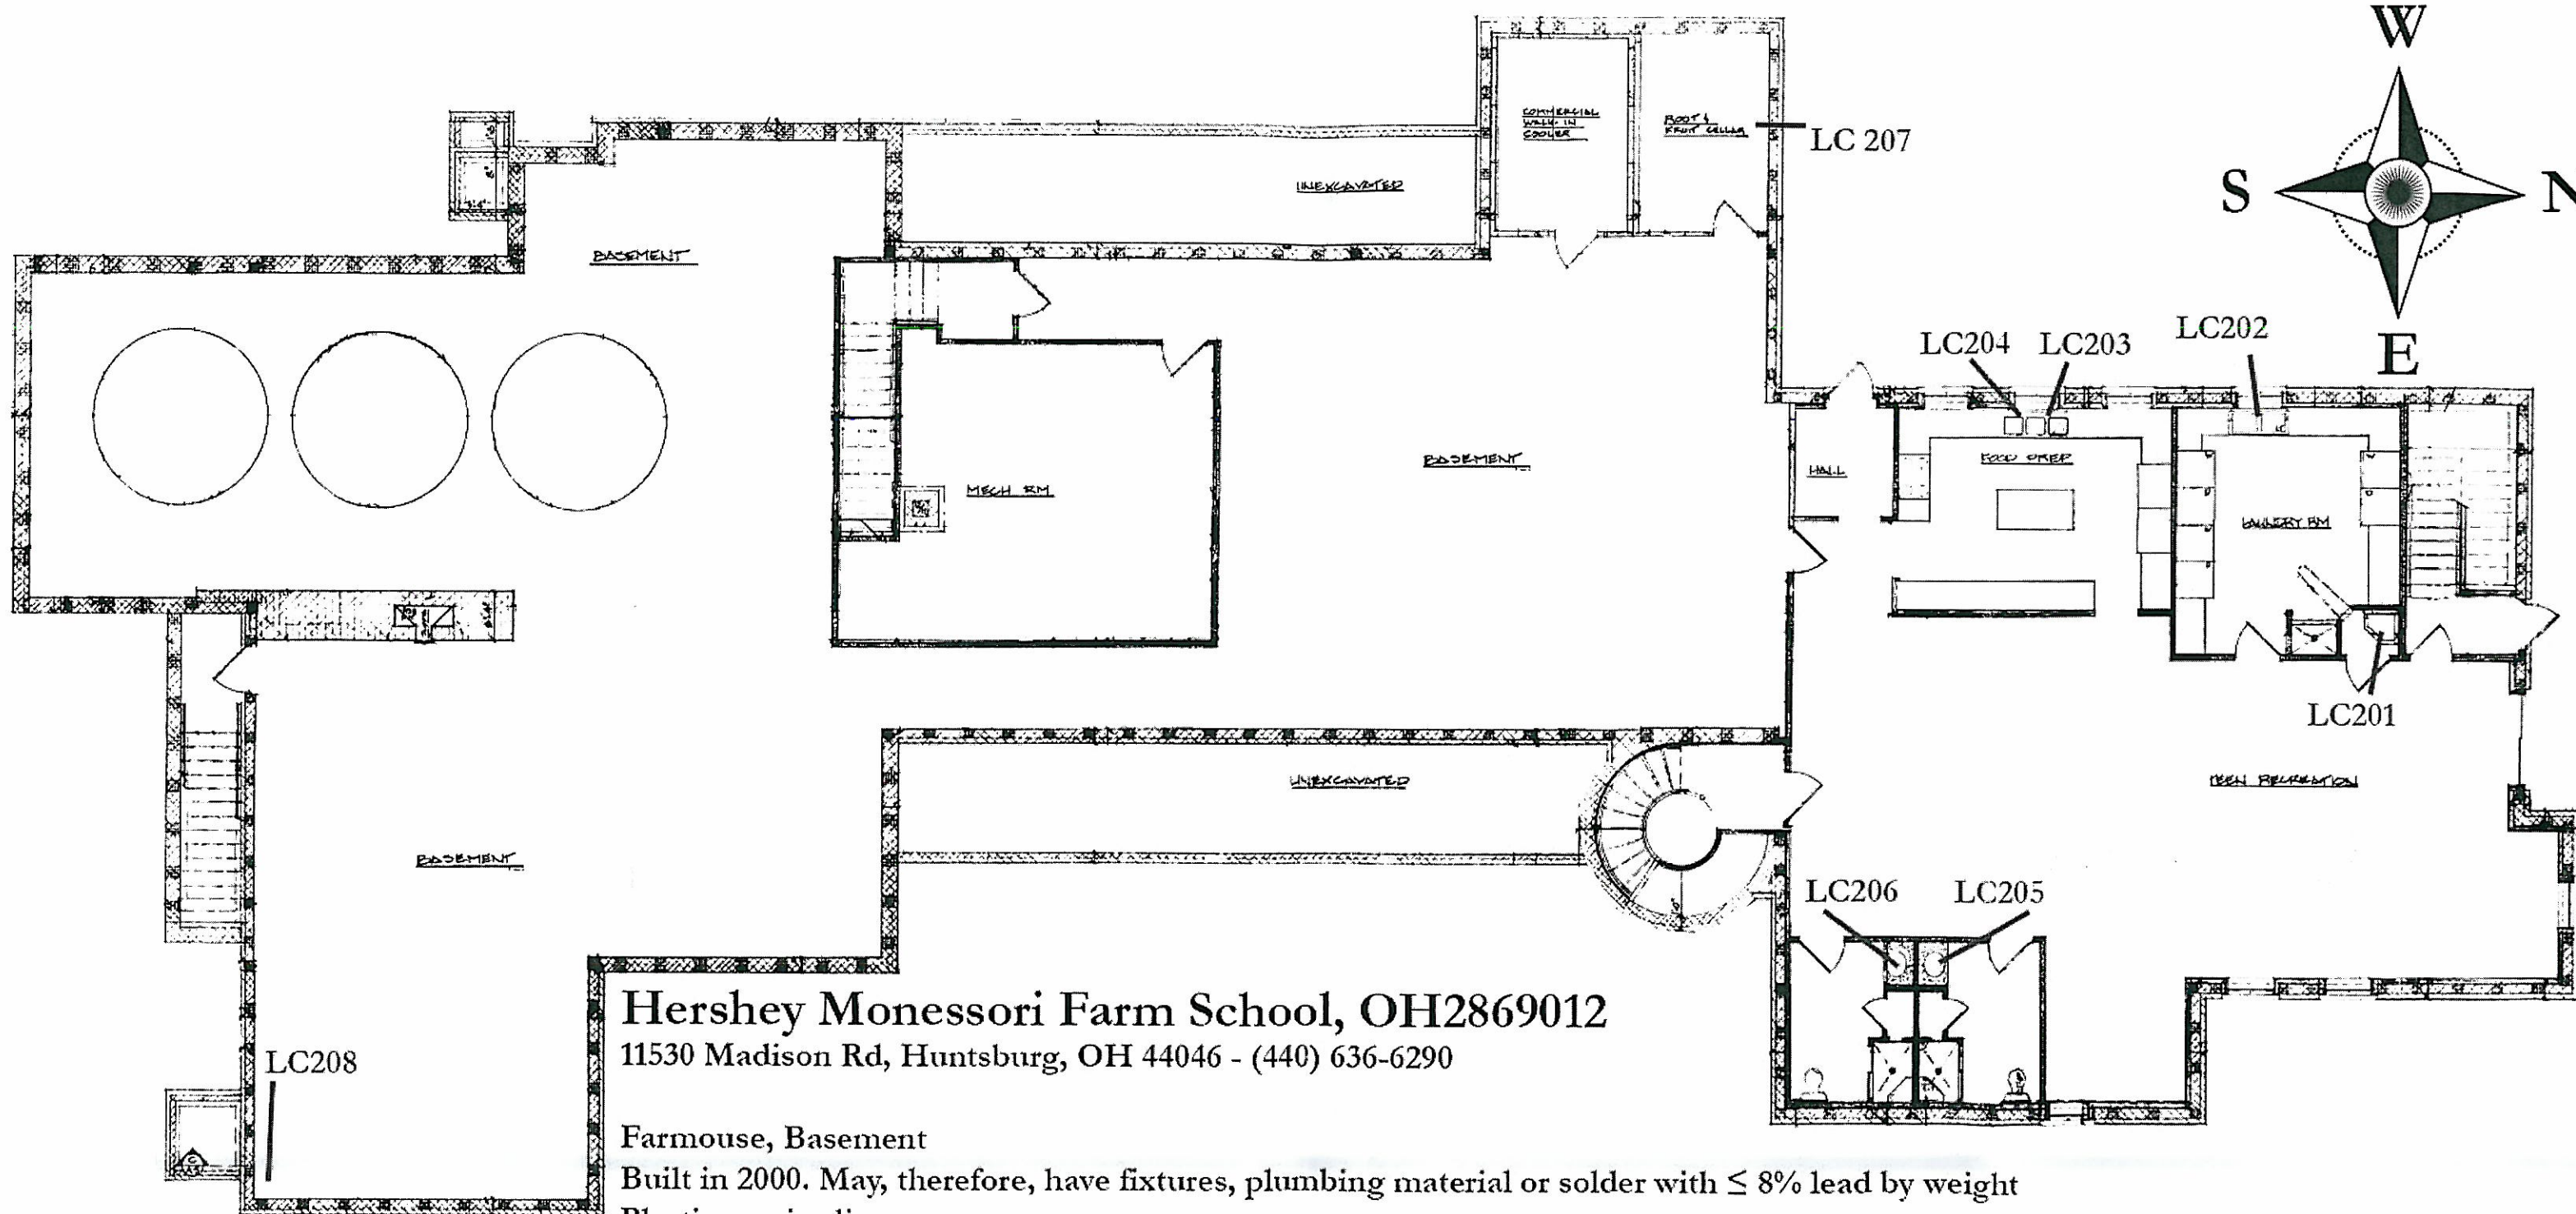

rec'd 1/17

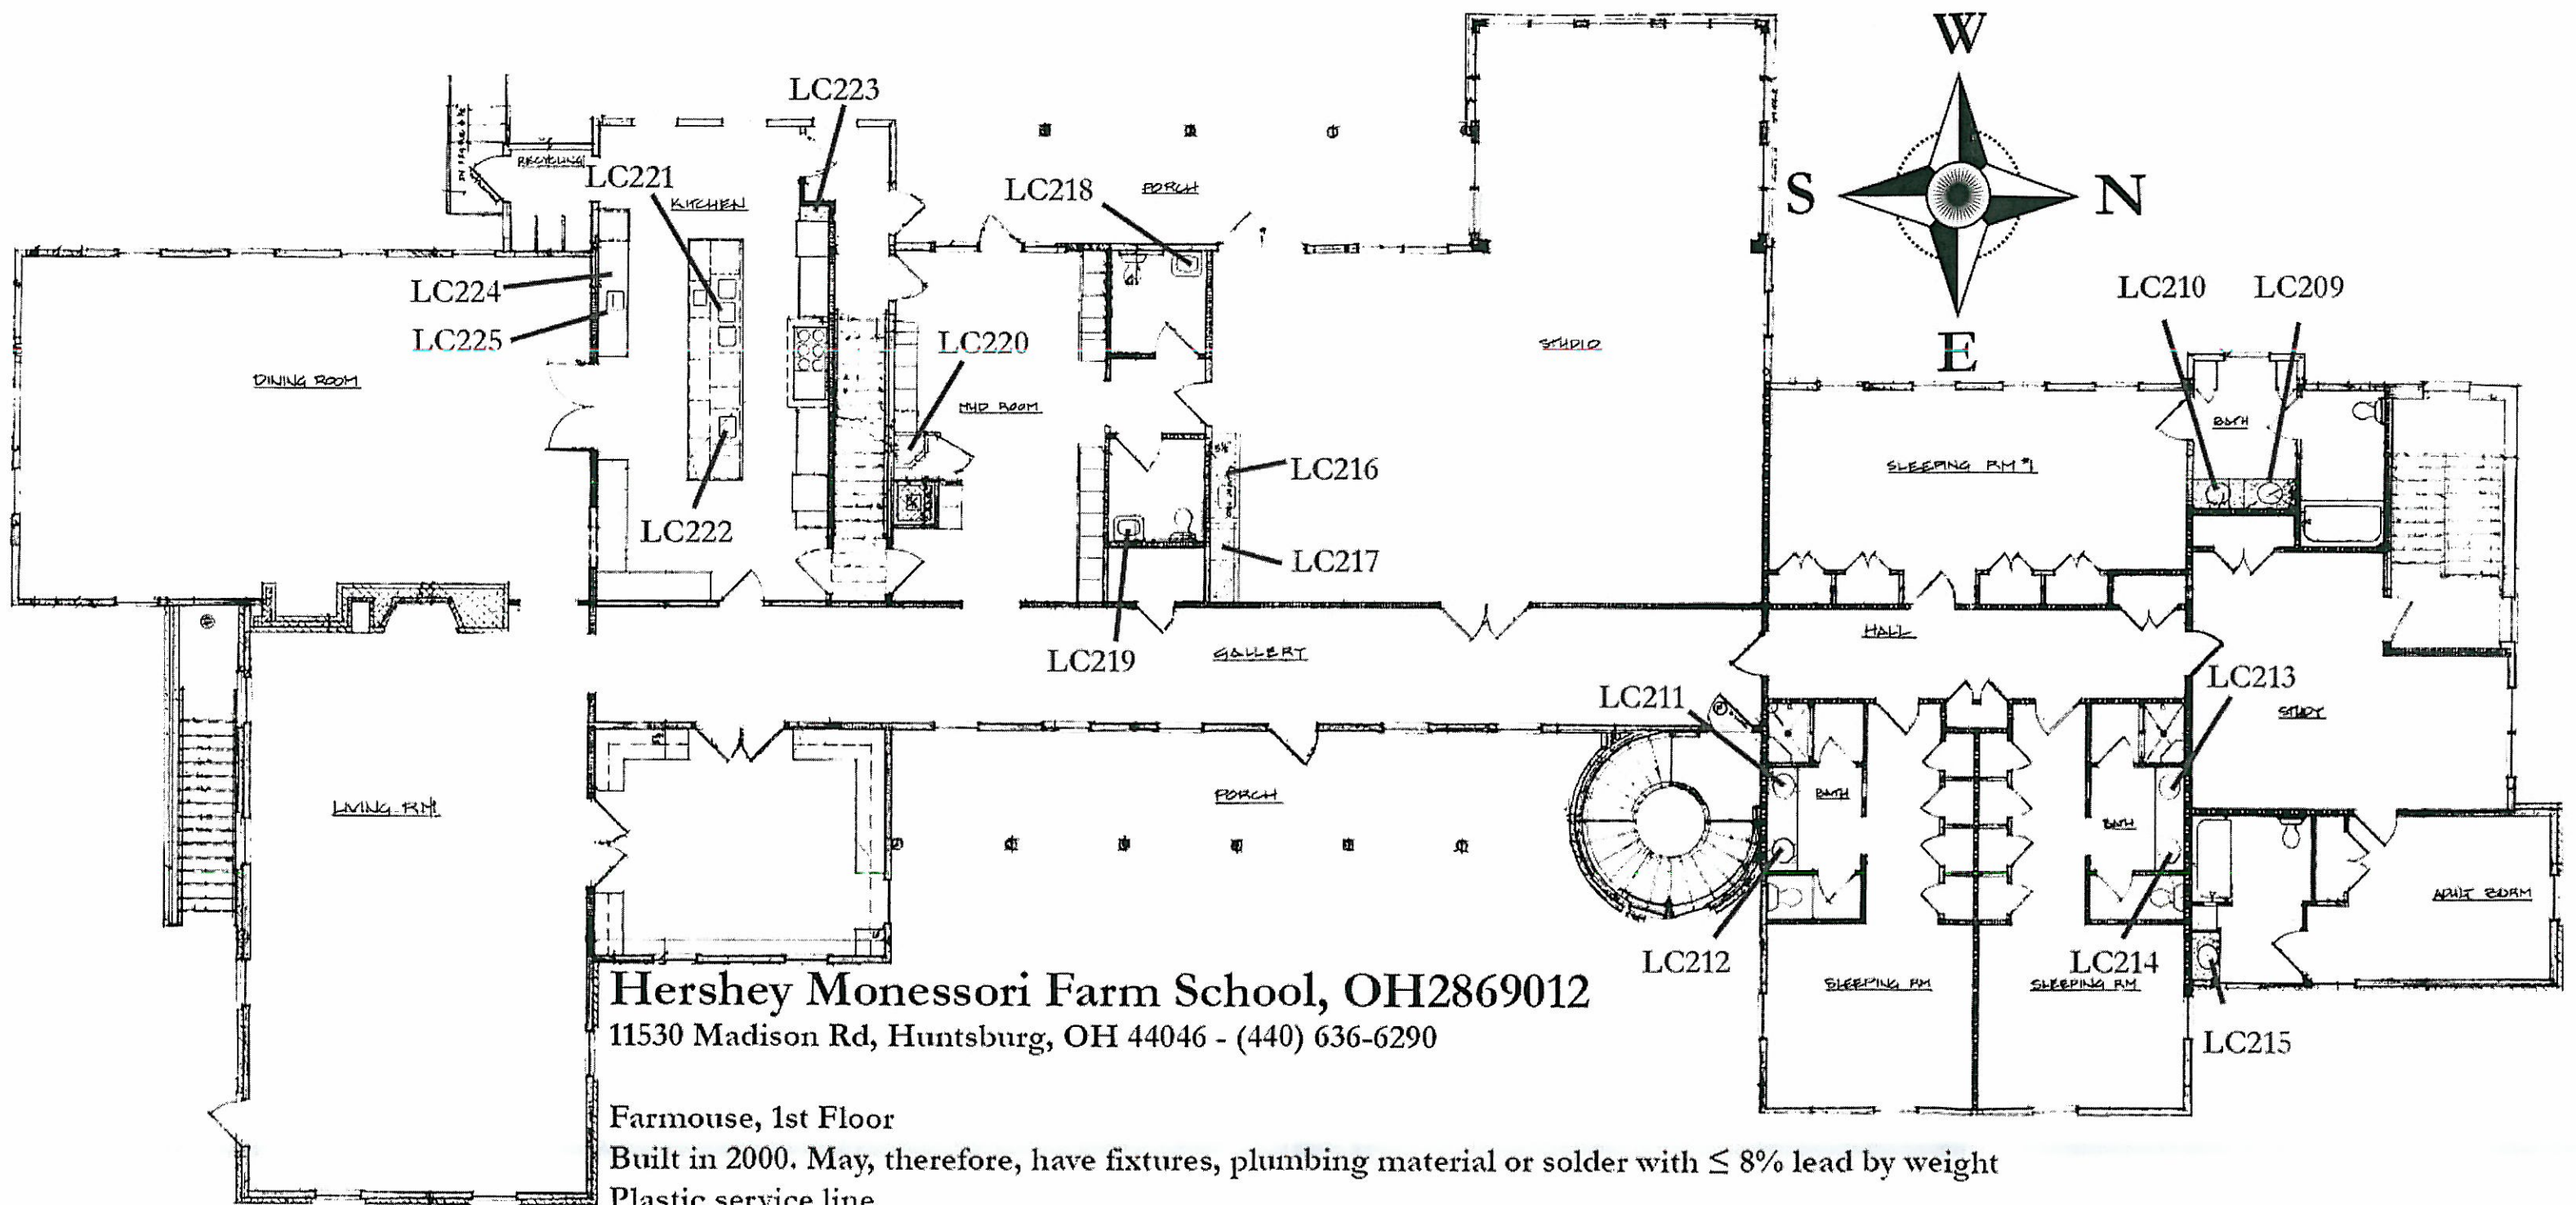

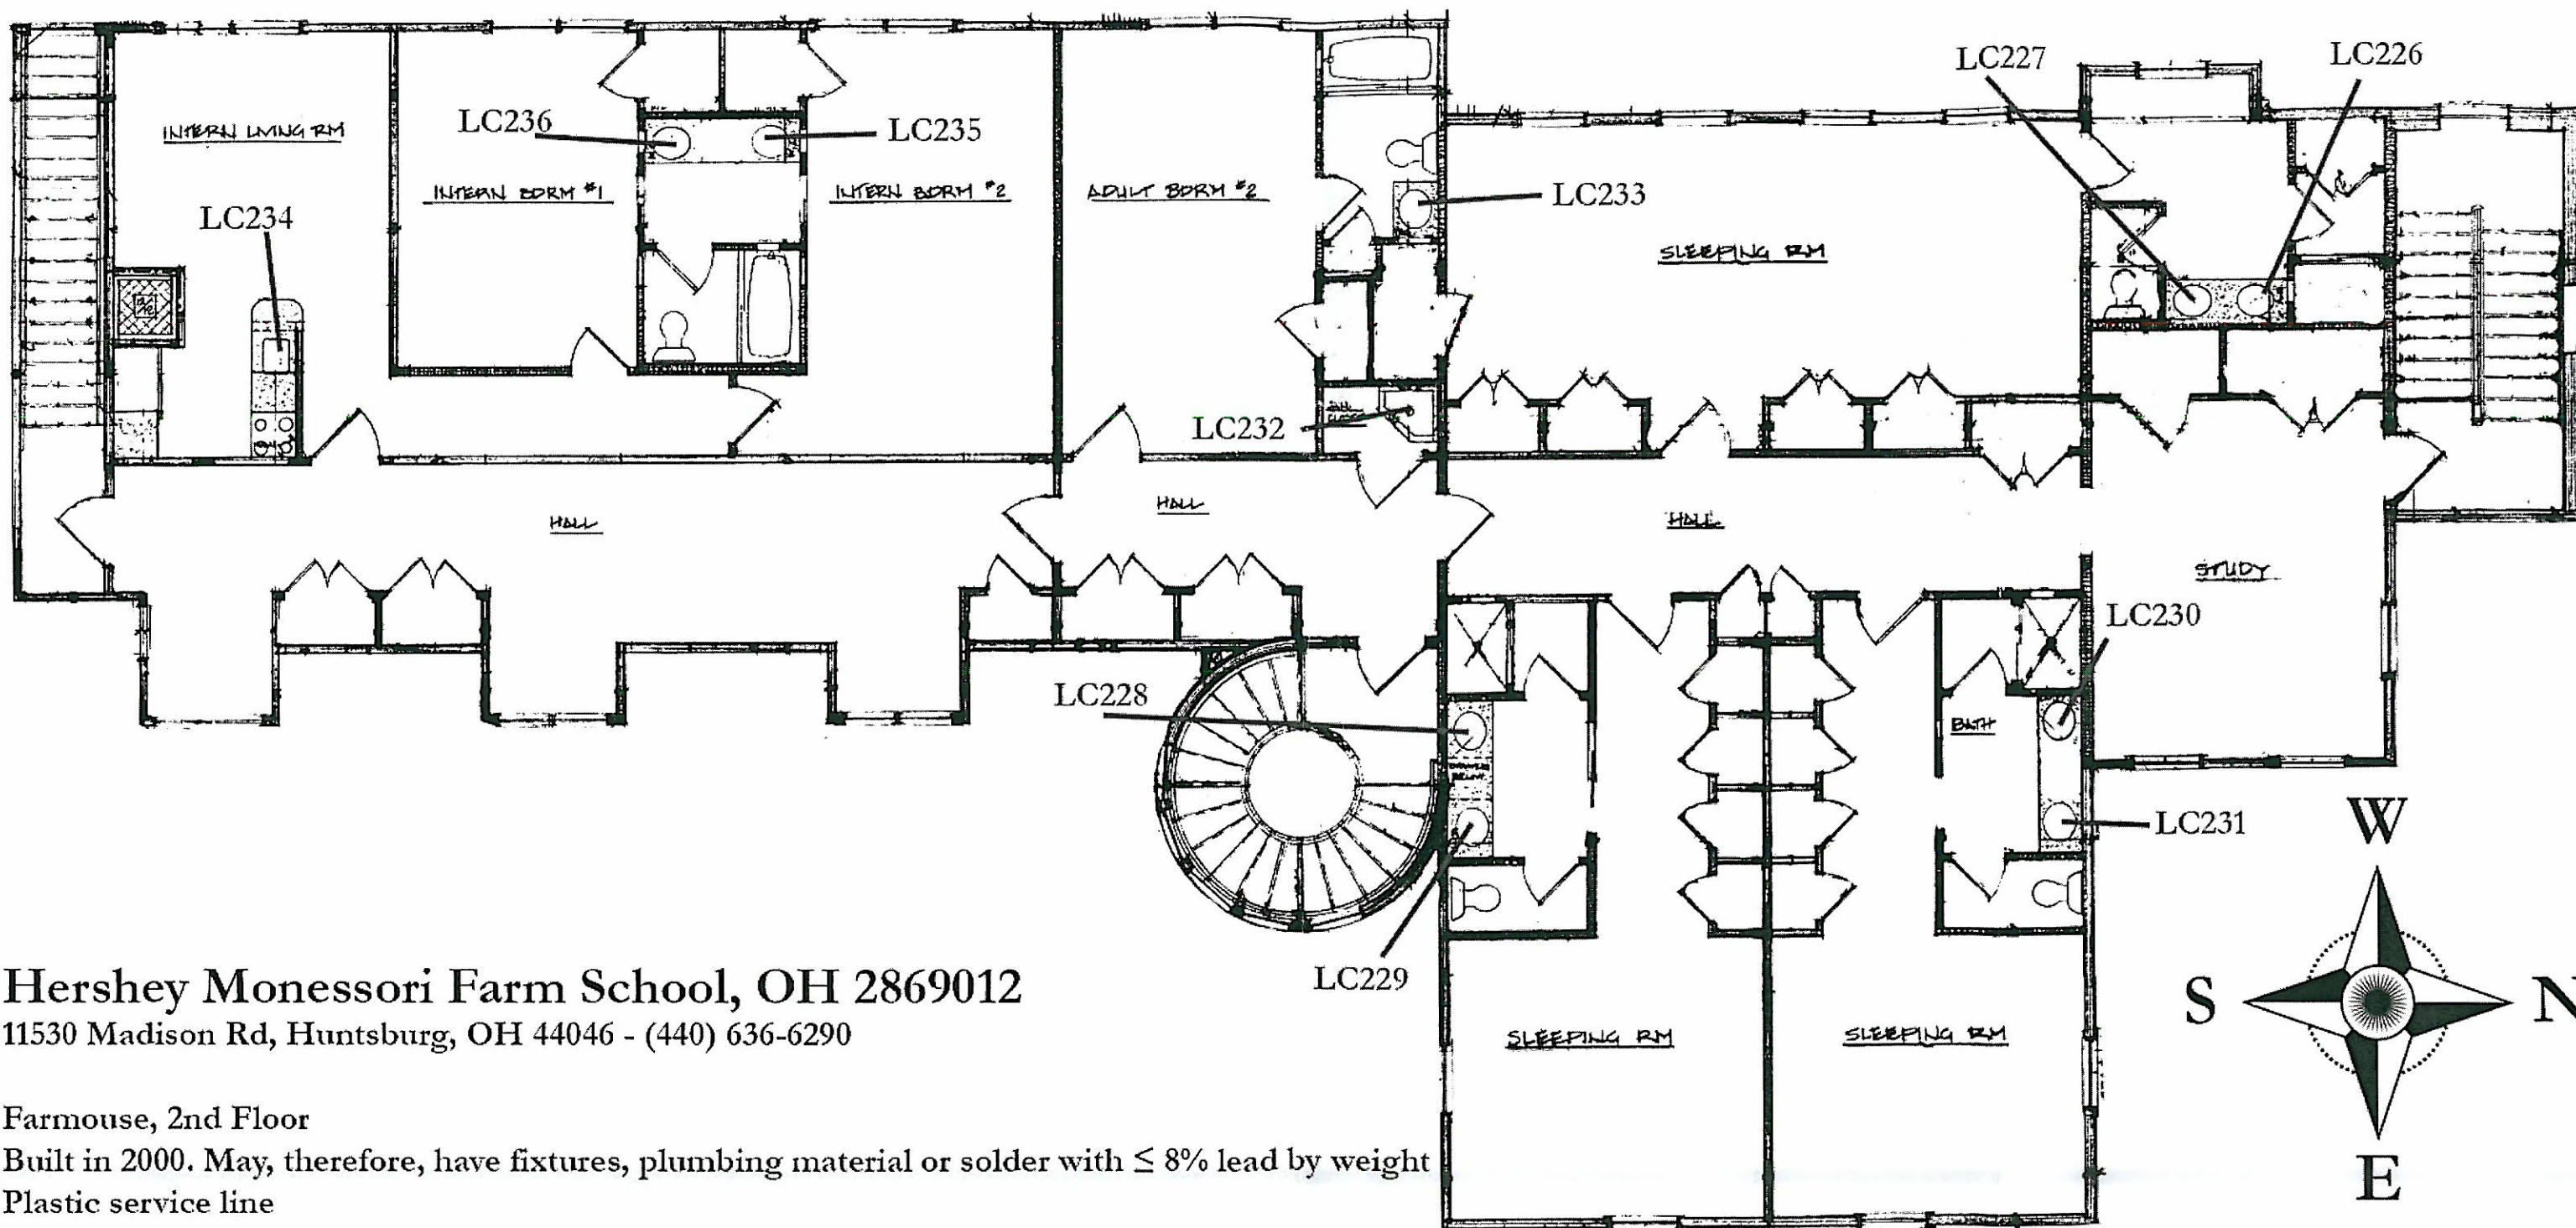

Hershey Monessori Farm School, OH 2869012
 11530 Madison Rd, Huntsburg, OH 44046 - (440) 636-6290

Farmouse, 2nd Floor
 Built in 2000. May, therefore, have fixtures, plumbing material or solder with $\leq 8\%$ lead by weight
 Plastic service line