


Mar-Bal Inc., 16930 Munn Road, Auburn Township, Geauga County, Ohio
440-543-7526

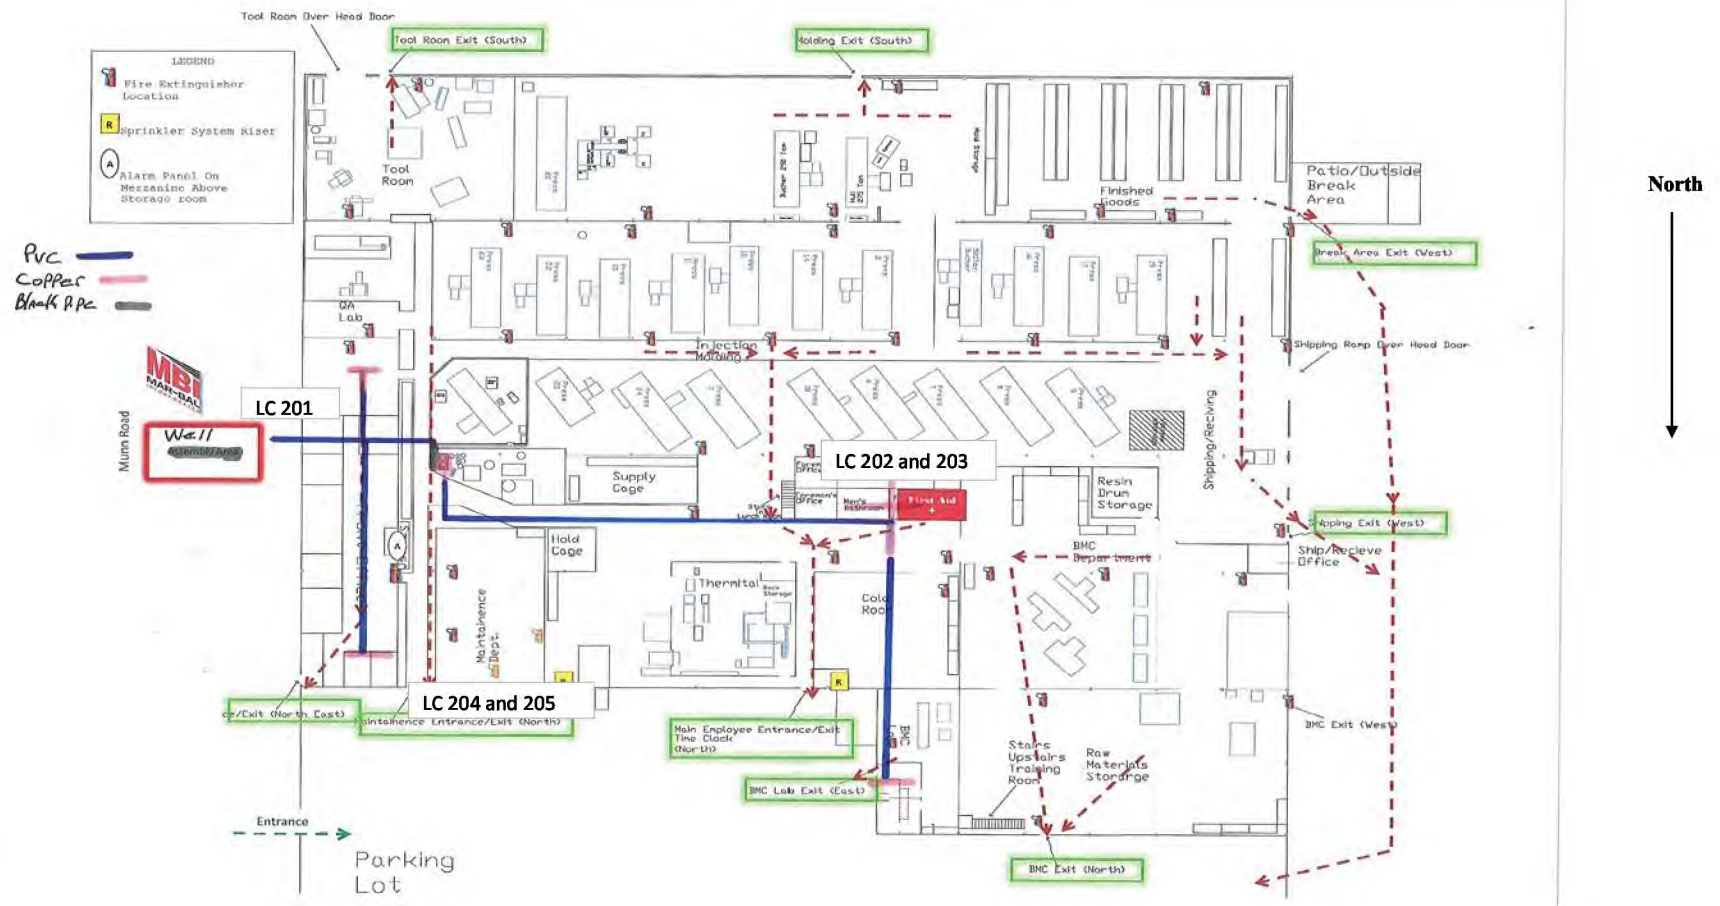

Please refer to the "Spreadsheet for lead and copper sample sites" previously submitted to Ohio EPA for fixture types.

125 feet