

RE: Sycamore Village PWS
Report
Drinking Water Program
Wyandot County
PWS ID: OH8800412

RECEIVED

FEB 27 2017

OHIO E.P.A.
N.W.D.O.

Village of Sycamore

The Village Water system is an older system dating back to early 1900's therefore they have found a few lead service lines over time, most of which I believe were replaced.

We currently schedule to replace any lead service lines that we locate.

We do not have any service files or history of service installations that would help us to locate any existing lead services.

Dave Clark

419-937-4124

2014
VILLAGE OF SYCAMORE
WATER SYSTEM MAP



<p>Charles Clark Village Administrator</p> <p>Dave Clark Water Plant Operator</p> <p>Paul Boes Electric Distribution</p> <p>Chris Moler Utilities Clerk</p>	<p>Mayor Matthew D. Boucher Village Council</p> <p>Ralph Decker Anthony M. Flood Dave Myers Dawn Needles Vicki L. Weininger Darcy A. Zimmerman</p>
---	---

LEGEND

- 2" WATER LINE
- 4" WATER LINE
- 6" WATER LINE
- 8" WATER LINE

○ — green circular mains are PVC

— Oldest C.I. Mains
 Possibility for Lead Service Lines
 But Not Probable

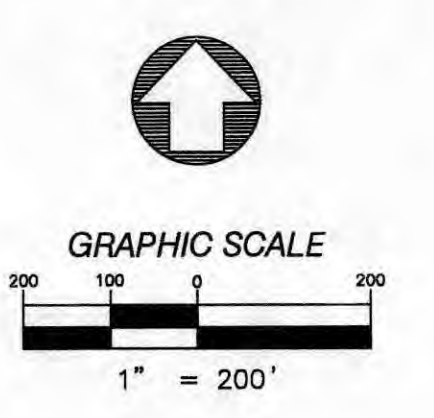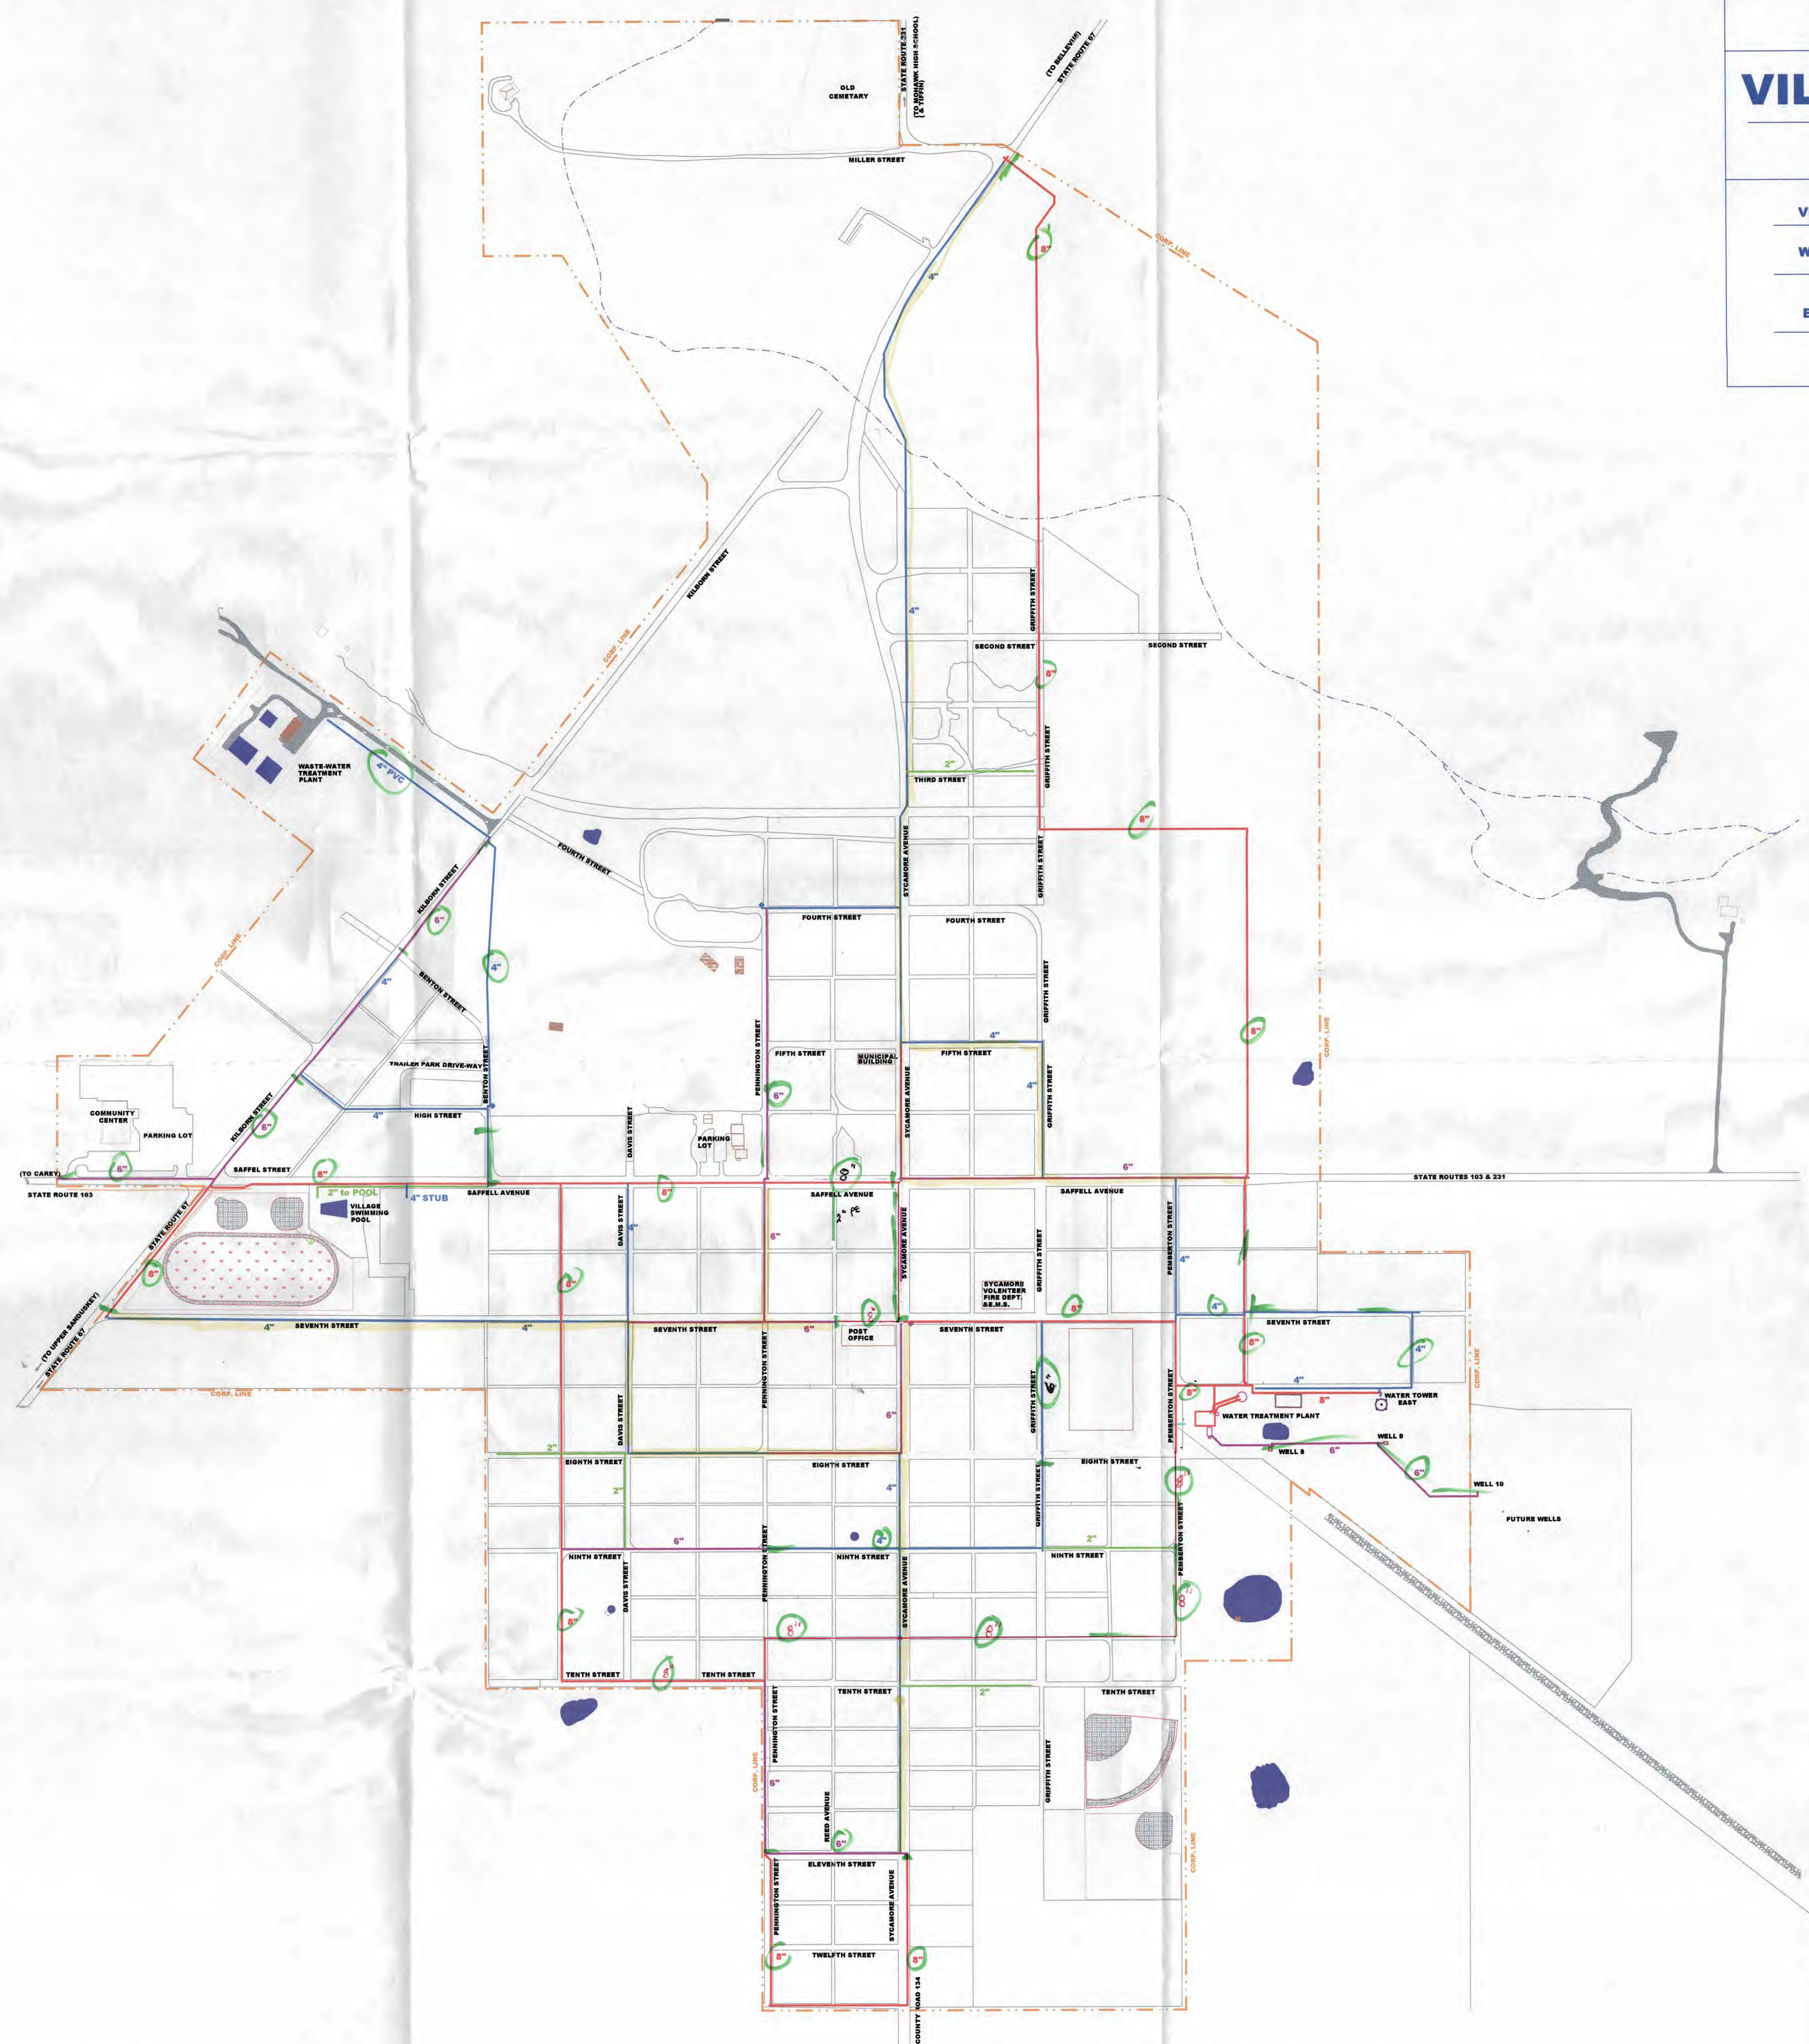

11100 S.R. 550
 ROOM 180
 ATHENS, OHIO 45701
 740-206-0010

128 EAST MAIN ST
 PO BOX 188
 LOGAN, OH 43138
 740-385-2140

1495 OLD HENDERSON RD
 COLUMBUS, OH 43220
 614-459-6992

507 MAIN STREET, SUITE 203
 ZANESVILLE, OH 43701
 740-450-1640

FAX: 614-459-6987
 TOLL FREE: 866-277-0600

RECEIVED
 FEB 27 2017
 OHIO E.P.A.
 N.W.D.O.