


RE: St Johns Hilltop Preschool
Report
Drinking Water Program
Wood County
PWS ID: OH8739112



LEGEND


DESCRIPTION	SYMBOL	DESCRIPTION	SYMBOL	DESCRIPTION	SYMBOL
WELL	(W)	UTILITY SINK	□	P.V.C. WATER LINE	—
BOILER	(B)	SINK	□	COPPER WATER LINE	—
PRESSURE TANK	(P)	VANITY	○	ASSUMED SOLDIER	
HOT WATER HEATER	(HW)	TOILET	○	SOB LEAD	
		DISH WASHER	□	SOB COPPER	
		HOSE BIB	+	COPPER WATER LINE (HOT)	—
		DRINKING FOUNTAIN	□	ASSUMED SOLDIER	
				SOB LEAD	
				SOB COPPER	

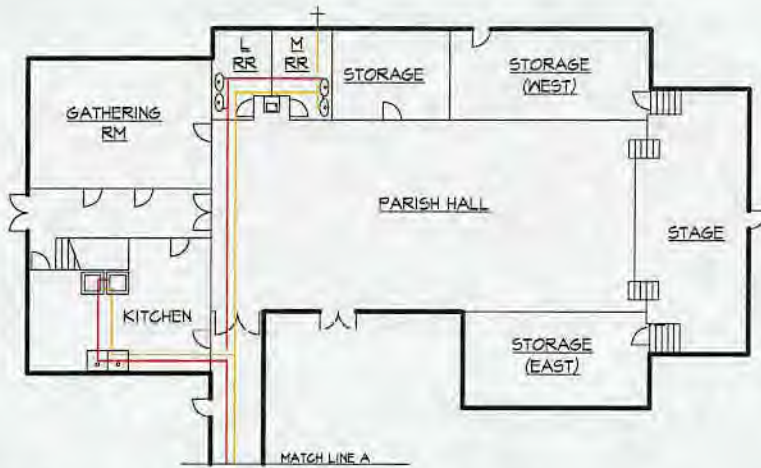

ALL PIPING CONSIDERED 3/4" COPPER UNLESS OTHERWISE LISTED

NOTE: FIXTURES LISTED ABOVE ARE PROBABLE OR UNKNOWN TO CONTAIN LEAD

PARISH HALL - BUILDING PLAN

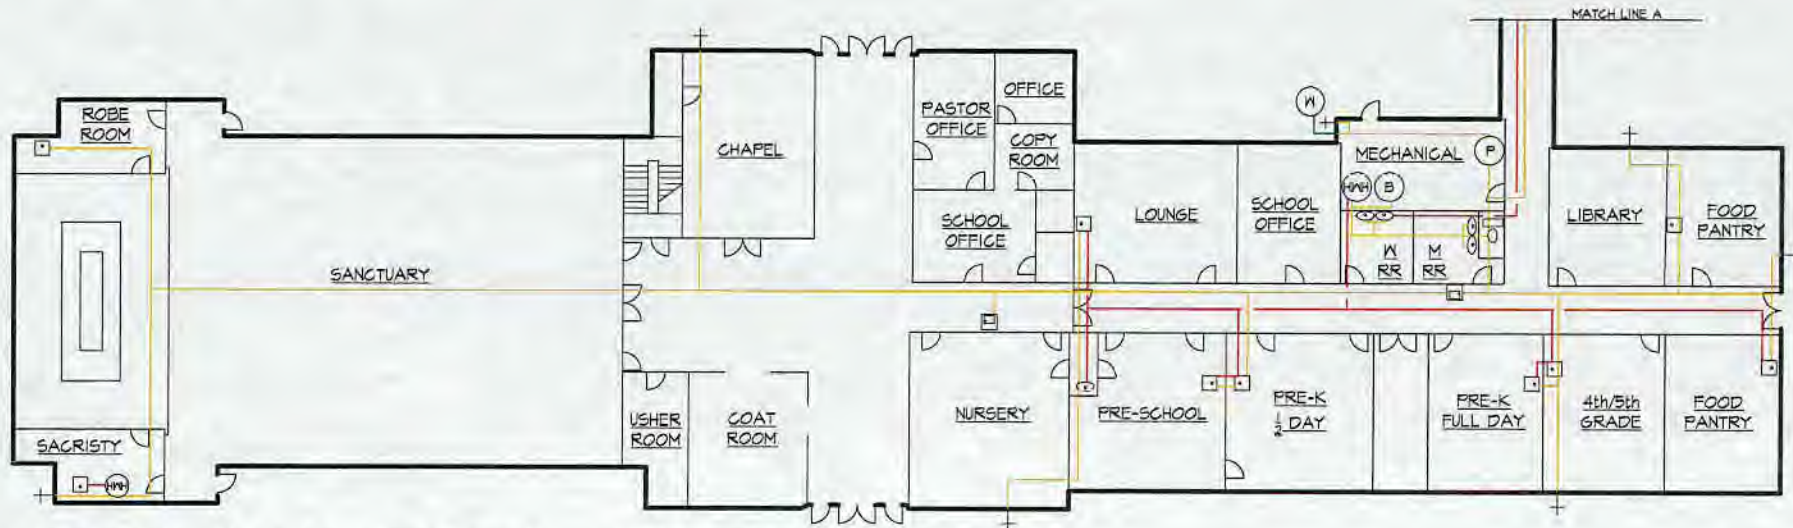

MAIN CHURCH AND CLASSROOM - BUILDING PLAN

February 22, 2017

St. Johns Hilltop Preschool
 5520 Fremont Pike, Stoney Ridge, OH 43463
 Tel: (419) 837-2223

E.P.A. Lead Pipe Infrastructure Mapping

