

RE: Hillandale Farms - Hicksville
Report
Drinking Water Program
Defiance County
PWS ID: OH2036412



Full Line Mechanical Contractors

*Fire Protection
HVAC*

*Process Piping
Plumbing*

Hillandale Farms
9715 Rosedale Road
Hicksville, OH. 43526

PEI Compliance Letter
Quote / Job: 516005

February 28, 2017

The Hillandale Farms facility located in Hicksville Ohio began construction in the fall of 2013 and all plumbing and water distribution lines were installed in accordance to Ohio building code 512. Prior to 2013 the site was bare with no wells or existing structures located on it.

There are no lead lines in the water distribution systems. New plastic was used in the construction of the existing water distribution systems, and will be used in the construction of any future water distribution systems. All new construction of water distribution lines have been installed per Ohio House Bill 512 which states the following. "Building in Ohio Built Prior to 1998 or that use plumbing material or solder manufactured before 1998 may have materials with greater than 8% lead and are at a higher risk of contributing lead to the drinking water than materials manufactured after 1998. In addition, buildings built and plumbing materials manufactured after 2014 were required to have less than 0.25% led by weight and have the lowest risk for contributing lead to the drinking water. It should be noted however that, although prohibited, some use of leaded solder or leaded components may have occurred after the prohibitions became effective."

We trust that we have interpreted your requirements accurately and that the letter contains all the information necessary for your evaluation. If additional data or clarification is required, please do not hesitate to call.

Sincerely,

Andy Gardner
Pranger Enterprises, Inc.

www.PrangerEnt.com
PO Box 366 Ashley, Indiana 46705
260.587.9309 FAX 260.587.9319
1.800.977.0029

DDAGW - NWD0

FEB 28 2017

RECEIVED



RECEIVED


FEB 28 2017

DDAGW - NWDO






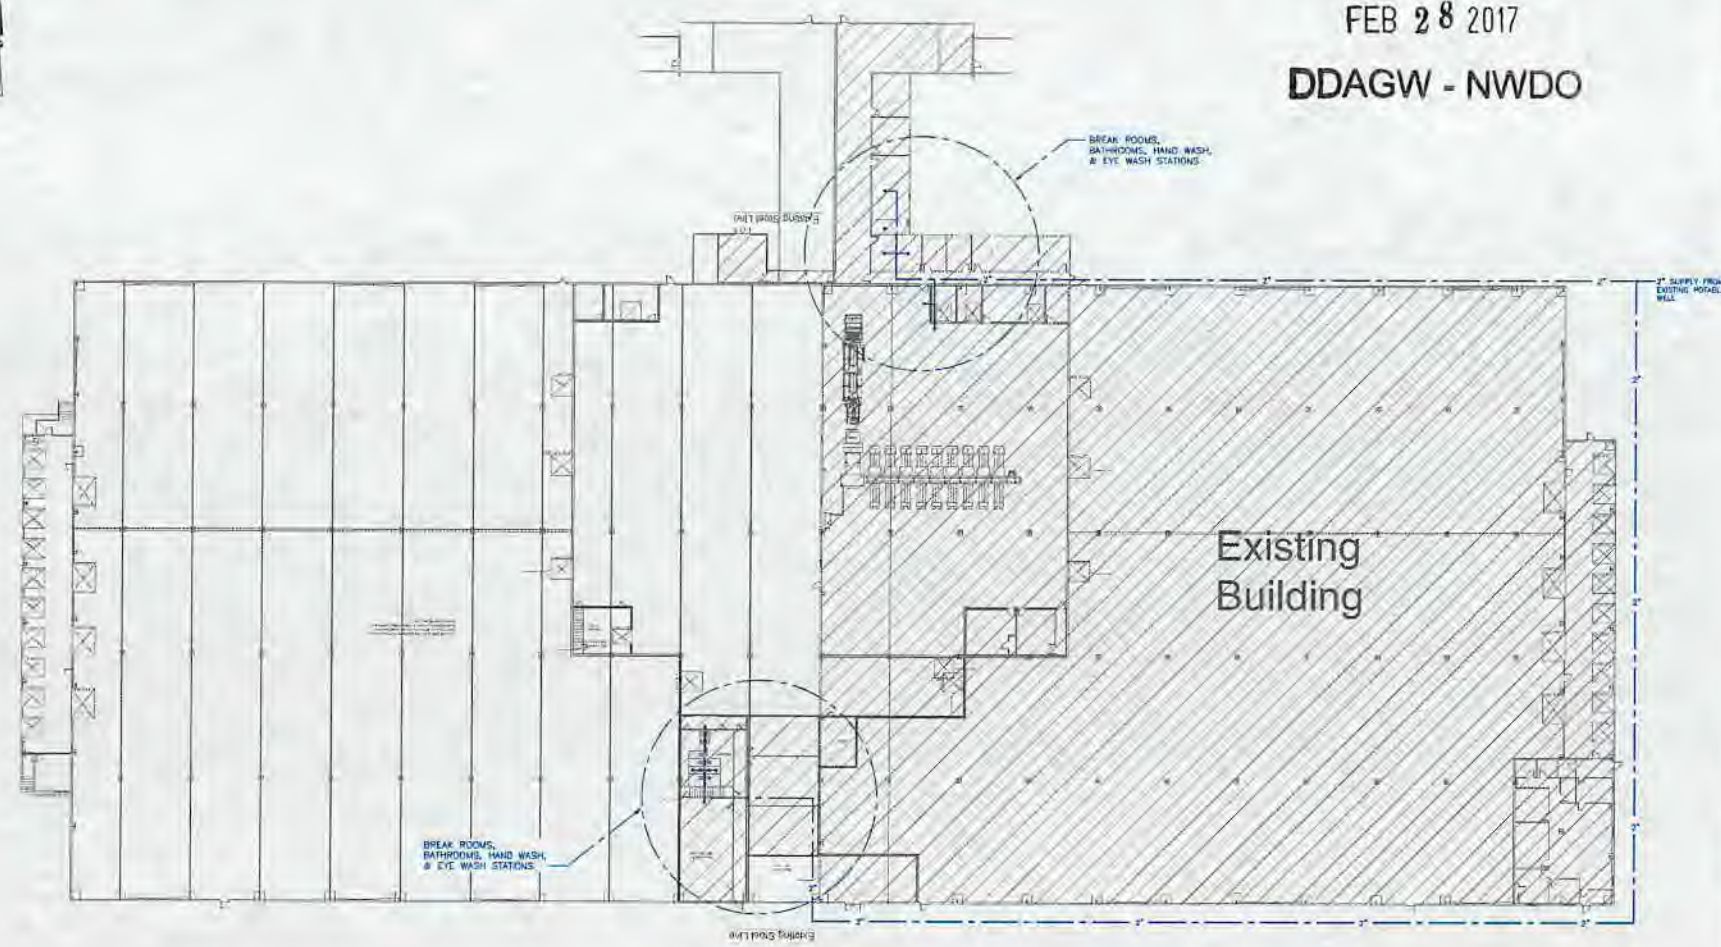

BREAK ROOMS,
BATHROOMS, HAND WASH
& EYE WASH STATIONS

BREAK ROOMS,
BATHROOMS, HAND WASH
& EYE WASH STATIONS

- 2) EXISTING POTABLE WELL
- FEEDS ALL BATHROOMS/BREAKROOMS
- S/E OFFICE, MAIN PLANT
- NEW SOUTH BATHROOM/BREAKROOM
- EXISTING NORTH BATHROOM/BREAKROOM
- MAINTENANCE SHOP
- FEED MILL

ENLARGED PLAN VIEW
- SOME EQUIPMENT REMOVED FOR CLARITY

HILLDALE
PROCESSING EXPANSION
HICKSVILLE, OH.

REV #	DATE	BY

DATE: 02/21/17
DRAWN BY: TAG
PROJECT NO: 510005

SCALE: 1" = 20'-0"
SHEET NO: P0.2
REV: 0

DRAWING STATUS:

REVISED DRAWING - VERIFY ALL OTHER COPIES

NOT FOR CONSTRUCTION - INFORMATION AND ESTIMATES ONLY

RELEASED FOR FABRICATION

RELEASED FOR INSTALLATION

DATE: 02/22/17