

RE: Sun Valley Campground
Report
Drinking Water Program
Allen County
PWS ID: OH0252212



LEAD SERVICE LINE MAP


SUN VALLEY FAMILY CAMPGROUND

9779 Faulkner Rd. - Harrod, Ohio

(419) 648-2235

PWS: OH0252212

Allen County

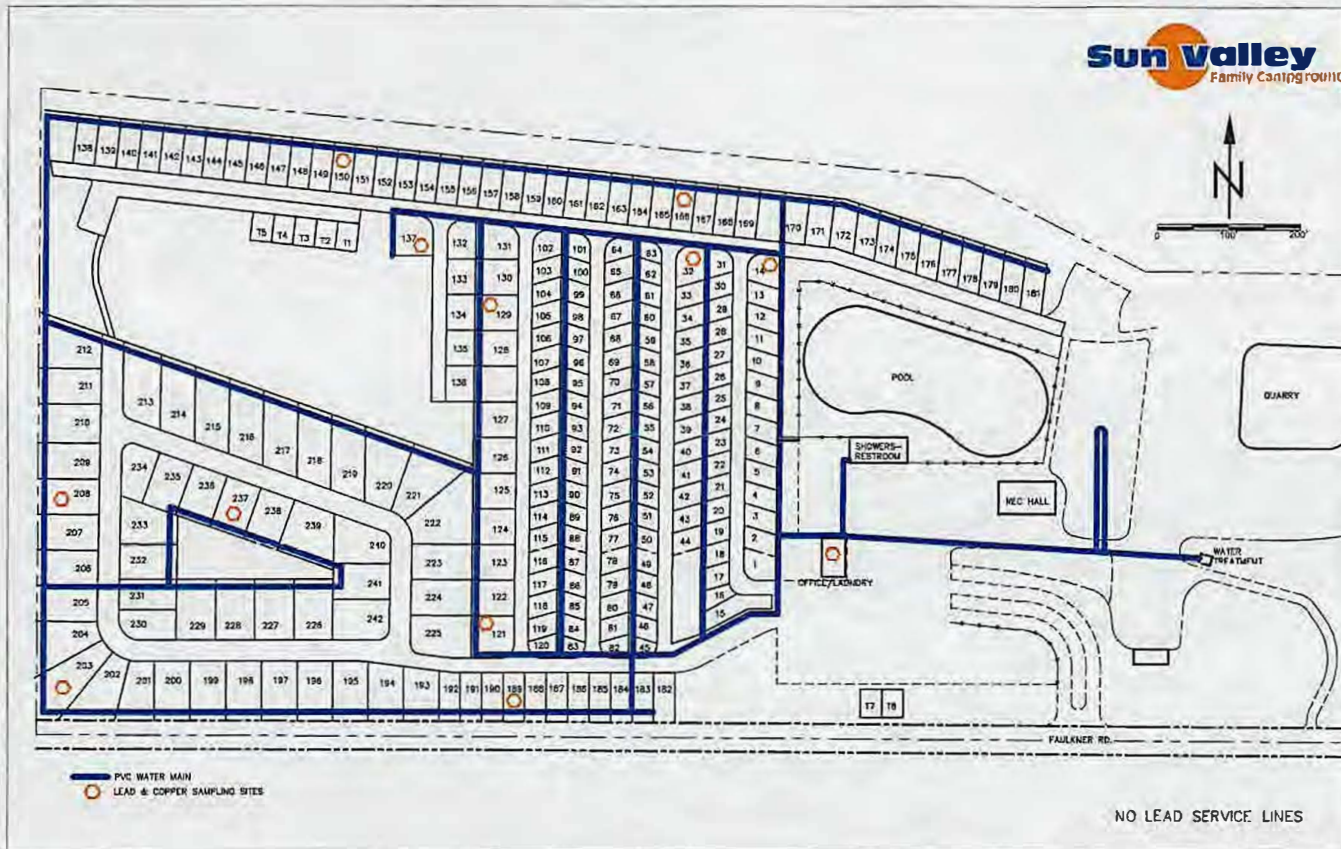

- 1.) The appropriate information has been reviewed and it has been determined that there are NO lead service lines in this water distribution system. All water mains and service lines were constructed after 1986 and it is known that all lines are constructed of PVC.
- 2.) It is required that all recreational vehicles are connected to this water system with hoses approved for potable water.
- 3.) Due to the transient nature of recreational vehicles, the RVs that are located on each campsite vary from time to time. They each vary in age and have different internal plumbing.
- 4.) Buildings in Ohio built prior to 1998 or that use plumbing material or solder manufactured before 1998 may have materials with greater than 8% lead and are at a higher risk of contributing lead to the drinking water than materials manufactured after 1998. In addition, buildings built and plumbing materials manufactured after 2014 were required to have less than 0.25% lead by weight and have the lowest risk for contributing lead to the drinking water. It should be noted however that, although prohibited, some use of leaded solder or leaded components may have occurred after the prohibitions became effective.

SAMPLE SITES FOR LEAD & COPPER MONITORING


In general, the recreational vehicles are newer than 1983, have plastic piping and do not meet the requirements for tier sampling. Also, with the transient and seasonal nature of camping, sites have been chosen that normally have RV's 12 months per year and that have brass faucets.

SMP ID	Tap Location
LC201	Bathroom
LC202	Bathroom
LC203	Bathroom
LC204	Bathroom
LC205	Bathroom
LC206	Bathroom
LC207	Bathroom
LC208	Bathroom
LC209	Bathroom
LC210	Bathroom
LC211	Bathroom

RECEIVED

FEB 28 2017

DDAGW - NWDO

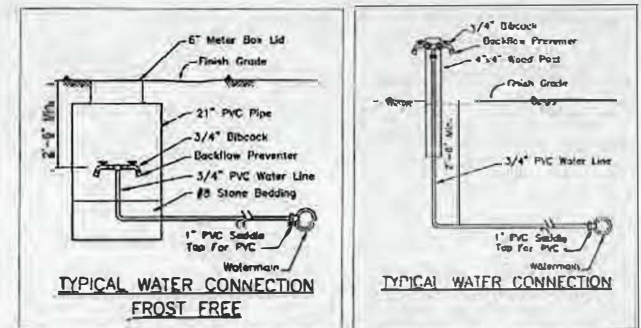

Contact JAMES WILLIAMS with questions at (419) 648-3601. February 24, 2017


**VERIFICATION FORM FOR COMMUNITY PUBLIC WATER SYSTEMS
CLAIMING NO LEAD SERVICE LINES**

The owner or operator of all community public water systems must identify and map areas of their distribution system that are known or are likely to contain lead service lines. Systems must submit a copy of the applicable map to the Ohio Department of Health and the Ohio Department of Job and Family Services. Systems must also submit a report to the director containing at least both of the following: (1) The applicable map with narrative, and (2) A list of sampling locations used to collect samples as required by Ohio Revised Code (ORC) Section 6109.121 and any rules adopted thereunder, including contact information for the owner and occupant of each sampling site.

Should a water system determine no lead service lines exist in their distribution system, they must provide information stating they reviewed, at the minimum, historical permit records and local ordinances, distribution maintenance records and information pertaining to installation dates or materials for all services lines. This information must be verified below.

I HEREBY CERTIFY THAT THE FOLLOWING METHOD(S) WERE USED TO DETERMINE NO LEAD SERVICE LINES EXIST IN THIS WATER SYSTEM'S DISTRIBUTION SYSTEM, AS REQUIRED BY ORC 6109.121(F):

LEAD SERVICE LINE VERIFICATION	
<p>This PWS states they have no lead service lines and has reviewed the following information (select one or more of the following):</p> <ul style="list-style-type: none"> <input type="checkbox"/> Historical permit records and/or local ordinances <input type="checkbox"/> Distribution maintenance records (i.e. meter replacement, waterline break repairs) <input checked="" type="checkbox"/> Information pertaining to installation dates for all service lines (i.e. after 1986 when lead services lines were banned) <input checked="" type="checkbox"/> Service line material of all service lines is known (i.e. all service lines are known to be PVC) 	

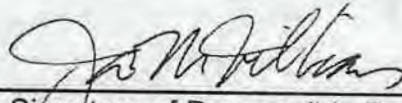
 Signature of Responsible Person _____ Date 2/24/17
 James M. Williams -- operator of record - owner
 Printed Name and Title of Responsible Person _____

Sun Valley
PWS NAME: Family Campground
PWS ID: OH 0252212
COUNTY: Allen

<p>For Ohio EPA use only:</p> <p>Date Verification Rec'd: _____</p>
--

RECEIVED
 FEB 28 2017
 DDAGW - NWDO