

RE: Kalmbach Feeds
Report
Drinking Water Program
Wyandot County
PWS ID: OH8840812

KALMBACH FEEDS, INC.

7148 State Hwy 199, Upper Sandusky, OH 43351

PHONE: 419-294-3838 FAX: 419-294-4350 www.kalmbachfeeds.com

February 27, 2017

Ohio Environmental Protection Agency
Northwest District Office
347 North Dunbridge Road
Bowling Green, OH 43402

RECEIVED

FEB 28 2017


OHIO E.P.A.
N.W.D.O.

SUBJECT: OHIO HOUSE BILL 512 - LEAD SERVICE LINE AND FIXTURE MAPPING PROJECT.

The included map displays the public water system layout for Kalmbach Feeds, as required per Ohio House Bill 512.

Please contact me if you need additional information. I can be reached at 419-294-3838 ext. 1863.

Sincerely,
Kalmbach Feeds, Inc.

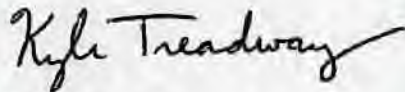

Kyle Treadway
Safety & Environmental Coordinator



KALMBACH FEEDS PUBLIC WATER SYSTEM (PWS) MAP


RAILROAD

RAILROAD

RAILROAD




WELL HEAD

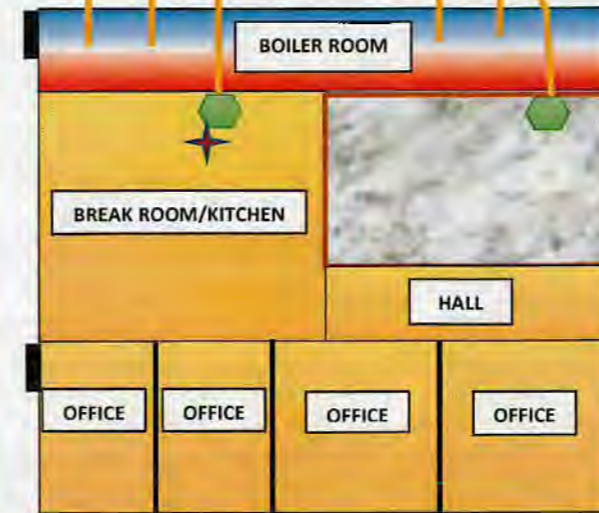

RECEIVED
FEB 27 2017
DDAGW - N.W.D.O.

PLANT

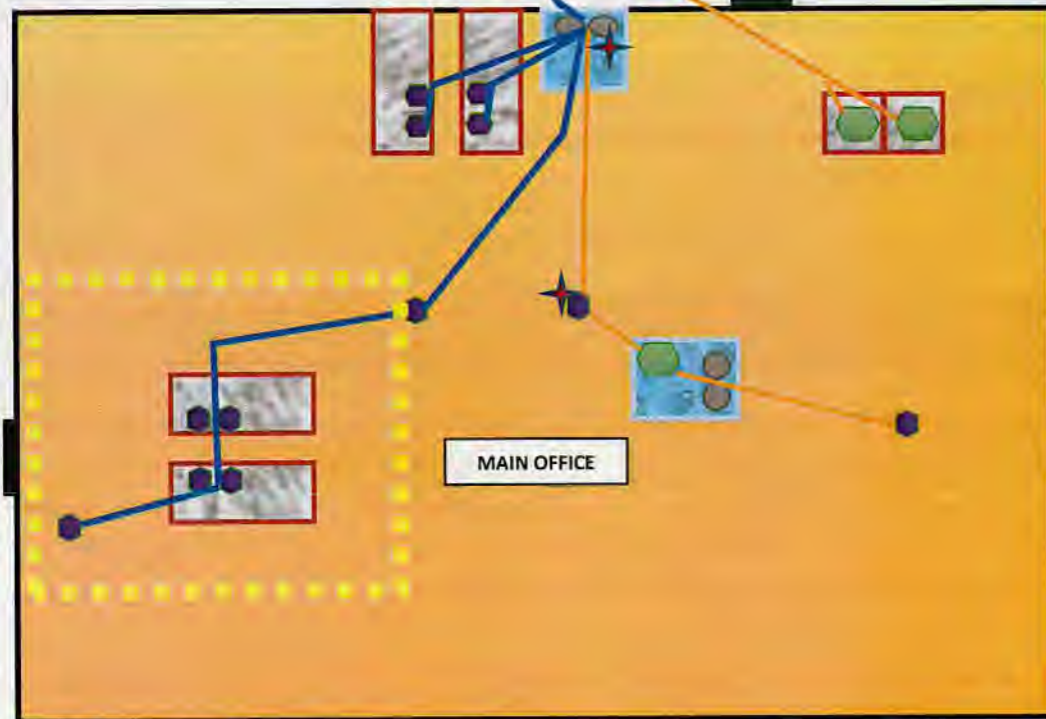

MAIN ENTRANCE

GENERAL NOTES: PWS INSTALLED IN 1976 EXCEPT FOR 2016 AREA DENOTED INSIDE YELLOW DOTTED BOX. THERE ARE NO KNOWN LEAD PIPES INSTALLED IN THE PWS. LEAD SOLDERING ON COPPER PIPE/FITTING COMPONENTS MAY HAVE OCCURRED DURING INSTALLATION.

LEGEND



- Sink with copper pipe lines/fittings
- Well head
- Sink with plastic pipe lines/fittings
- Restroom
- Boiler and R/O equipment area
- Hot water heater/softener tank area
- Plastic
- Copper
- LCR sample locations

RECEIVED
FEB 28 2017
OHIO E.P.A.
N.W.D.O.

STATE ROUTE 199

Facility: Kalmbach Feeds, Inc.
Address: 7148 State Highway 199, Upper Sandusky, OH 43351
Telephone # 419-294-3838
PWS ID# OH8840812