


RE: Payne Village  
Report  
Drinking Water Program  
Paulding County  
PWS ID: OH6300712

# PAYNE, OHIO

WATER MAP


OH 6300712

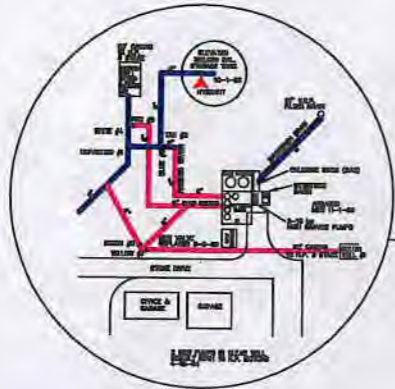

## LEGEND

- 8" WATER MAIN
- 6" WATER MAIN
- 4" WATER MAIN
- 3" WATER MAIN OR LESS
- ▲ FIRE HYDRANT
- + MAIN LINE VALVE

SCALE APPROXIMATELY 1" = 300'

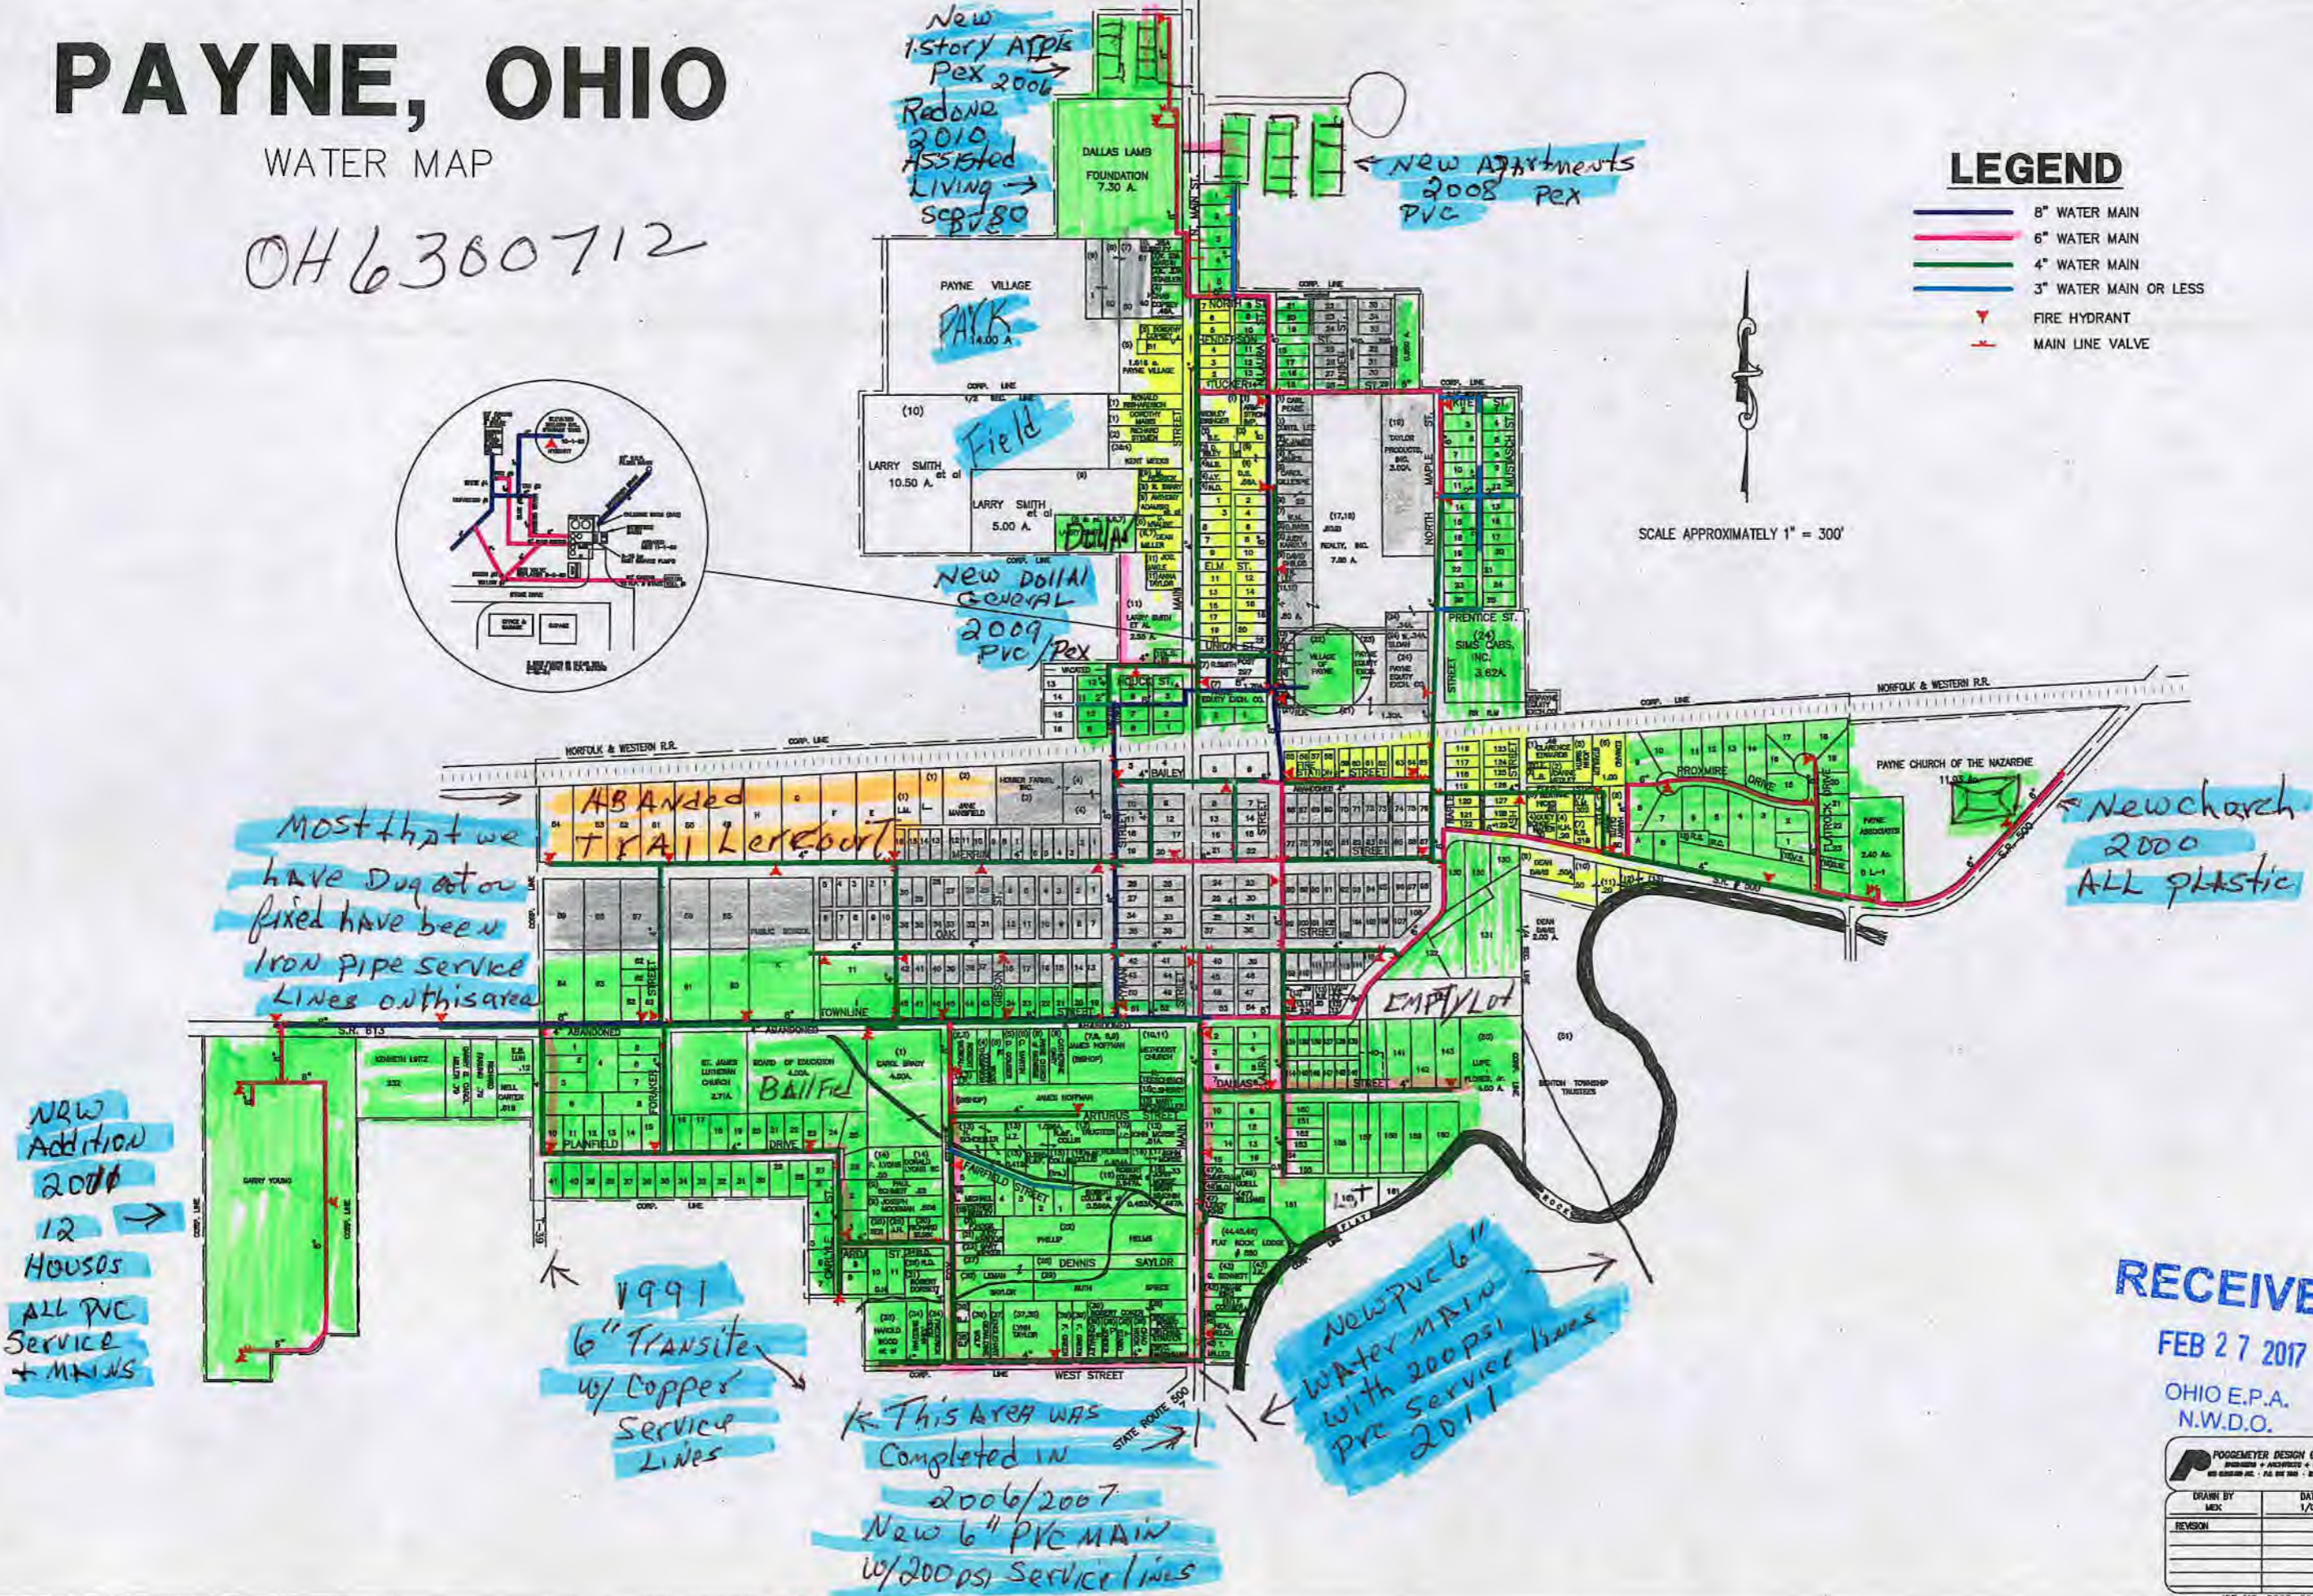

Most that we have dug out or fixed have been Iron pipe service lines on this area

NRW Addition 2000 12 HOUSES ALL PVC SERVICE + MAINS

1991 6" Transite w/ Copper Service Lines

This Area was Completed in 2006/2007 New 6" PVC MAIN w/ 200 PSI Service Lines

New PVC 6" Water Main with 200 PSI Pre Service Lines 2011

New church 2000 ALL PLASTIC

RECEIVED

FEB 27 2017


OHIO E.P.A. N.W.D.O.

DRAWN BY MEK	DATE 1/02
REVISION	

# PAYNE, OHIO

WATER MAP

046300712

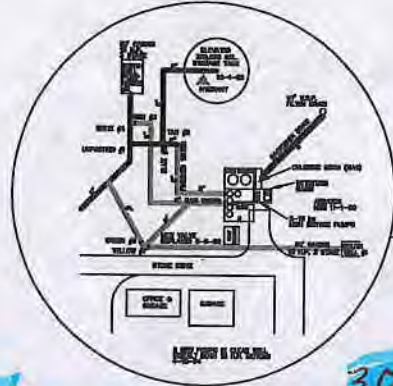


## LEGEND

- 8" WATER MAIN
- 6" WATER MAIN
- 4" WATER MAIN
- 3" WATER MAIN OR LESS
- FIRE HYDRANT
- MAIN LINE VALVE

N

SCALE APPROXIMATELY 1" = 300'

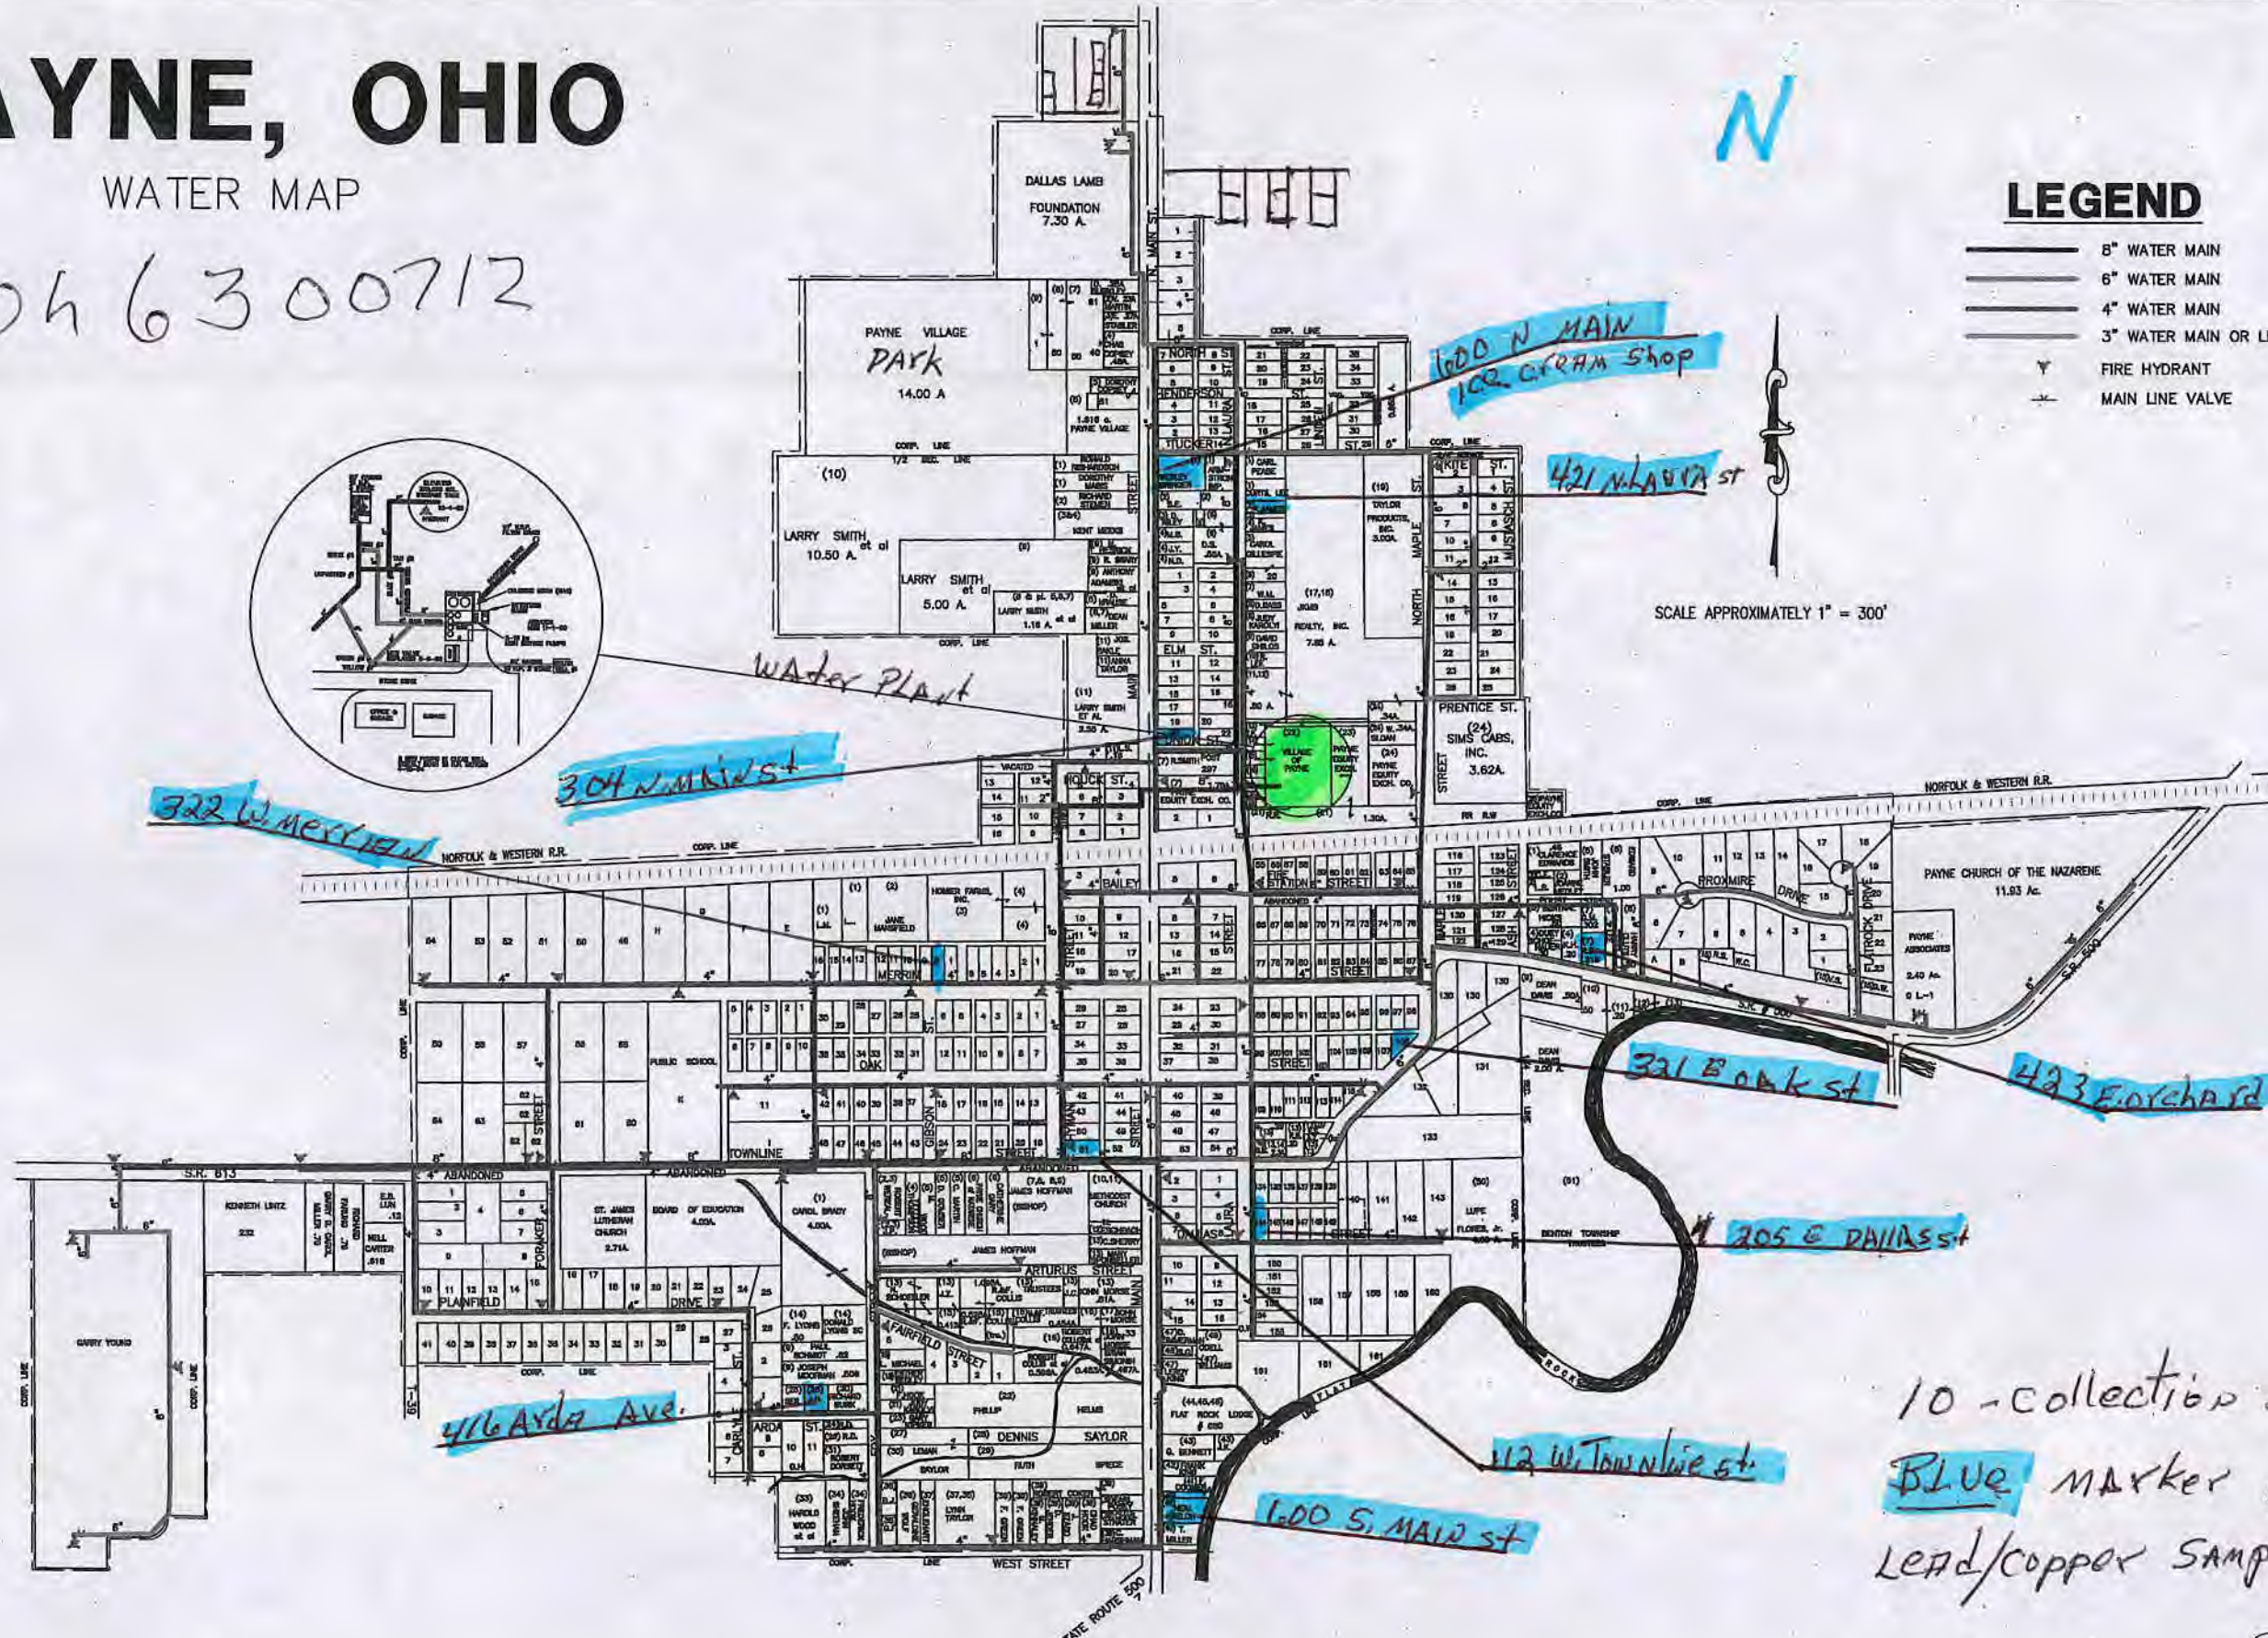

10 - collection sites  
BLUE marker indicates  
 LEAD/COPPER SAMPLING SITES

DRAWN BY	DATE
MEX	1/02
REVISION	