


Entity: Biery Cheese
 Doc Type: Report
 Doc Subtype:
 Program: DDANW
 County: Stearns
 Secondary ID: 017659812
 xDC in ead

RECEIVED
 JAN 16 2017

BY:

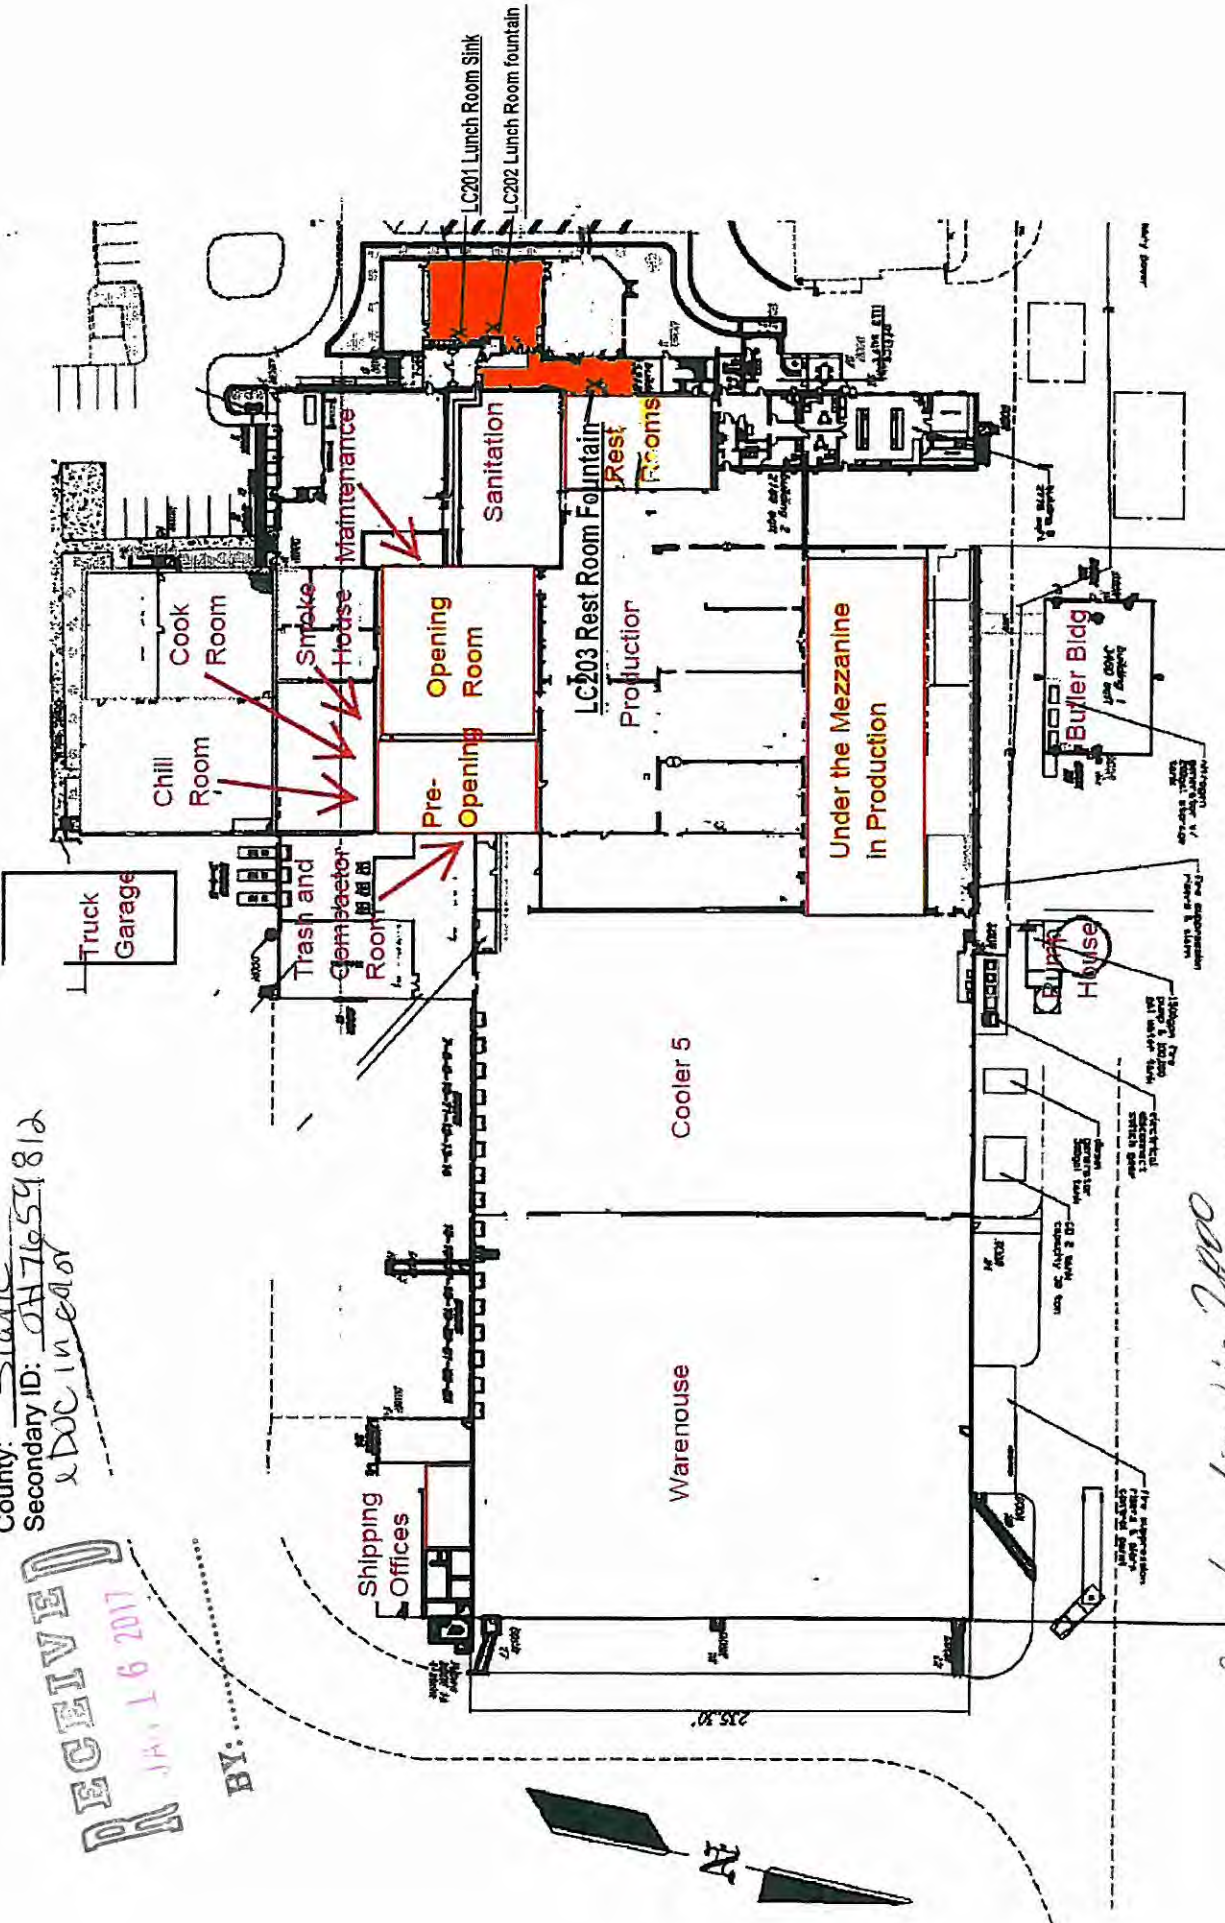

Construction in 2000

Biery Cheese 1st. floor LC tests sites.


017659812

Orange indicates test sites
 All plumbing is copper

MIKE SALVINO

RECEIVED
JAN 16 2017

BY:

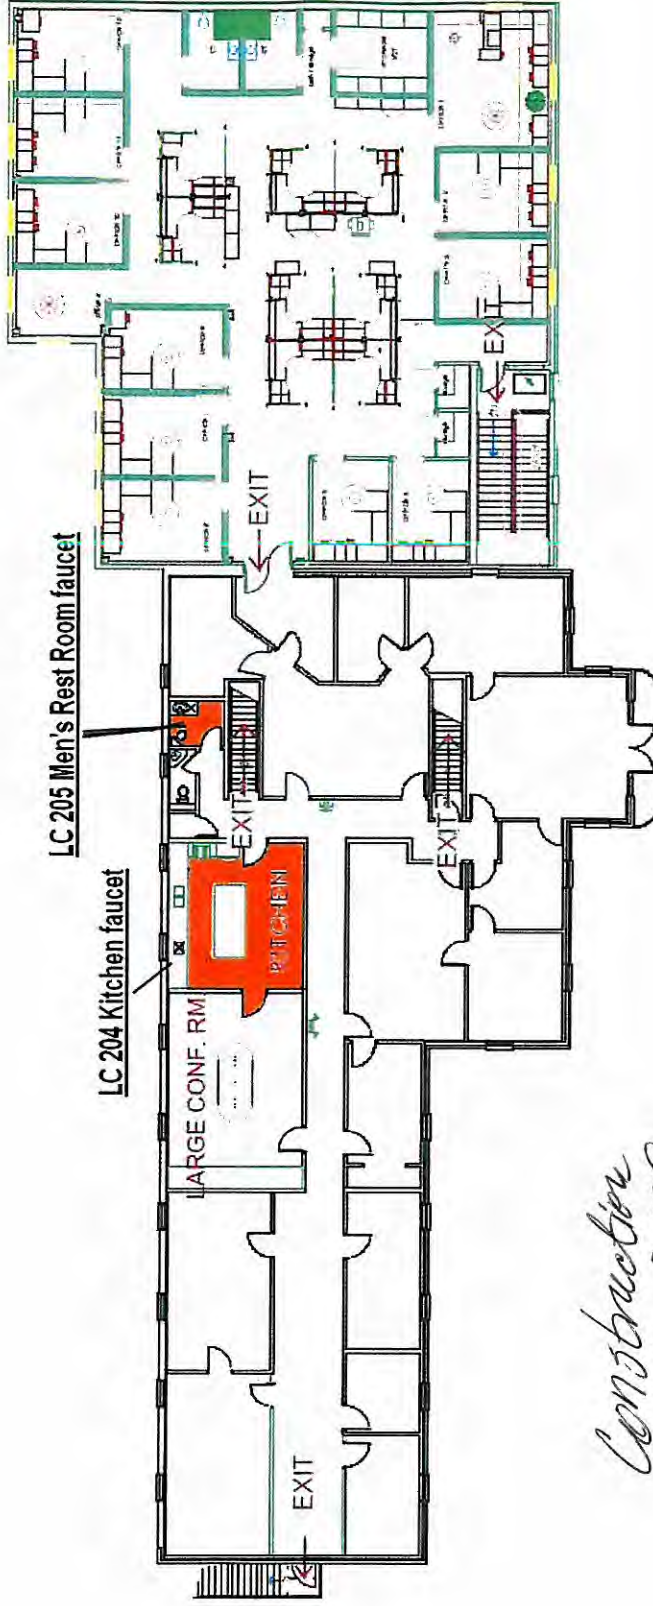

Construction in 2000

Biery Cheese - 2nd Floor
Orange indicates LC test sites.
All plumbing is copper

0117659812