


Lead Service Line & Mapping Project

1st Lebar Apts. Public Water System

NS ID# OH7606922

Entity: 1st Lebar Apts. Public Water
Doc Type: REPORT
Doc Subtype:
Program: DRINK
County: STARK
Secondary ID: OH7606922
2 PDL in color

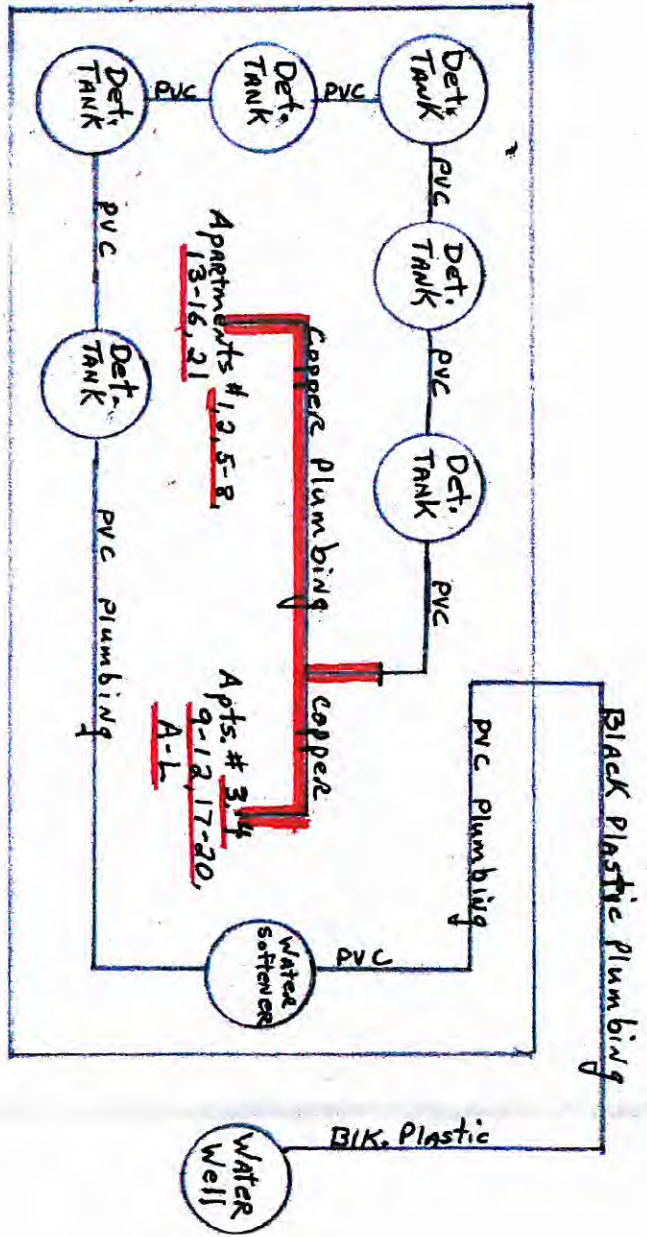

Because it is practically impossible to determine the lead content of an installed fixture, fitting or pipe, it should be assumed that the manufacture or installation date is the primary indicator of the lead content. Therefore, the characteristics of buildings and piping solder or fixtures would be buildings built prior to 1988 or that use plumbing material or solder manufactured before 1988 may have materials with greater than 8% lead and are at a higher risk of contributing lead to the drinking water than materials manufactured after 1988. In addition, buildings built and plumbing materials manufactured after 2014 were required to have less than 0.2% lead by weight and have the lowest risk for contributing lead to the drinking water. It should be noted however that, although prohibited, some use of leaded solder or leaded components may have occurred after the prohibitions became effective.

RECEIVED
JAN 08 2017

BY:

Orange Highlighted Areas indicate Copper plumbing installed prior to 1988.