

Western Guernsey Regional Water
61786 Shaw Road
Cambridge Ohio 43725
PWS ID # 3001103

Western Guernsey Regional Water does not own or operate the source and treatment of our water supply. We buy treated water from the City of Cambridge and resell to our customers. This classifies us as a Purchased Surface Water System. We began in 1973 with 200 customers and now have 1150 customers.

We read our customers meters monthly, (meters are in pits) and have not found any lead lines on our side or customer side. I know we have nothing but plastic in our system and have never found anything other, on customers side. When lead testing began we surveyed our system for lead and could not find any. I believe our system is lead free.

9017 FEB 13 AM 8:11

8/1/13

WESTERN GUERNSEY REGIONAL WATER DISTRICT

61786 Shaw Road
Cambridge, Ohio 43725

740-432-7298

Fax 740-435-8008

email: westernguernseyregionalwater@gmail.com


March 1, 2017

REF: 30-01103

To whom it may concern:

Attached is the led pipe mapping that has been requested. If you have any questions, please don't hesitate to contact me.

Thank you,

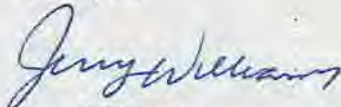

Jerry Williams
Office Manager

Guernsey County, Ohio

PLAT BOOK

including:
 county highway map
 index of landowners
 city street maps


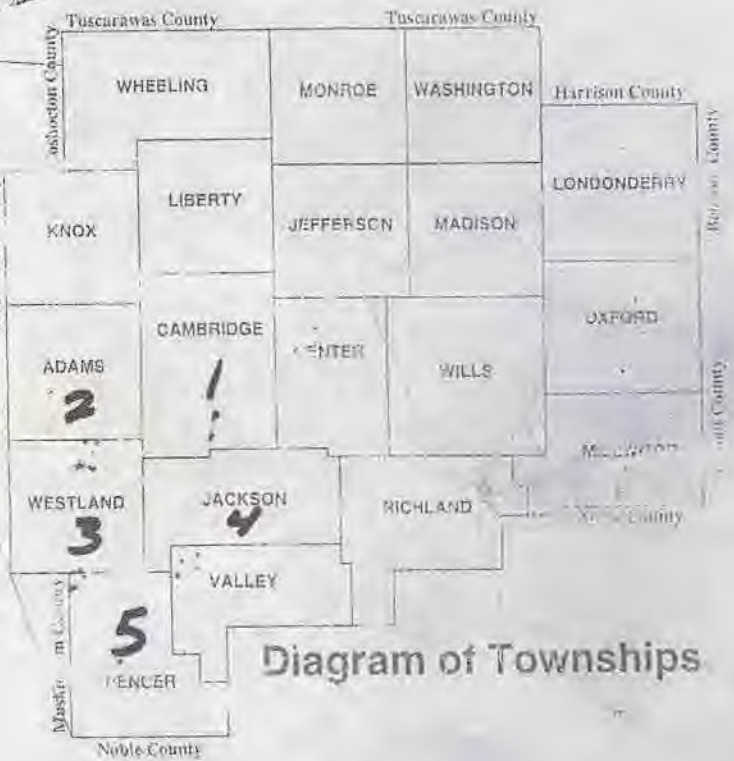


Diagram of Townships


Sponsored by:

Cambridge Area Chamber of Commerce
 918 Wheeling Ave
 Cambridge, OH 43725
 614-439-6688

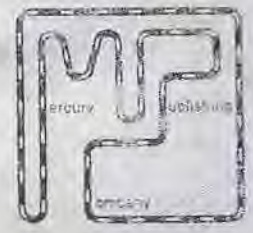

Red = SP2 21

21

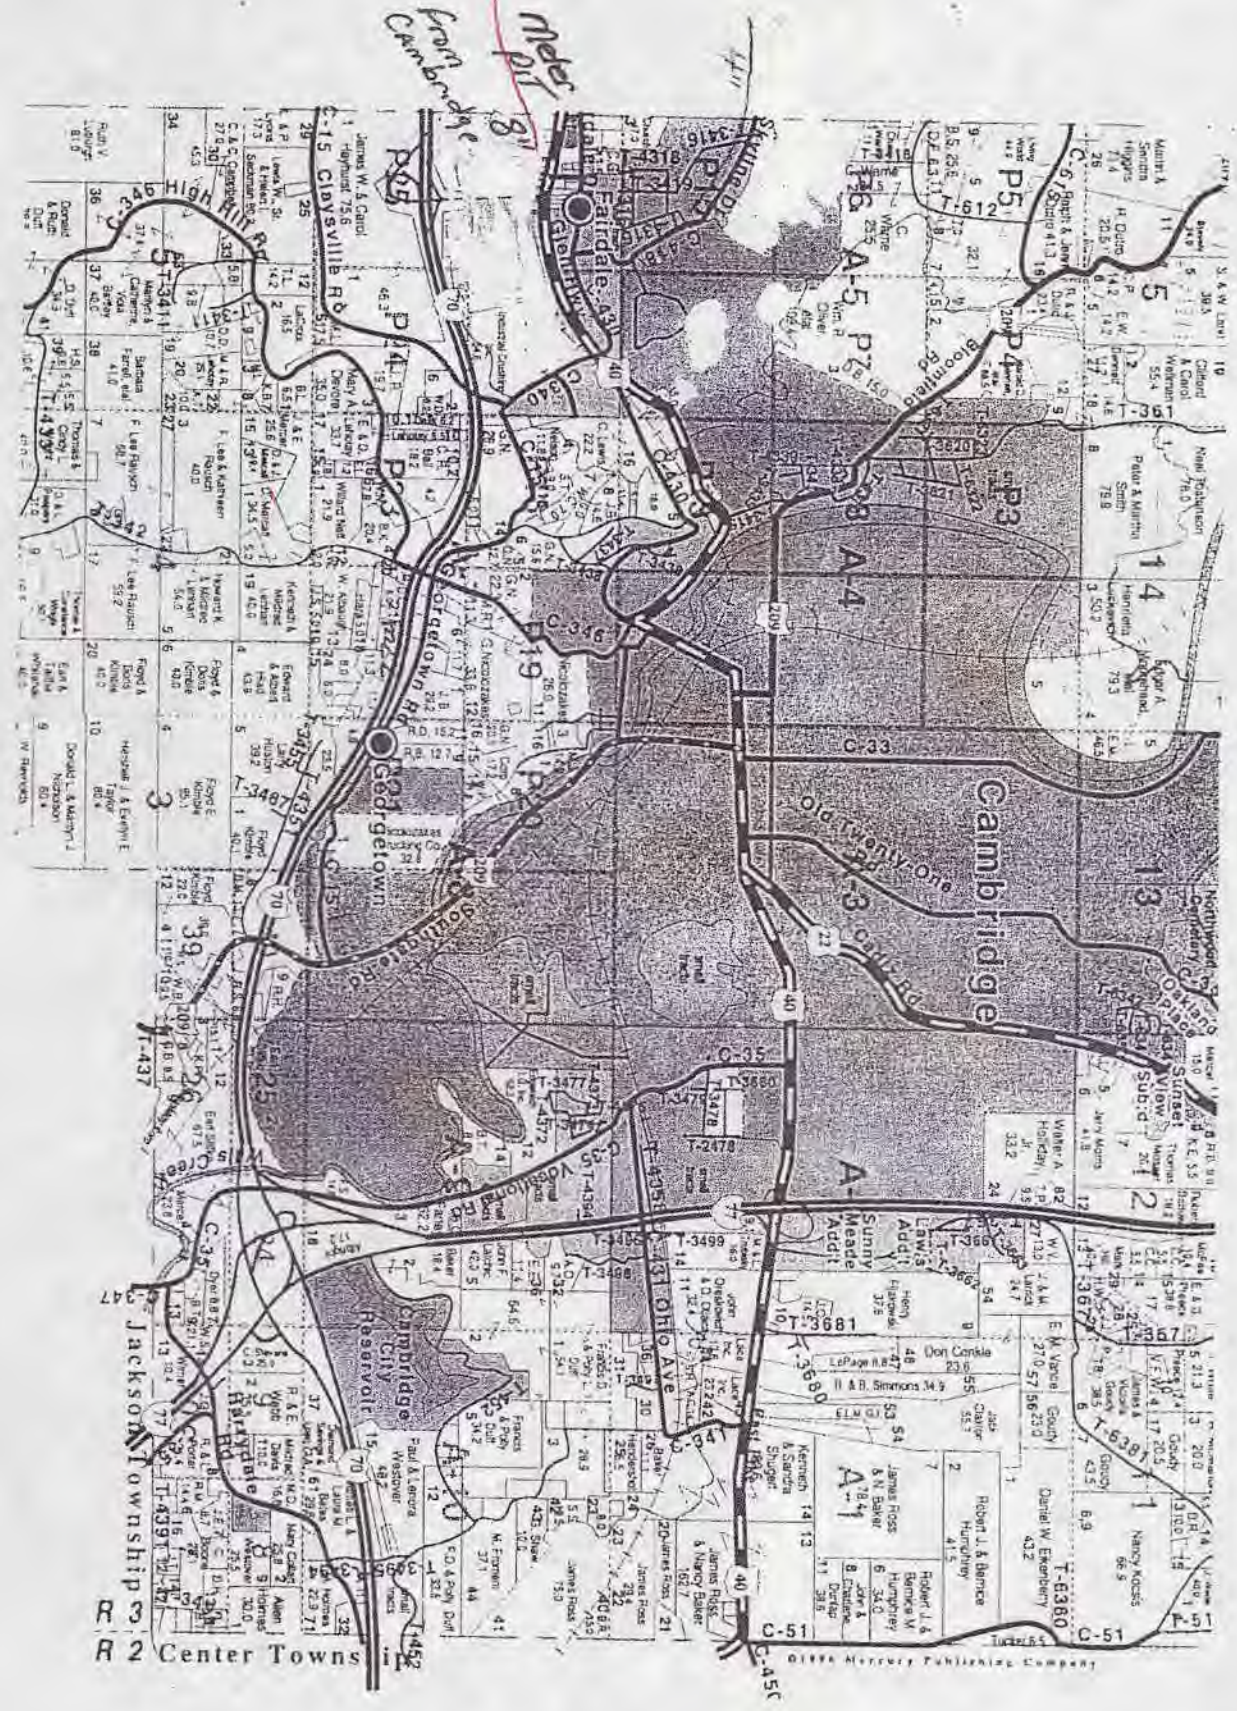

R 3
R 2 Center Towns

Red = SAR 21

Knox Township

Blue = 8" HDPE

2


Muskingum County

County



TOWN

T-21

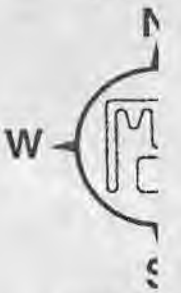

ADAMS



Cambridge Township

Cambridge Township

Water from Cambridge meter pit

18" HDPE

Shagog TANK

RT40 Booster

Ridgewood Acres Sub'd

Adams Booster

Burneys Sub'd

C-416 Peters Creek Rd

C-164 Hill Rd

C-418 Skyline Dr

Peters Creek Rd

C-416

LC 207

LC 207

LC 206

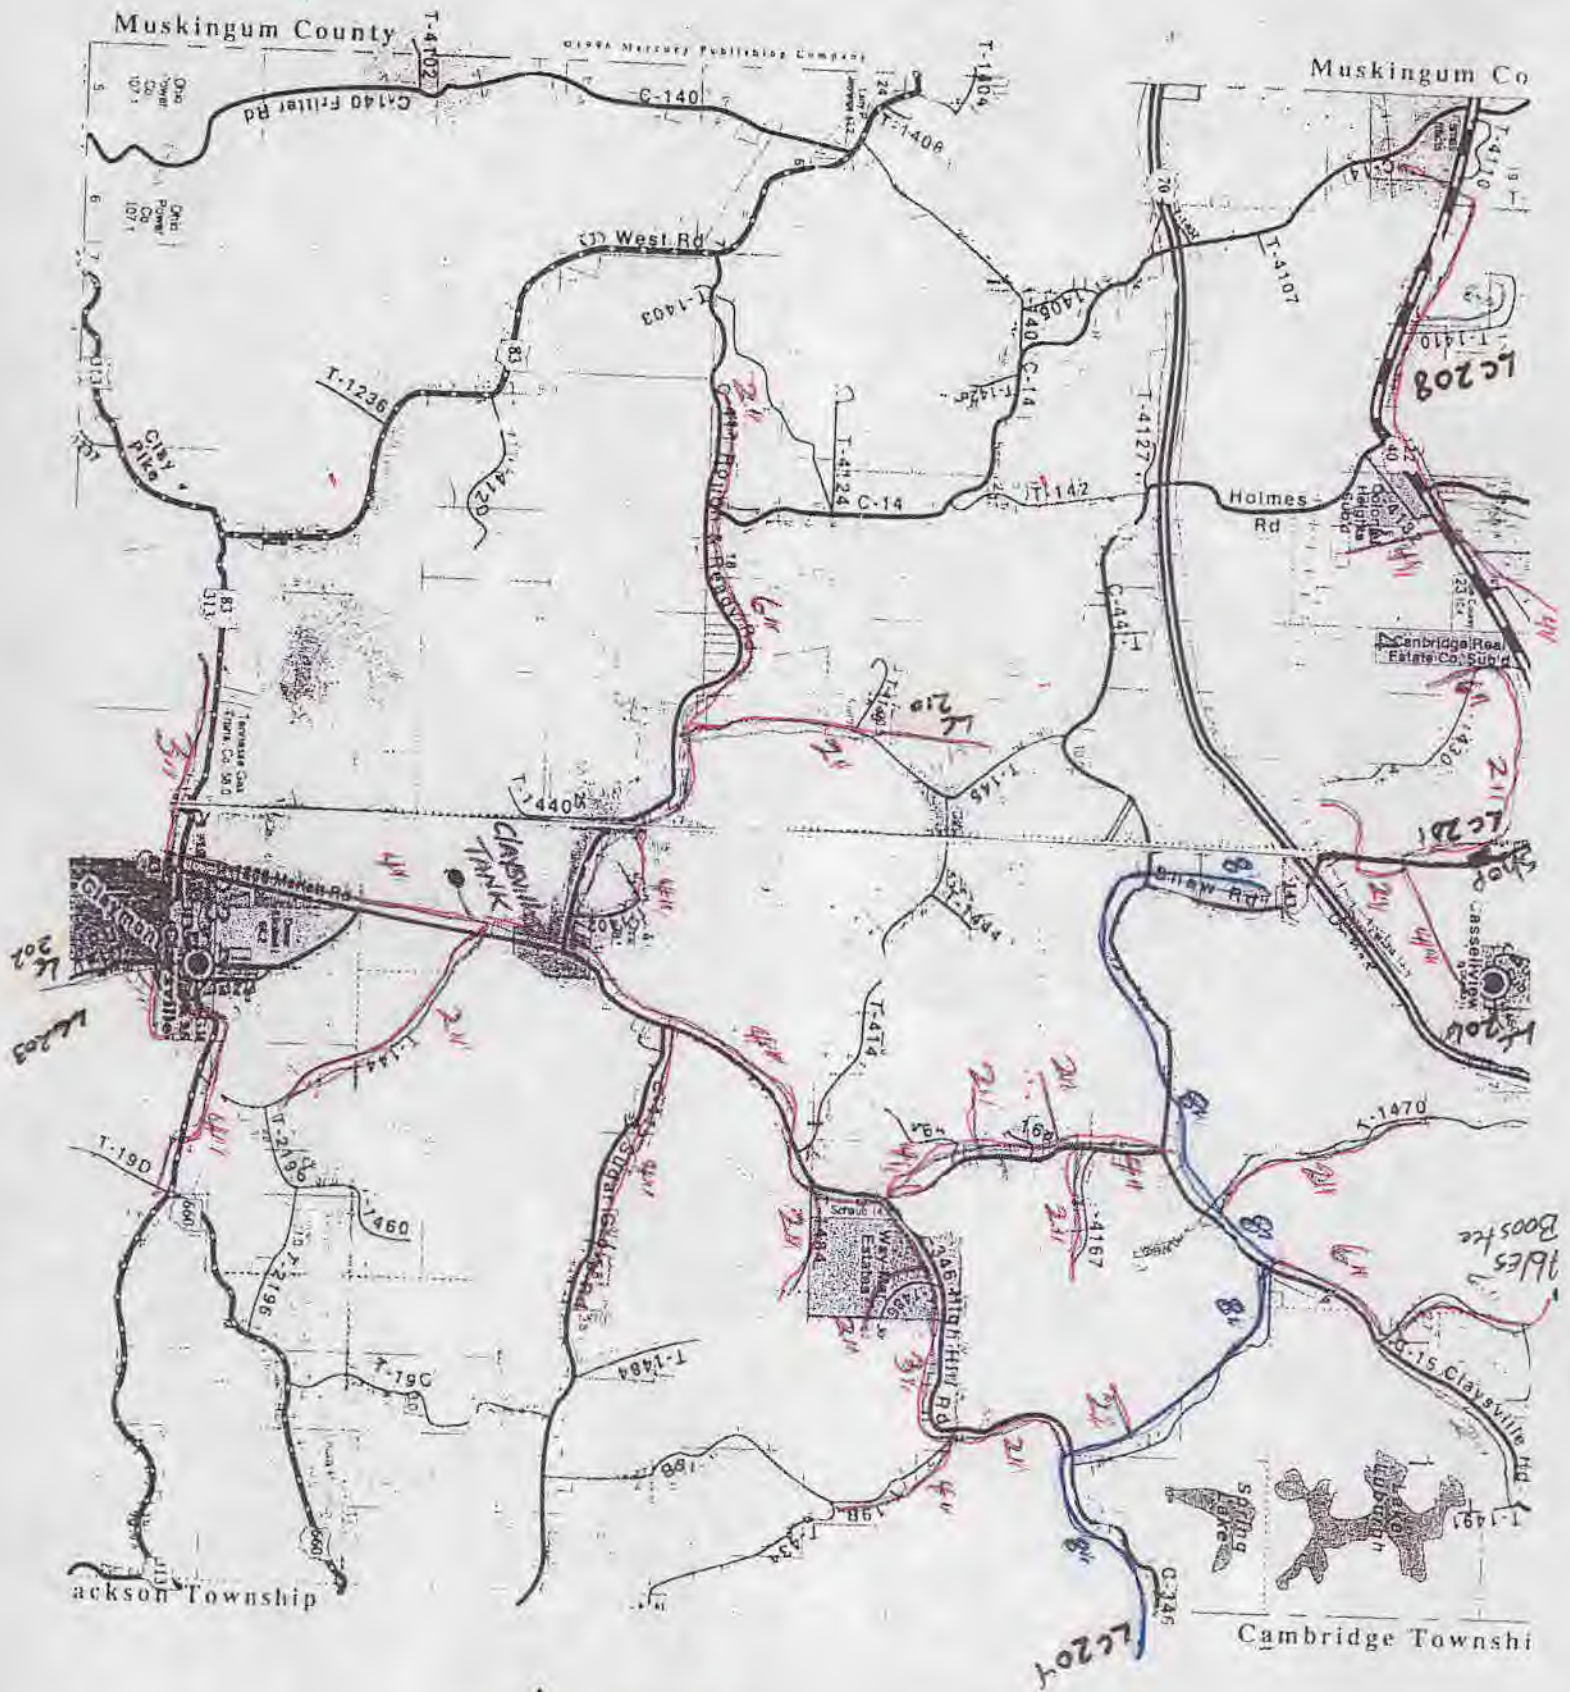

3

Red = SDR 21
 Blue 8+ HDPE

WEST TOWN T-11

WESTLAND T

Muskingum Co

Muskingum County


Cambridge Townshi

ackson Township

Red = SDR 21
Blue = HDPE 8"

JACKSON TOWNSHIP

T-8-9 / R-2-3

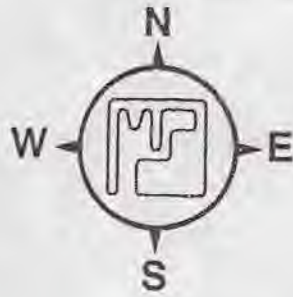

NOTICE: Let it be known this publication has been prepared as a reference guide to property ownership. The data contained herein has been compiled from the official city, state and county public records. Due to the constant sale and transfer of property it is impossible to guarantee 100% accuracy. We believe that this information is correct and current, however it is not intended for any legal use, whether it be in sales, transfers, trades, leases of any type, etc., and do not accept responsibility for errors of any nature or omissions contained herein.



