



659 Pearl Street  
Middleport, OH 45760

February 28, 2017

Ohio EPA Southeast District Office  
2195 Front Street  
Logan, Ohio 43138-8637

RE: Lead Mapping Report

cc: DDAGW, Eric Hart; Ohio Department of Health; Ohio Department of Job and Family Services

To whom it may concern,

The Village of Middleport has completed the required detailed map. This map does indicate areas that lead services are likely supplying residences and businesses. The Village of Middleport has made it a policy that when lead is found to remove it from the main to the meter pit. We also do notify the customer of our findings. Though there are many areas that do not have lead due to newer construction, the majority of structures in Middleport are tier one sites. With that being, said the possibility of lead soldered joints in copper plumbing is highly likely. I have also attached our sample monitoring point locations also. If you have any further questions or concerns feel free to contact me at the information given below.

Sincerely,


Joe Woodall

Village of Middleport Administrator

659 Pearl Street

Middleport, OH 45760

Phone: 740-508-0927 email: joseph.woodall@rocketmail.com

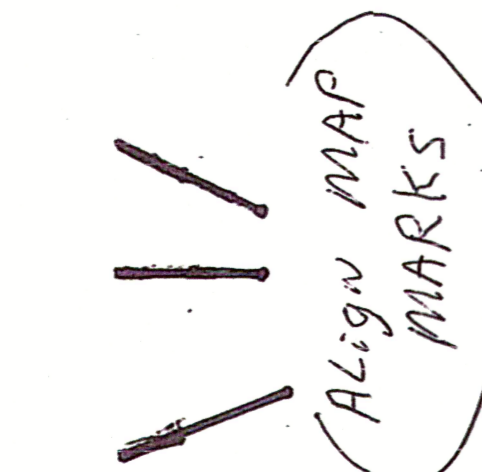

**FLOYD BROWNE ASSOCIATES, Limited**  
CONSULTING ENGINEERS - PLANNERS  
MARION, OHIO

4" EXISTING WATER LINE  
EXISTING HYDRANT  
EXISTING VALVE

High Risk for Lead -   
Low Risk for Lead - No Outline  
Lead and Copper SMPs -

Legend

CORPORATION LIMIT  
(INDEFINITE)

CORPORATION LIMIT  
(INDEFINITE)

