

# COUNTRY LAWN NURSING HOME & SPERET HALL

### EMERGENCY FACILITIES LOCATIONS

- Fire Extinguisher
- Call Box
- ✕ Exit

LC 205  



ROUTE 62 →

LC 20A  
S.H. WOMEN RR

LC 201  
KITCHEN  
FRYER SINK

LC 202  
320 R.R.

LC 203  
430 HANDSINK

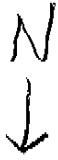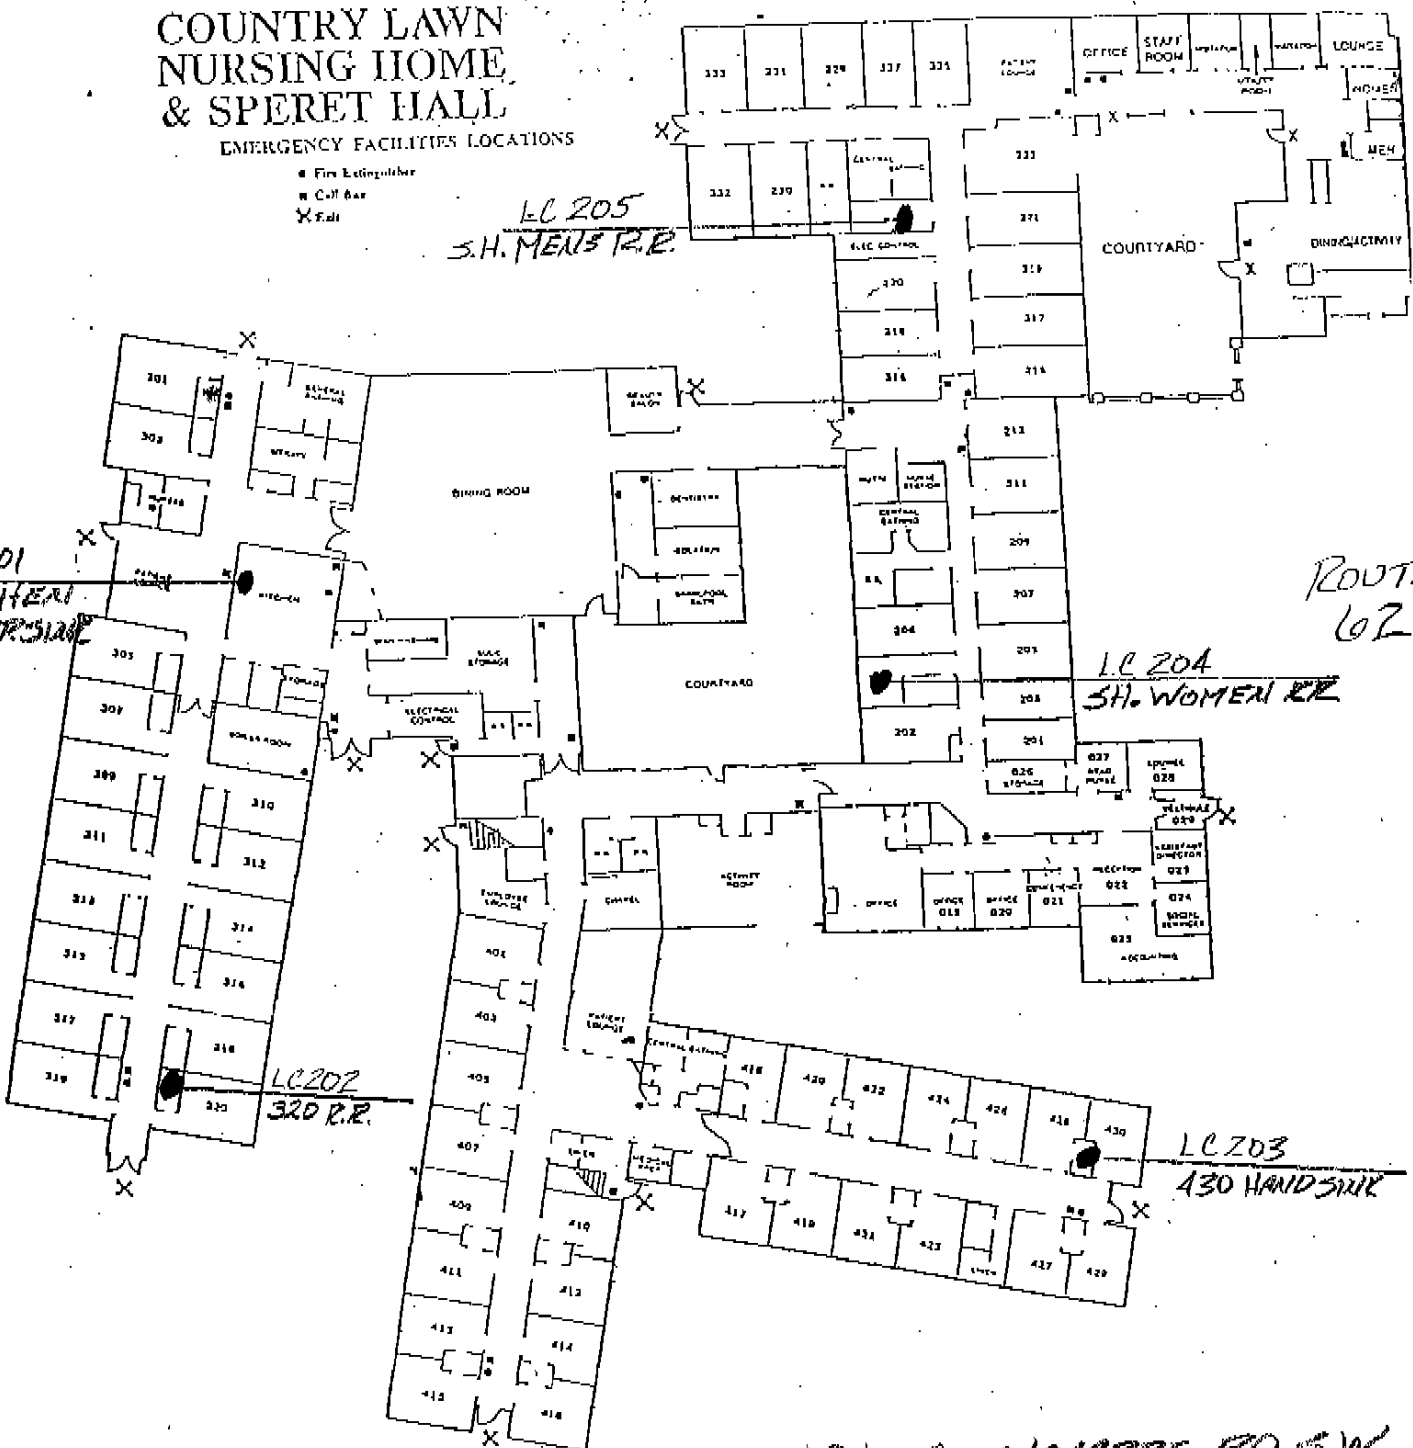

10608 NAVARRE RD. S.W.  
NAVARRE, OH. 44662

PWS # OH7601412