


COLUMBIA PARK

7100 COLUMBIA ROAD • CLMSTED TOWNSHIP, OHIO 44138

*Distribution System
Lead Mapping*

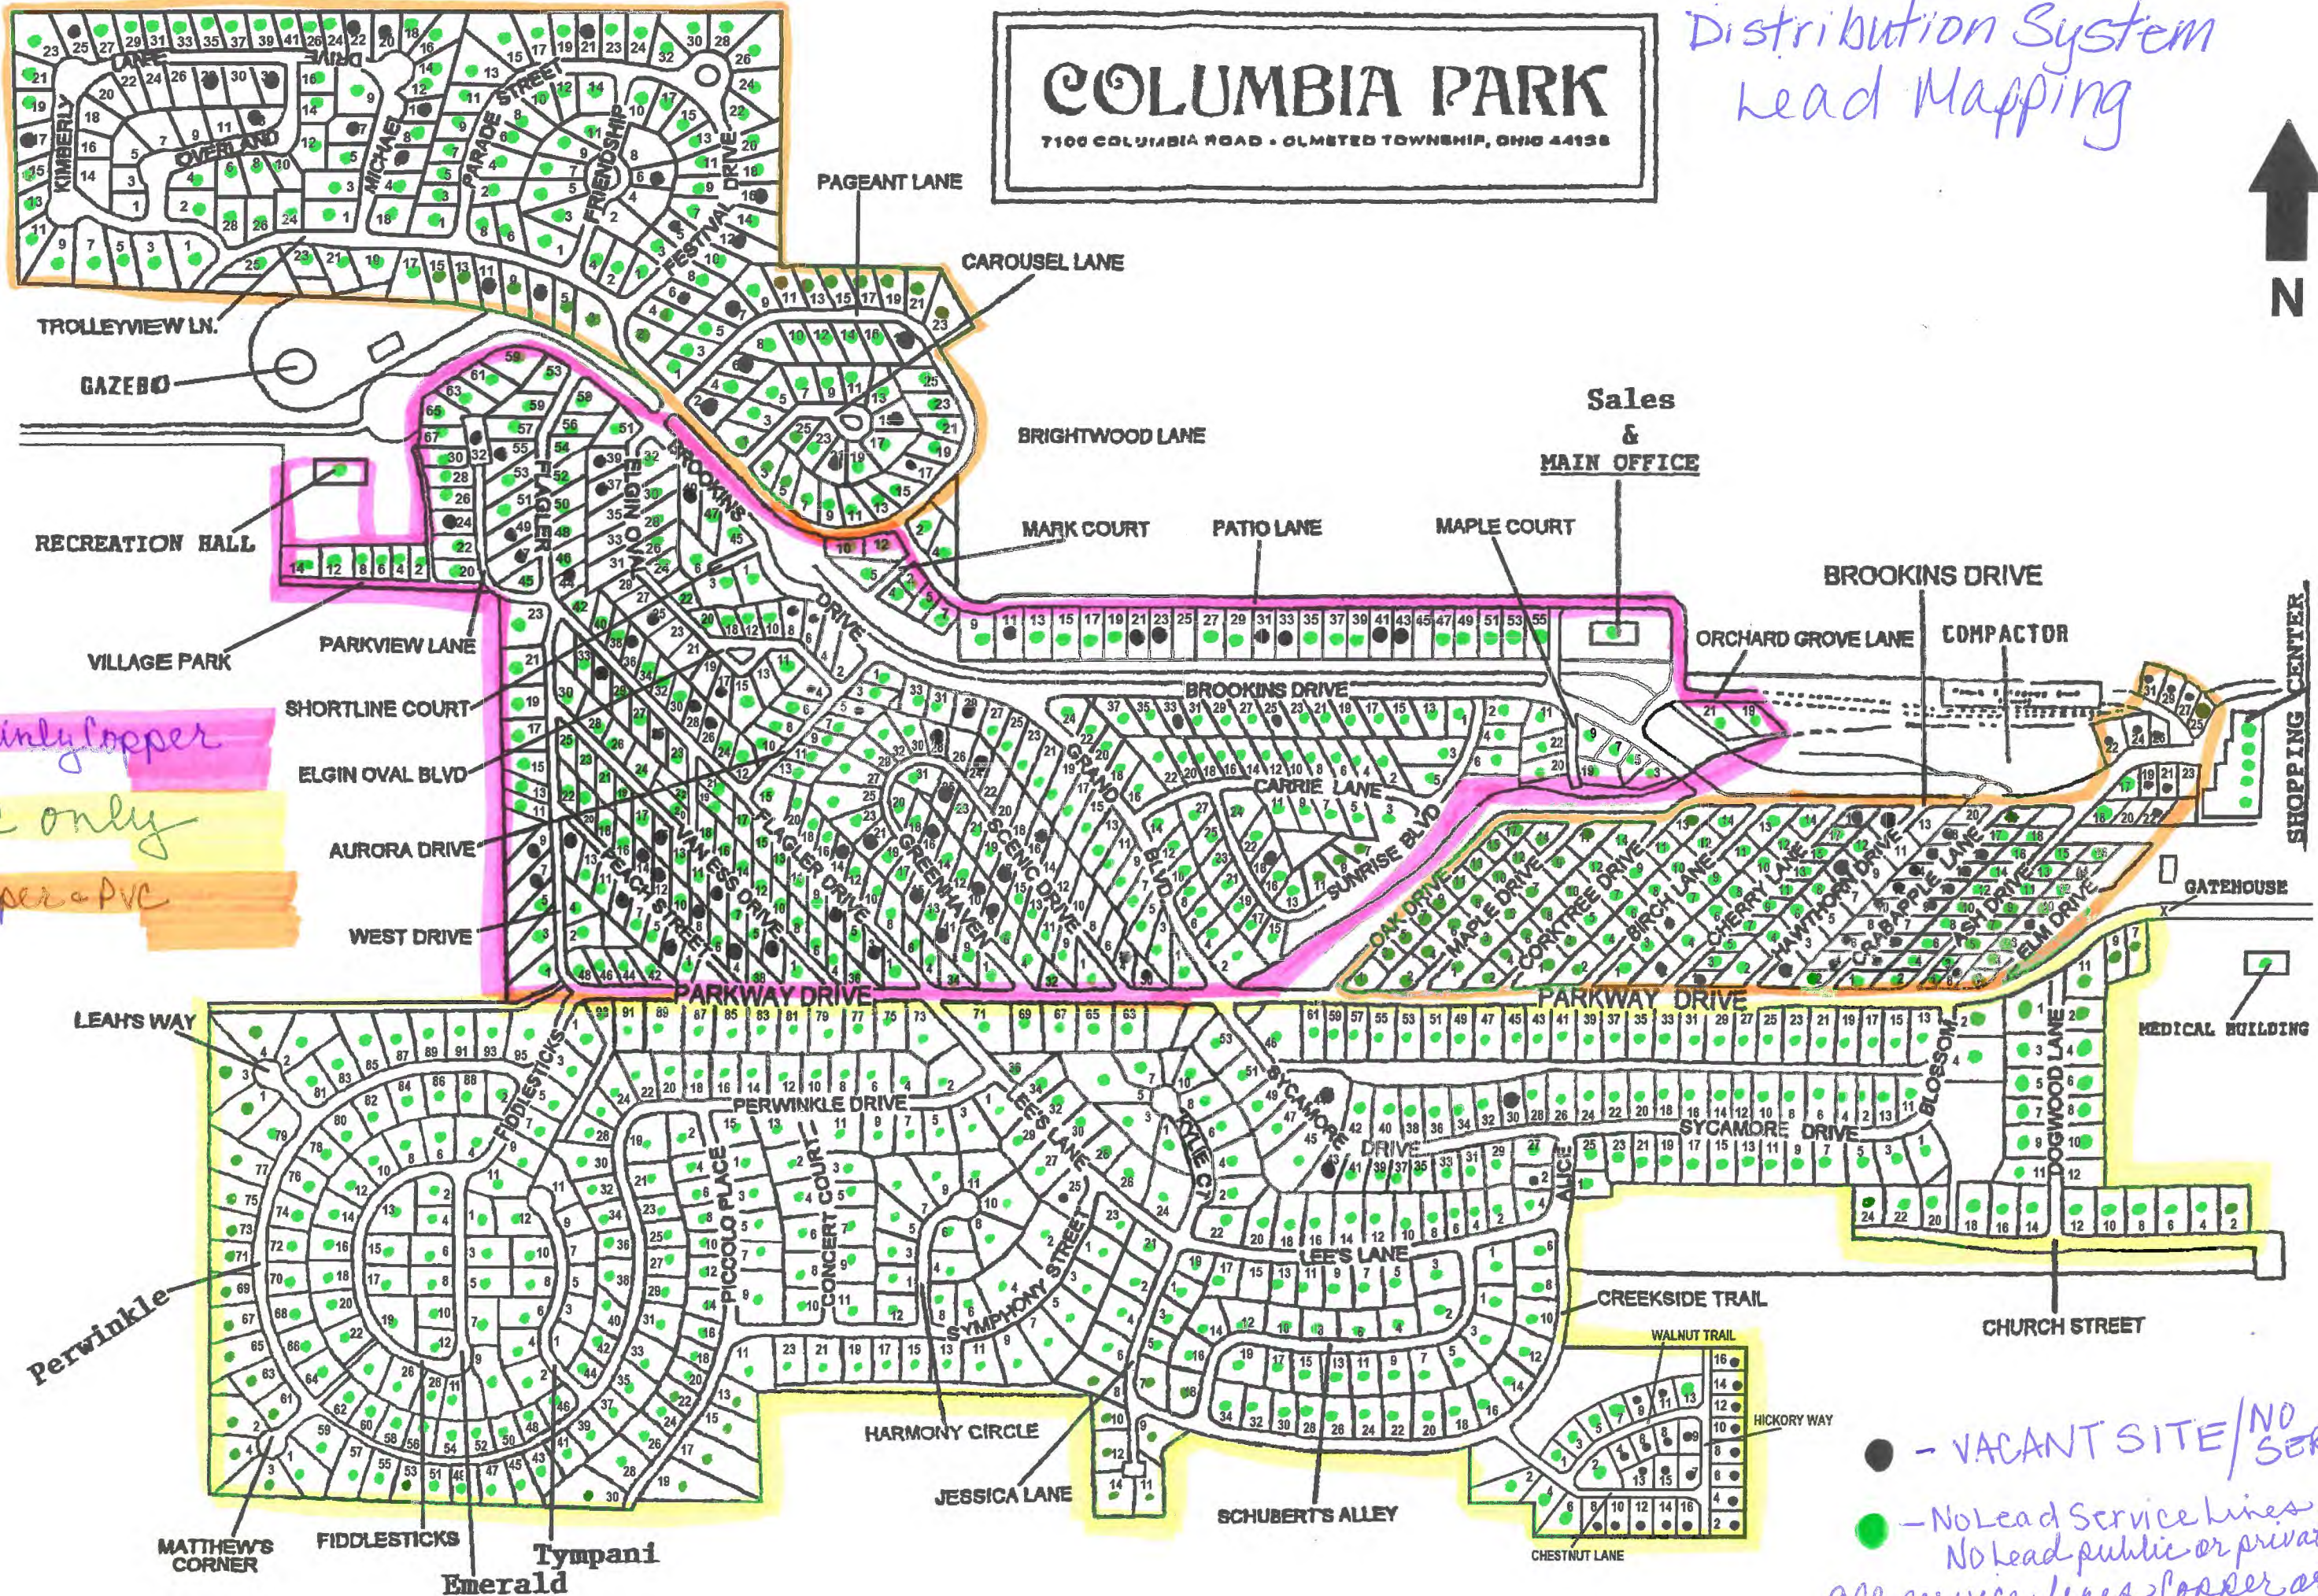

Mainly Copper
PVC only
Copper & PVC

● - VACANT SITE/NO SERVICE
● - No Lead Service Lines
No lead public or private
All service lines Copper or PVC

Perwinkle

MATTHEWS CORNER
FIDDLESTICKS
Tympani
Emerald