

CHILLICOTHE ROAD

83'
NOT TO SCALE



0 100 FEET 200 FEET
SCALE

B

A

FRONT BUILDING ALPHA

BACK BUILDING BRAVO

276'
NOT TO SCALE

SERVICE ENTRANCE

LINE FROM WELL 600' WEST

ALL BUILDINGS
CONSTRUCTED BEFORE 1986

WATER LINE CONSTRUCTION:
NO INFORMATION GREY

STOCK EQUIPMENT COMPANY
16490 CHILLICOTHE ROAD
CHAGRIN FALLS, OH 44023
440-543-6000

UNLESS OTHERWISE SPECIFIED			REF. DWG. ---	NEXT ASSY. ---	S.O. NO. ---
DECIMAL DIMENSIONS	3/32	0.00	INFORMATION CONTAINED ON THIS DRAWING IS CONFIDENTIAL AND PROPRIETARY TO STOCK EQUIPMENT COMPANY AND MAY NOT BE REPRODUCED OR USED WITHOUT THE EXPRESS WRITTEN CONSENT OF STOCK EQUIPMENT COMPANY		
FRACTIONAL DIMENSIONS	1/16	0.0625	PART NO. .		
ANGLE DIMENSIONS	1/16	0.0625	MATL. .		
BURNOUT DIMENSIONS	1/16	0.0625	. .		
MAX. SURFACE ROUGHNESS	125	0.0007	QTY. ---		
FOR BURNOUT SURFACES					
MAX. SURFACE ROUGHNESS					
FOR BURNOUT SURFACES					
DESIGNS AND BREAK ALL SHARP					
EDGES AND CORNERS					
(REQUIREMENTS FOLLOWING: PER ANSI Y14.5)					
REVISION	PREPARED BY	DATE			
REMOVED PART IS INTERCHANGEABLE WITH ORIGINAL					
CAD FILE: d46900.dwg					
PREPARED BY: CHICKIEWICZ					
CHECKED BY: HILSCH			stock 16490 Chillcothe Road Chagrin Falls, Ohio 44023 www.stockequipment.com 440-543-6000		
DATE: 3-2-2017			SHEET 1 OF 2	SHEET SIZE D	D46900
			REV 0		

8 7 6 5 4 3 2 1

D

D

C



C

B

B

A

A

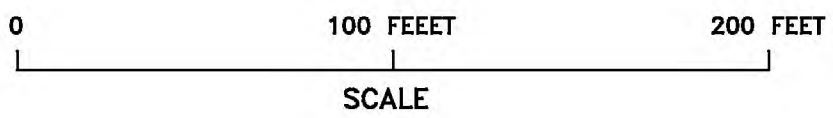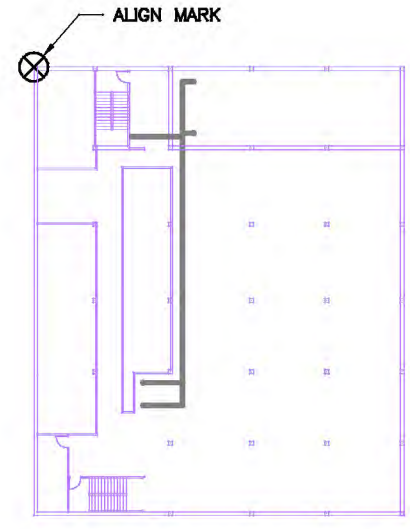

**FRONT BUILDING ALPHA
SECOND FLOOR**

STOCK EQUIPMENT COMPANY
16490 CHILLICOTHE ROAD
CHAGRIN FALLS, OH 44023
440-543-8000

UNLESS OTHERWISE SPECIFIED			REF.DWG	NEXT ASSY.	S.O.NO.
DECIMAL DIMENSIONS	3/16	0.005	INFORMATION CONTAINED ON THIS DRAWING IS CONFIDENTIAL AND PROPRIETARY TO STOCK EQUIPMENT COMPANY AND MAY NOT BE REPRODUCED OR USED WITHOUT THE EXPRESS WRITTEN CONSENT OF STOCK EQUIPMENT COMPANY		
FRACTIONAL DIMENSIONS	1/16	0.001	PART NO.		
ANGLE DIMENSIONS	± 1/16		MATL.		
BURNDOUT DIMENSIONS	± .000		QTY.		
MAX. SURFACE ROUGHNESS	125				
TOP SURFACE SURFACES	125				
MAX. SURFACE ROUGHNESS	630				
FOR BURNDOUT SURFACES					
DESIGNS AND BREAK ALL SHARP EDGES AND CORNERS (RESTRICTION TOLERANCE PER ANSI Y14.5)					
REVISION	PREPARED BY	DATE			
REMOVED PART IS INTERCHANGEABLE WITH ORIGINAL					
CAD FILE:	d46900.dwg				
PREPARED BY:	CIECKIEWICZ				
CHECKED BY:	HRLUSCH				
DATE:	3-2-2017				
Stock Equipment Company 16490 Chillicothe Road Chagrin Falls, Ohio 44023 www.stockequipment.com 440-543-8000					SHEET 2 OF 2
			SHEET SIZE D		D46900
					REV 0

8 7 6 5 4 3 2 1