


RE: University of Findlay – South Campus  
Report  
Drinking Water Program  
Hancock County  
PWS ID: OH3244912

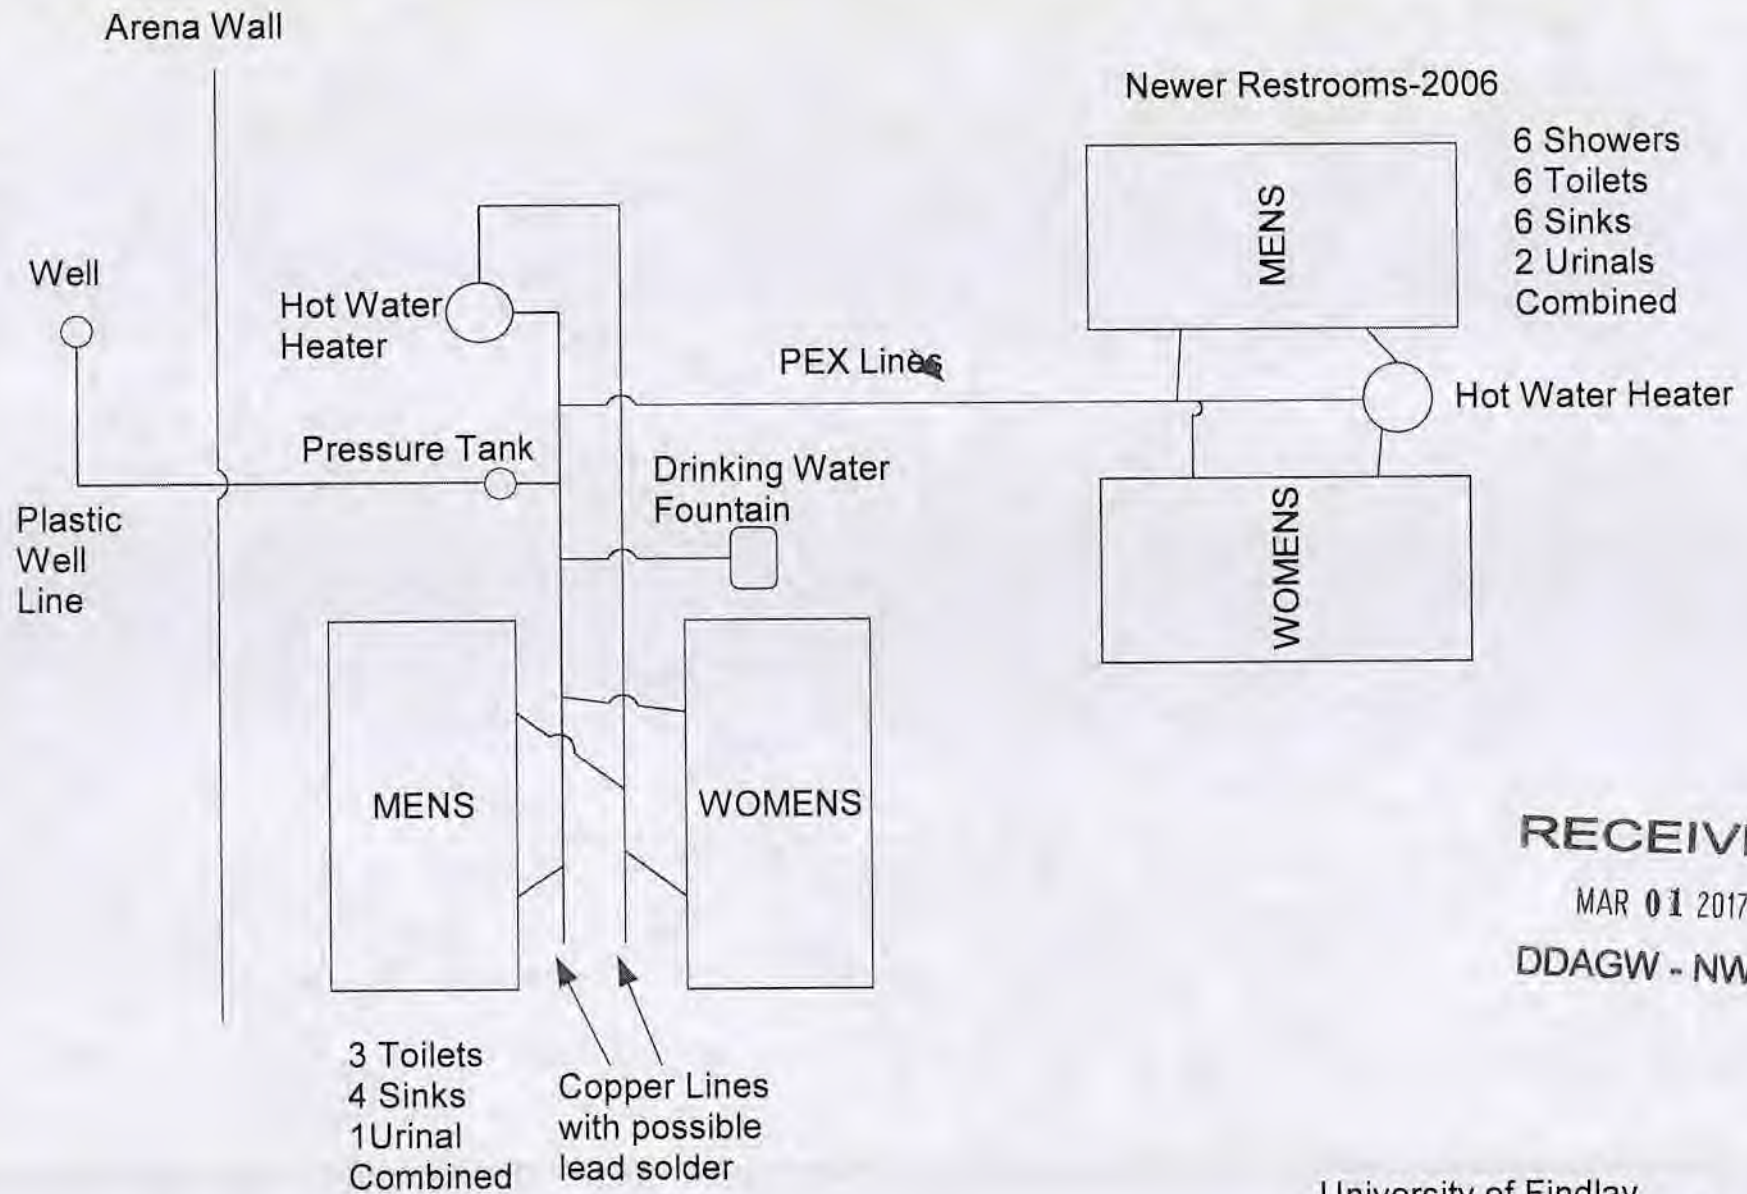


**RECEIVED**


MAR 01 2017

DDAGW - NWDO

University of Findlay  
Bldg. E Dale Wilkerson Arena  
Built 1978

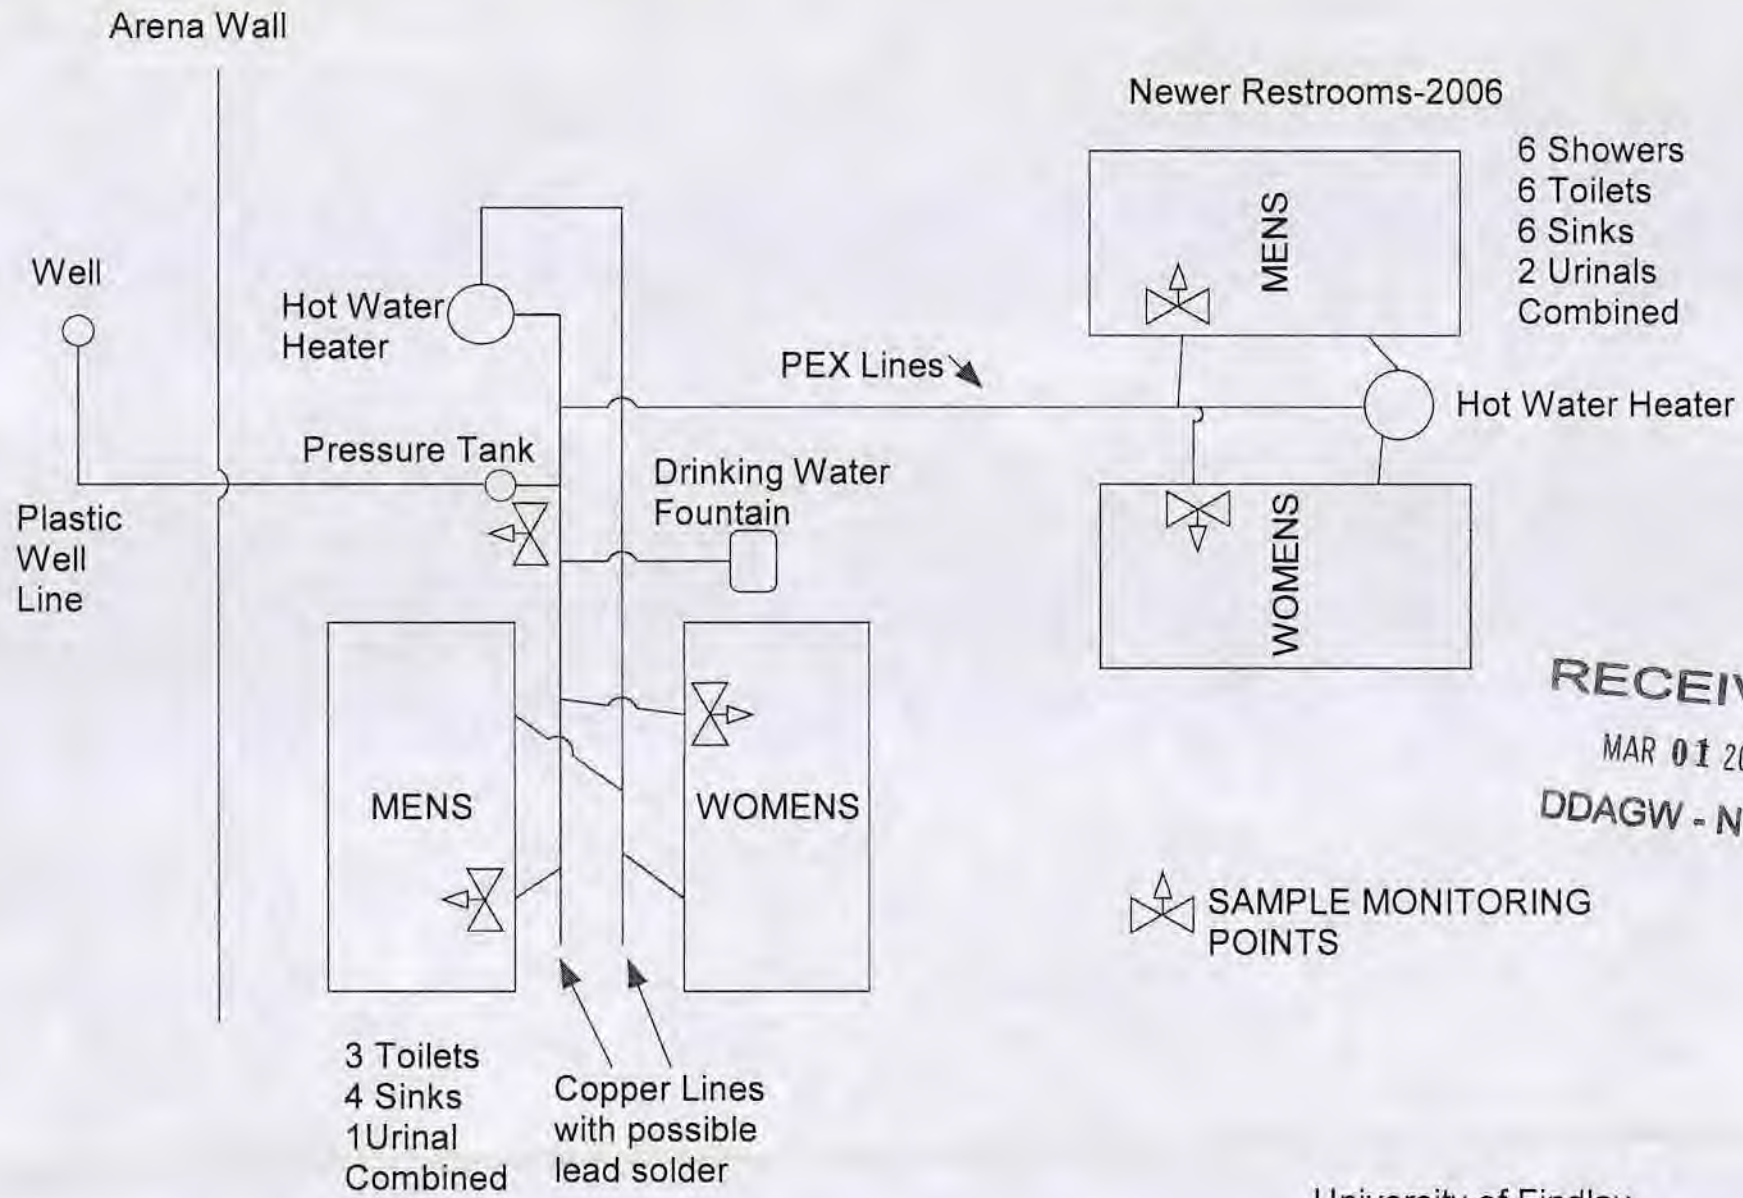

**RECEIVED**  
 MAR 01 2017  
 DDAGW - NWDO

 SAMPLE MONITORING POINTS

University of Findlay  
 Bldg. E Dale Wilkerson Arena  
 Built 1978