

RE: Morton Buildings
Report
Drinking Water Program
Hardin County
PWS ID: OH3331812

RECEIVED

MAR 01 2017

DDAGW - NWDO




MORTON
BUILDINGS
PLANT FACILITY
- KENTON, OH

Morton Buildings




Buildings in Ohio built prior to 1998 or that use plumbing material or solder manufactured before 1998 may have materials with greater than 8% lead and are at a higher risk of contributing lead to the drinking water than materials manufactured after 1998. In addition, buildings built and plumbing materials manufactured after 2014 were required to have less than 0.25% lead by weight and have the lowest risk for contributing lead to the drinking water. It should be noted however that, although prohibited, some use of leaded solder or leaded components may have occurred after the prohibitions became effective.

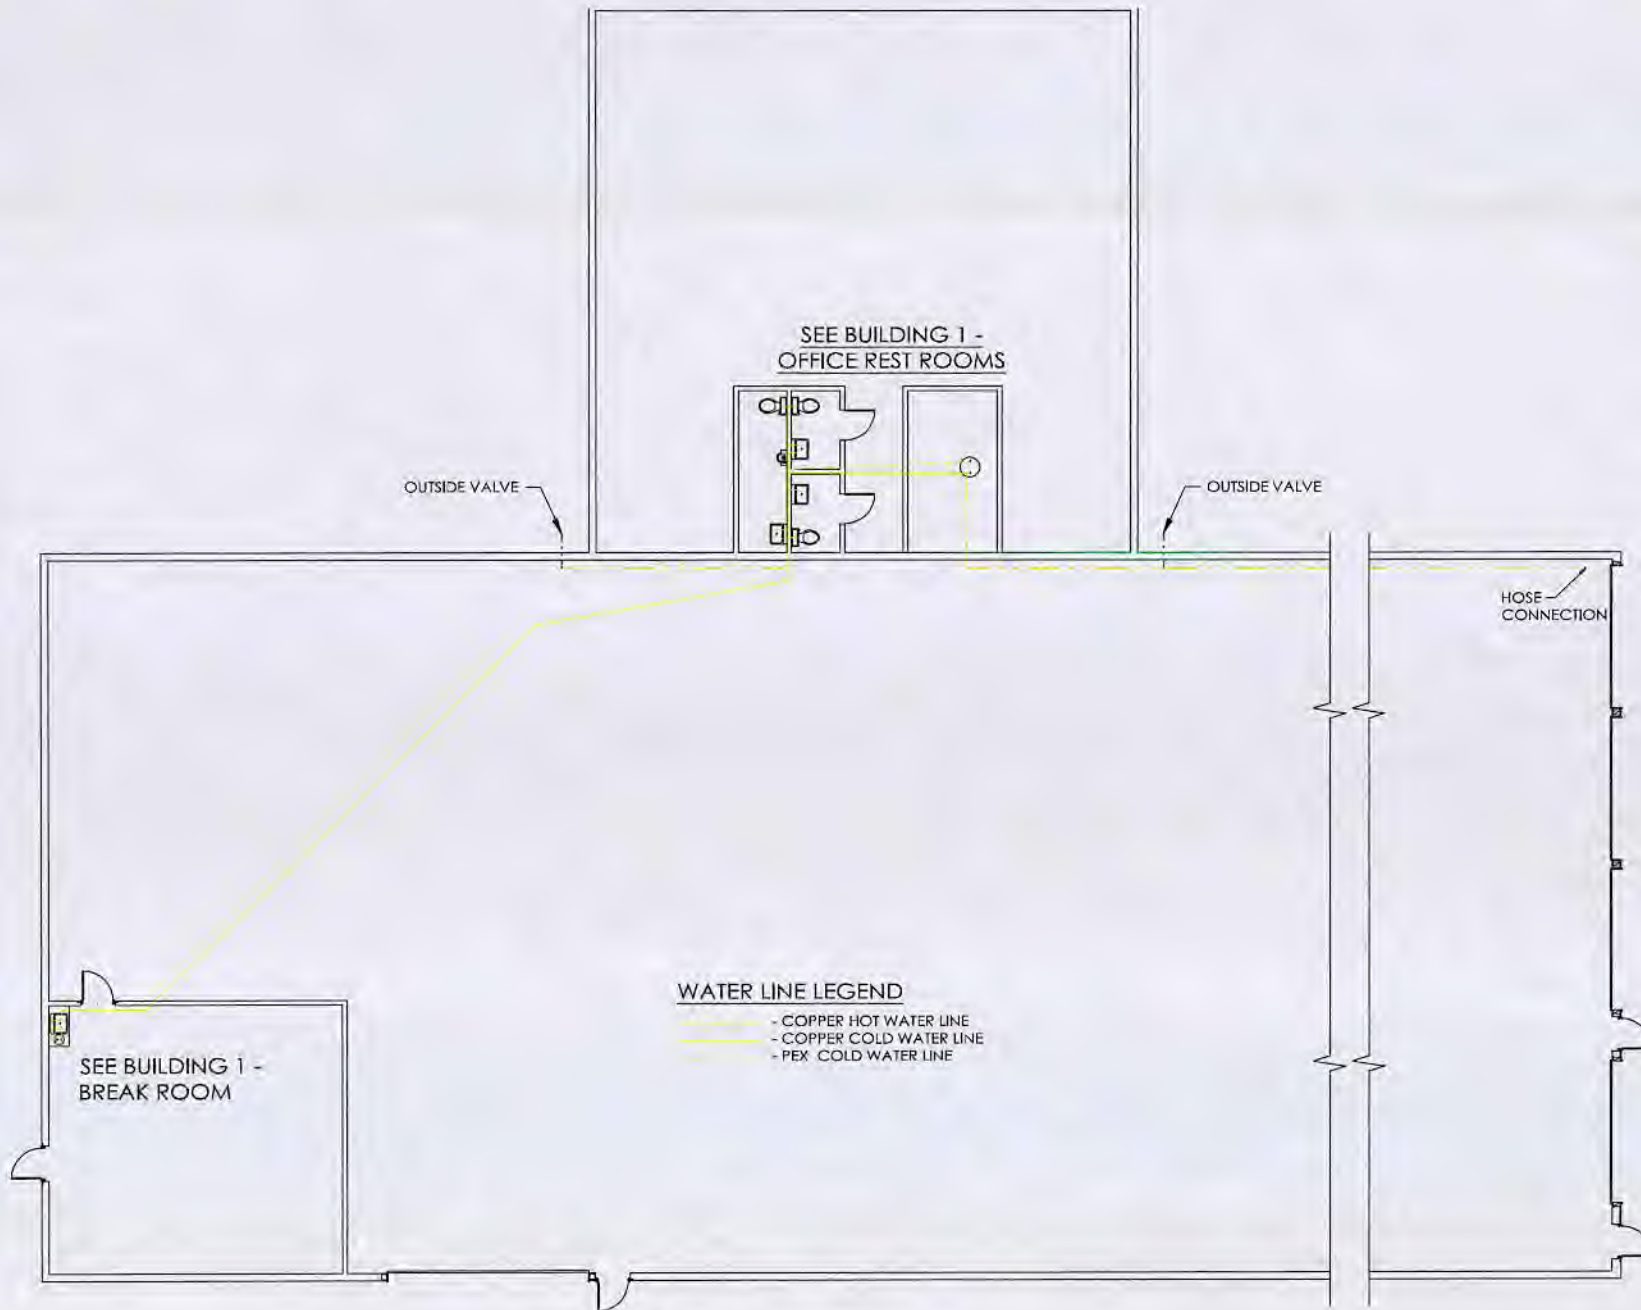

BUILDING 1




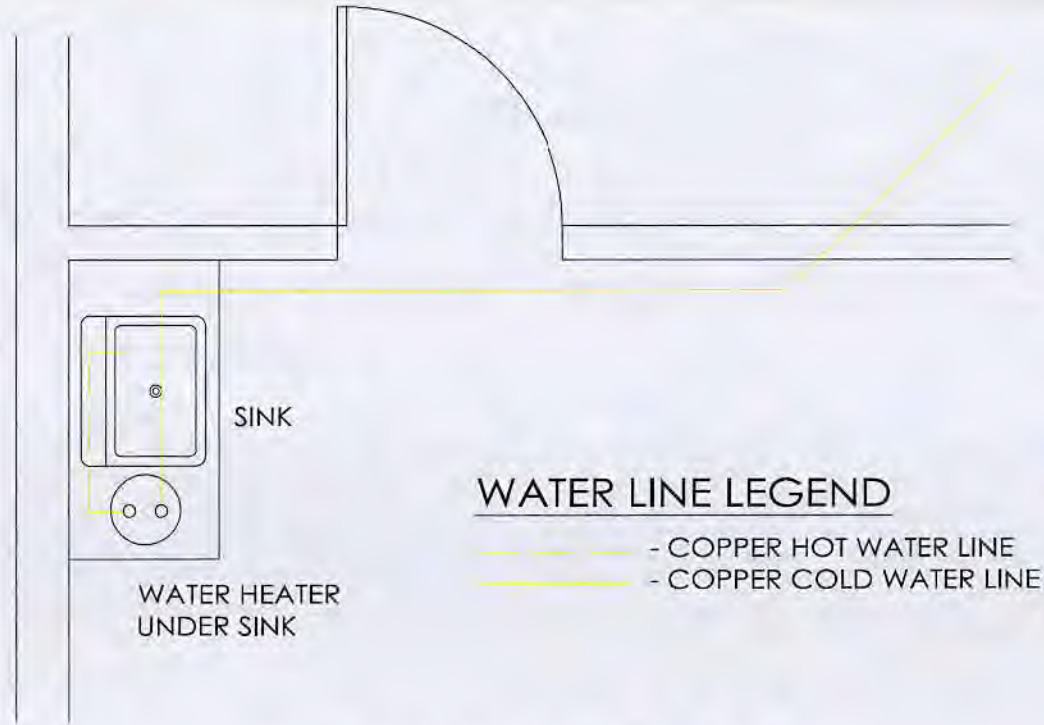

BUILDING 1 BREAK ROOM



NOTE:
ALL HOT AND COLD WATER
LINES ARE IN THE WALLS.


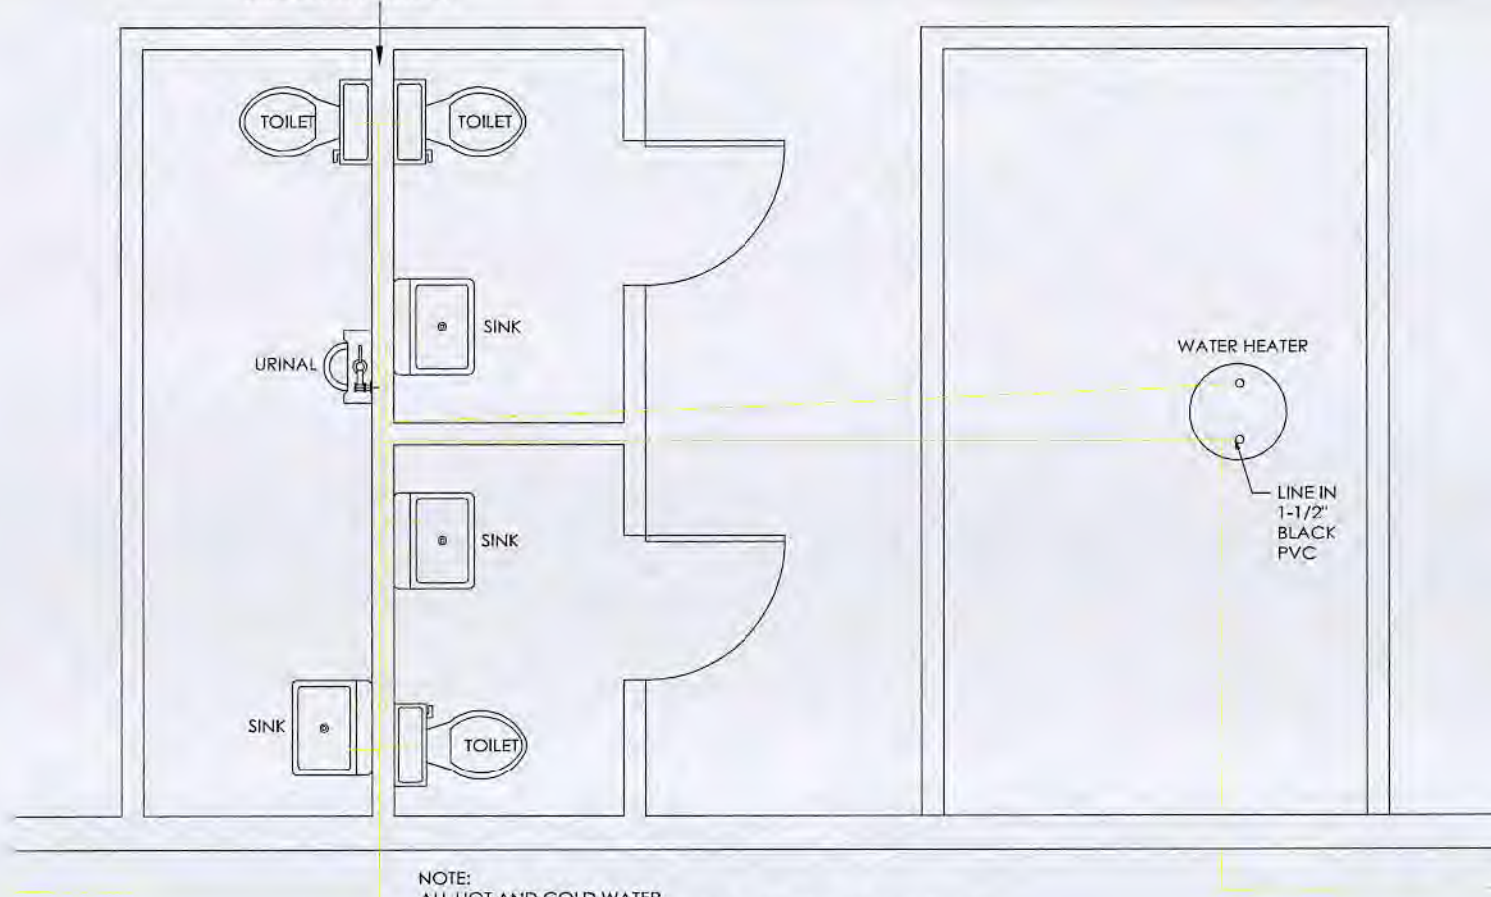


BUILDING 1 OFFICE REST ROOMS

WATER LINE LEGEND

- COPPER HOT WATER LINE
- COPPER COLD WATER LINE
- PEX COLD WATER LINE



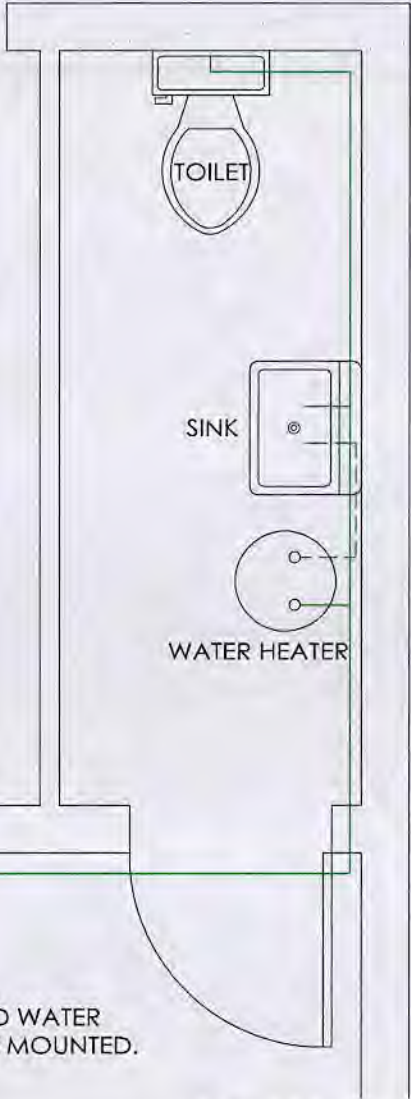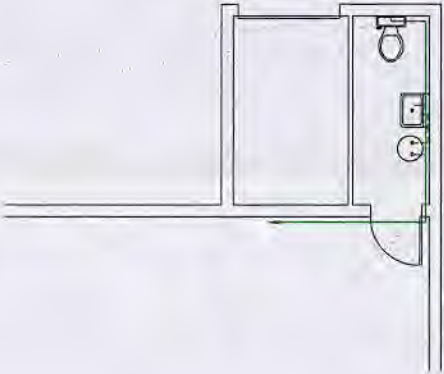

LINE IN - 1"
PEX FROM
BUILDING 2



NOTE:
ALL HOT AND COLD WATER
LINES ARE SURFACE MOUNTED.

WATER LINE LEGEND

- - - - - PEX HOT WATER LINE
- — — — PEX COLD WATER LINE

BUILDING 2




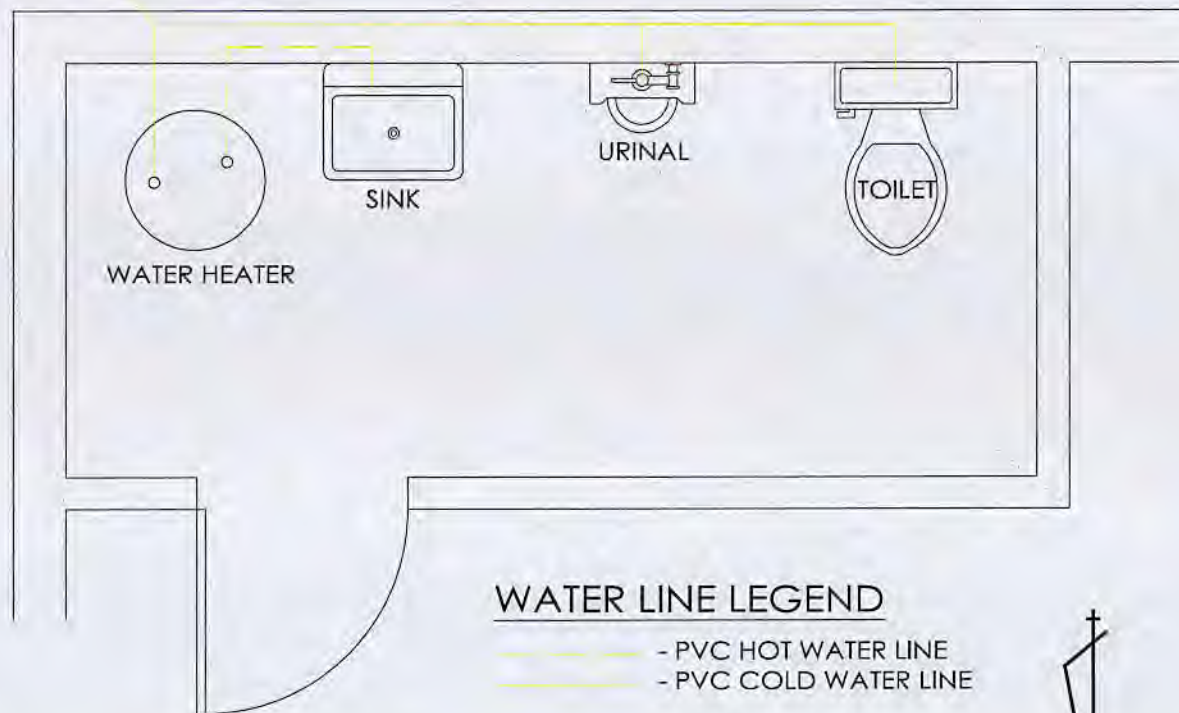
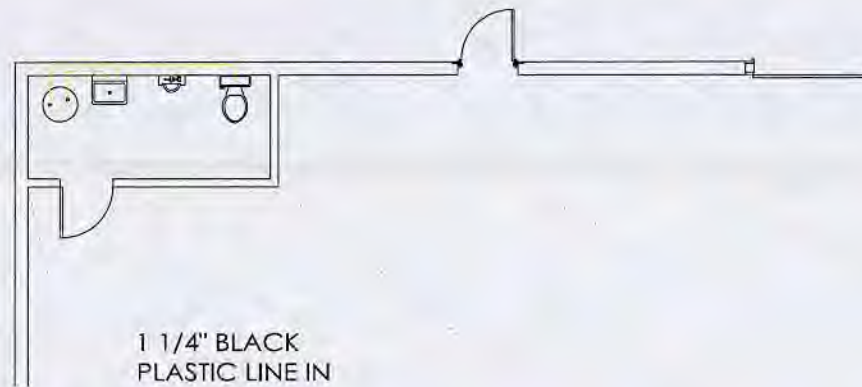


NOTE:
ALL HOT AND COLD WATER
LINES ARE IN THE WALLS.

BUILDING 3



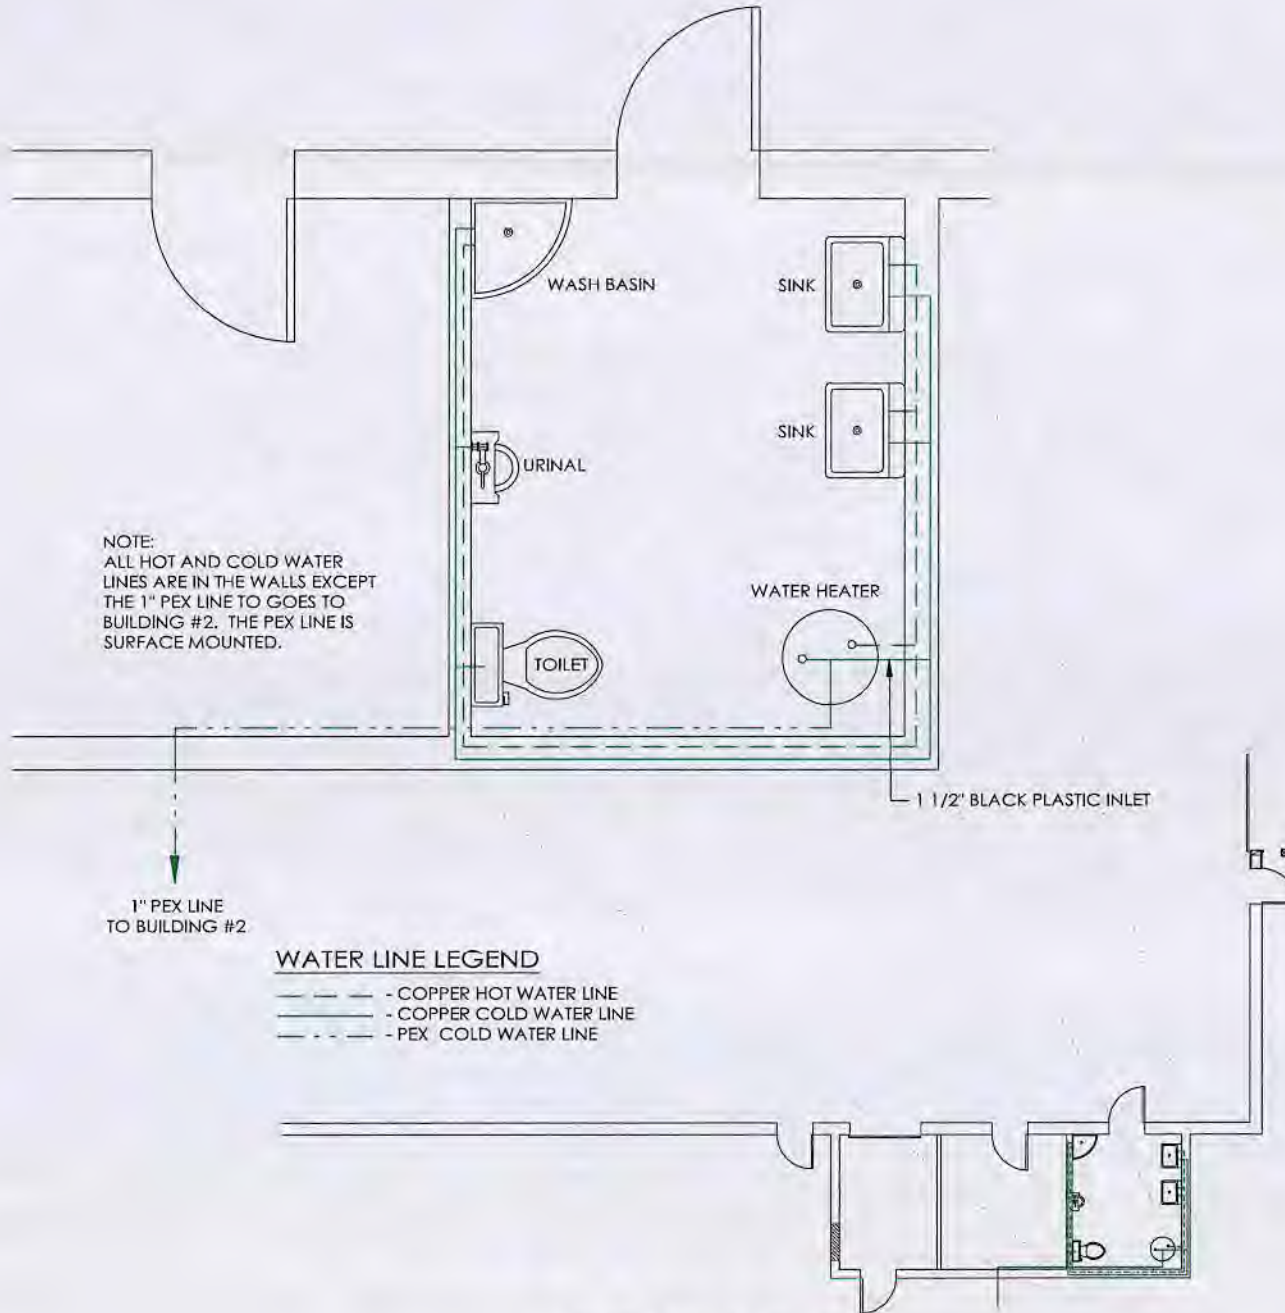

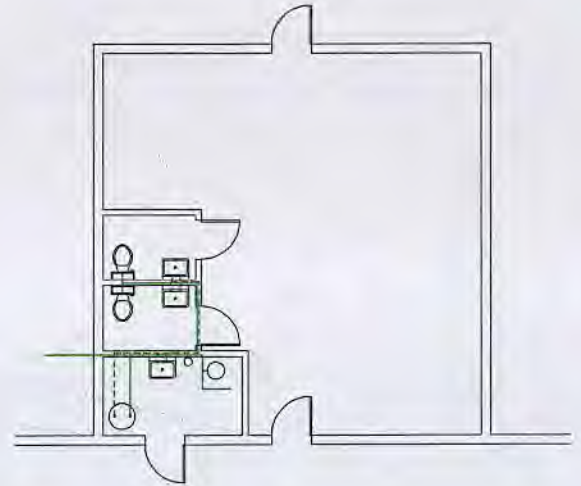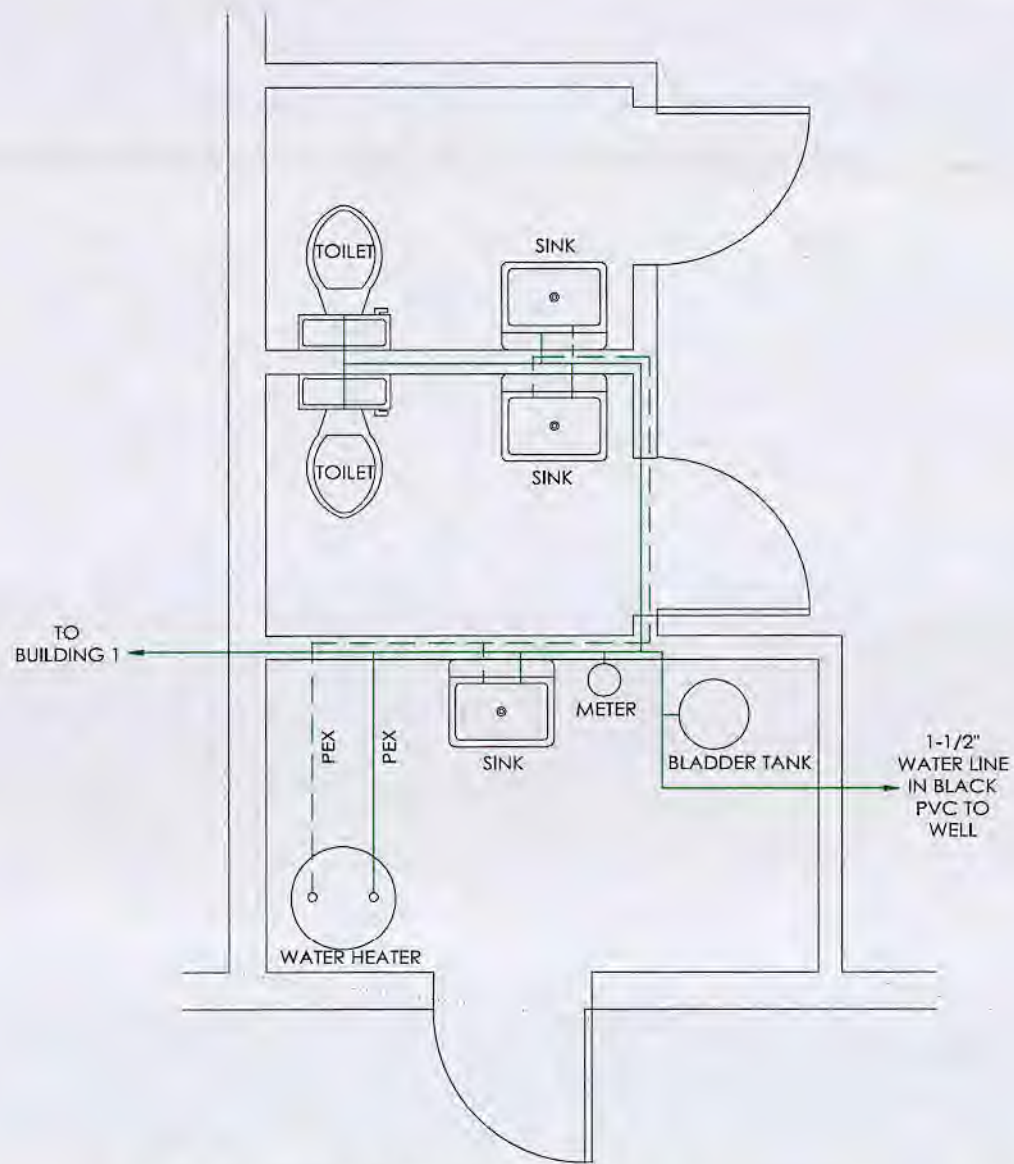


WATER LINE LEGEND*

- - - - - COPPER HOT WATER LINE
- COPPER COLD WATER LINE

*EXCEPT WHERE NOTED

BUILDING 6



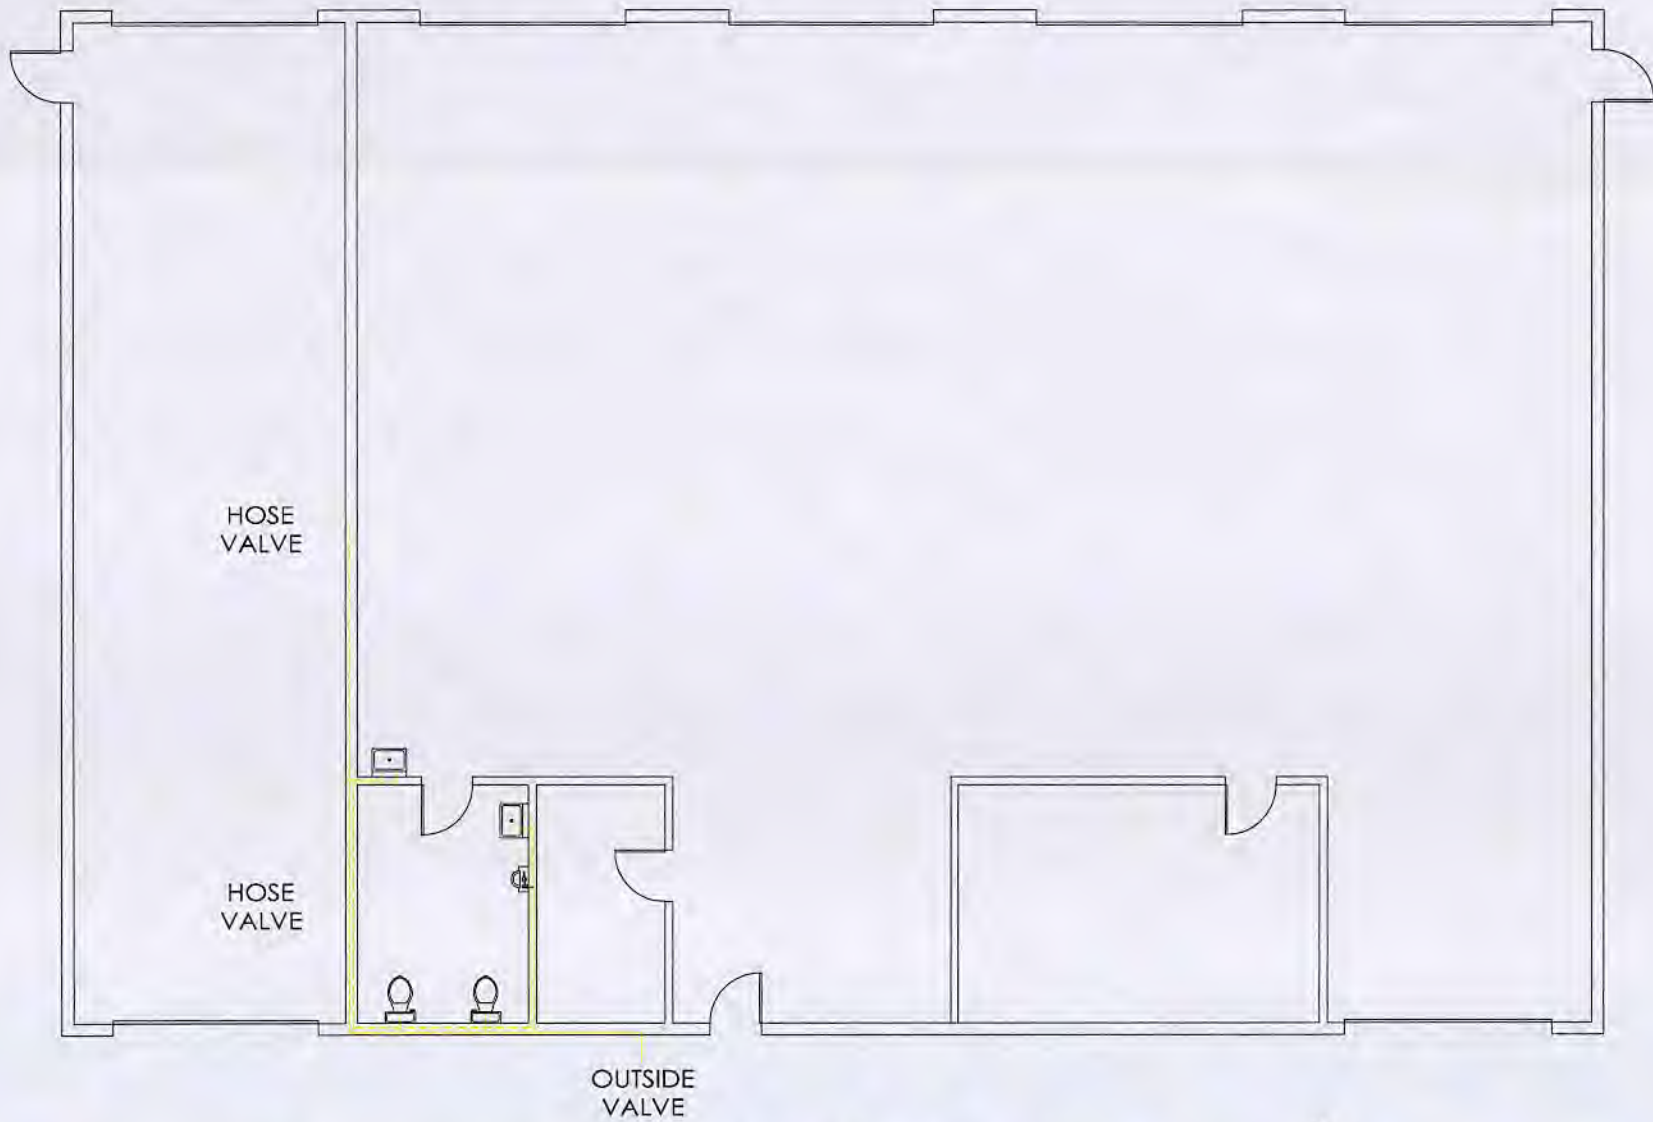


NOTE:
ALL HOT AND COLD WATER
LINES ARE IN THE WALLS.

BUILDING 7

WATER LINE LEGEND

- - COPPER HOT WATER LINE
- - COPPER COLD WATER LINE



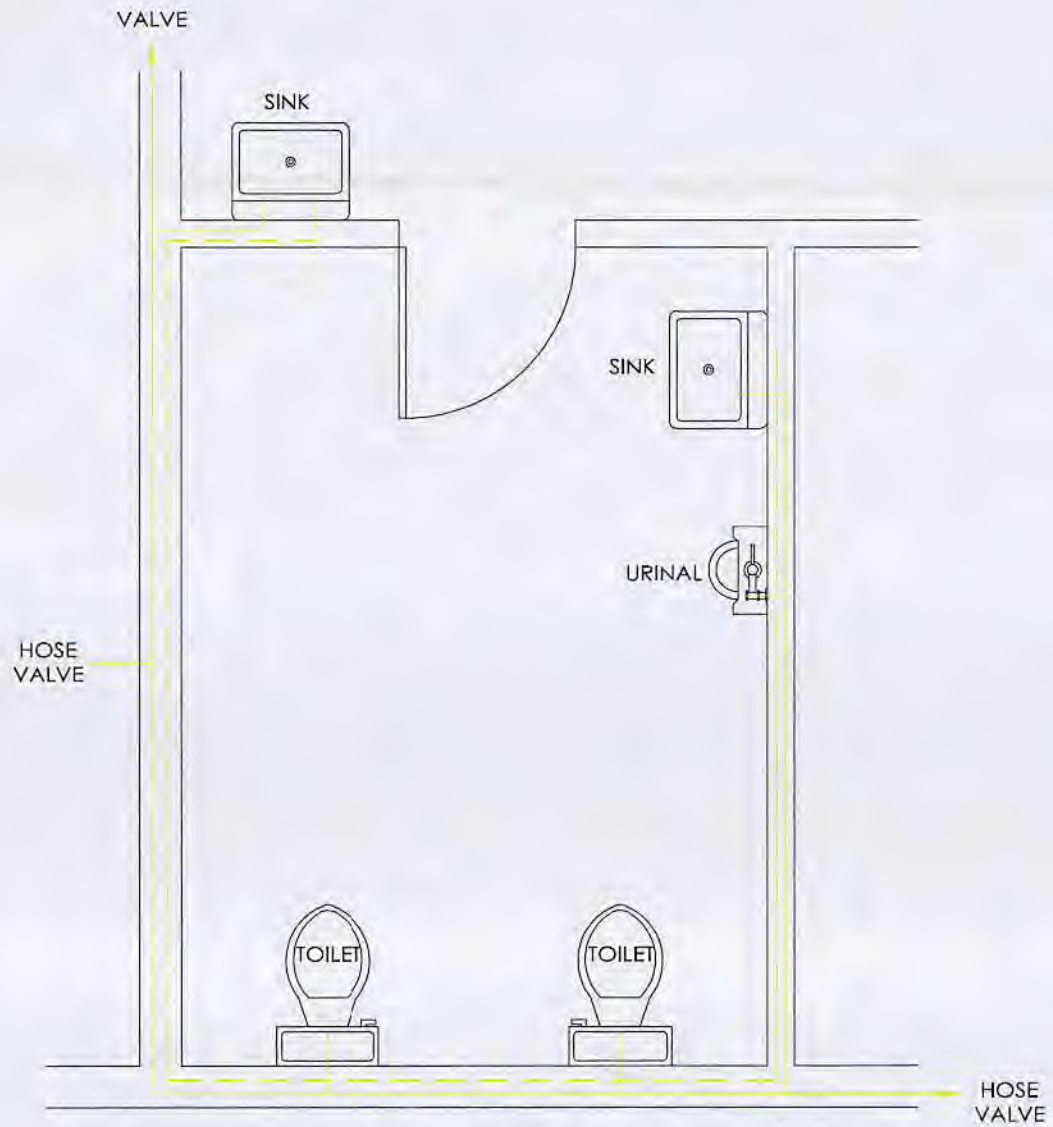


BUILDING 7 - REST ROOM



WATER LINE LEGEND


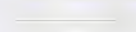
- - COPPER HOT WATER LINE
- - COPPER COLD WATER LINE

NOTE:
ALL HOT AND COLD WATER
LINES ARE IN THE WALLS.

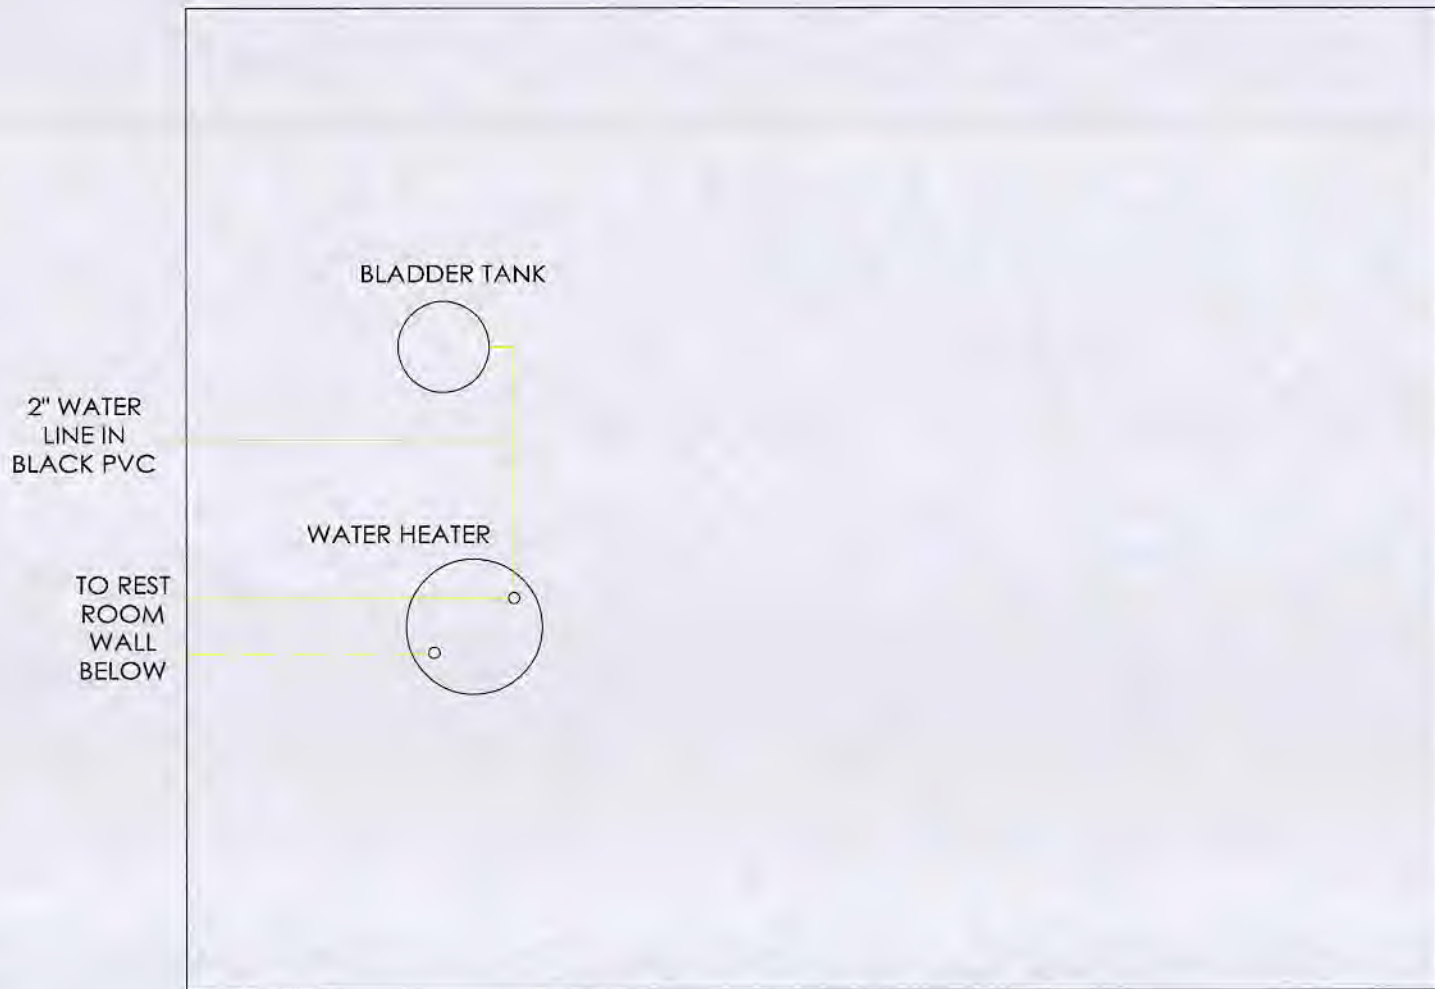

BUILDING 7 - ABOVE REST ROOM

WATER LINE LEGEND

-  - COPPER HOT WATER LINE
-  - COPPER COLD WATER LINE