

RE: Christi Water System Inc  
Report  
Drinking Water Program  
Defiance County  
PWS ID: OH2001003

February 27, 2017

Mr. Justin Bowerman  
Ohio EPA, DDAGW  
Northwest District Office  
347 N. Dunbridge Rd.  
Bowling Green, OH 43402

RECEIVED

MAR 02 2017

OHIO E.P.A.  
N.W.D.O.


Dear Justin:

Enclosed are maps of the Christi Water System, OH2001003 for the lead and copper mapping. I have also enclosed the Verification Form for Community Public Water Systems Claiming No Lead Service Lines. The water mains for Christi Water System are all C900 plastic pipe with the exception of approximately 1000 feet of asbestos cement pipe.

All of the buildings on the Christi Water System are single family residences with the exception of four duplexes which are for single families.

If anything further is required or if you need any further information, please feel free to contact me at 419-330-4658 (home) or 419-572-0678 (cell).

Respectfully,



Rick L. Schantz  
Operator of Record. Christi Water System OH 2001003



CHRISTI MEADOWS WATER SYSTEM INC.  
OH 2001003  
# 205 3837


# CHRISTI MEADOWS SUB-DIVISION

2-21-17 NTS

PIIA-E-1  
NO SCALE

### Legend

- INDICATES RESIDENCE w/ WATER SERVICE
- w/w lead service lines
- Lead & Copper Sample Sites

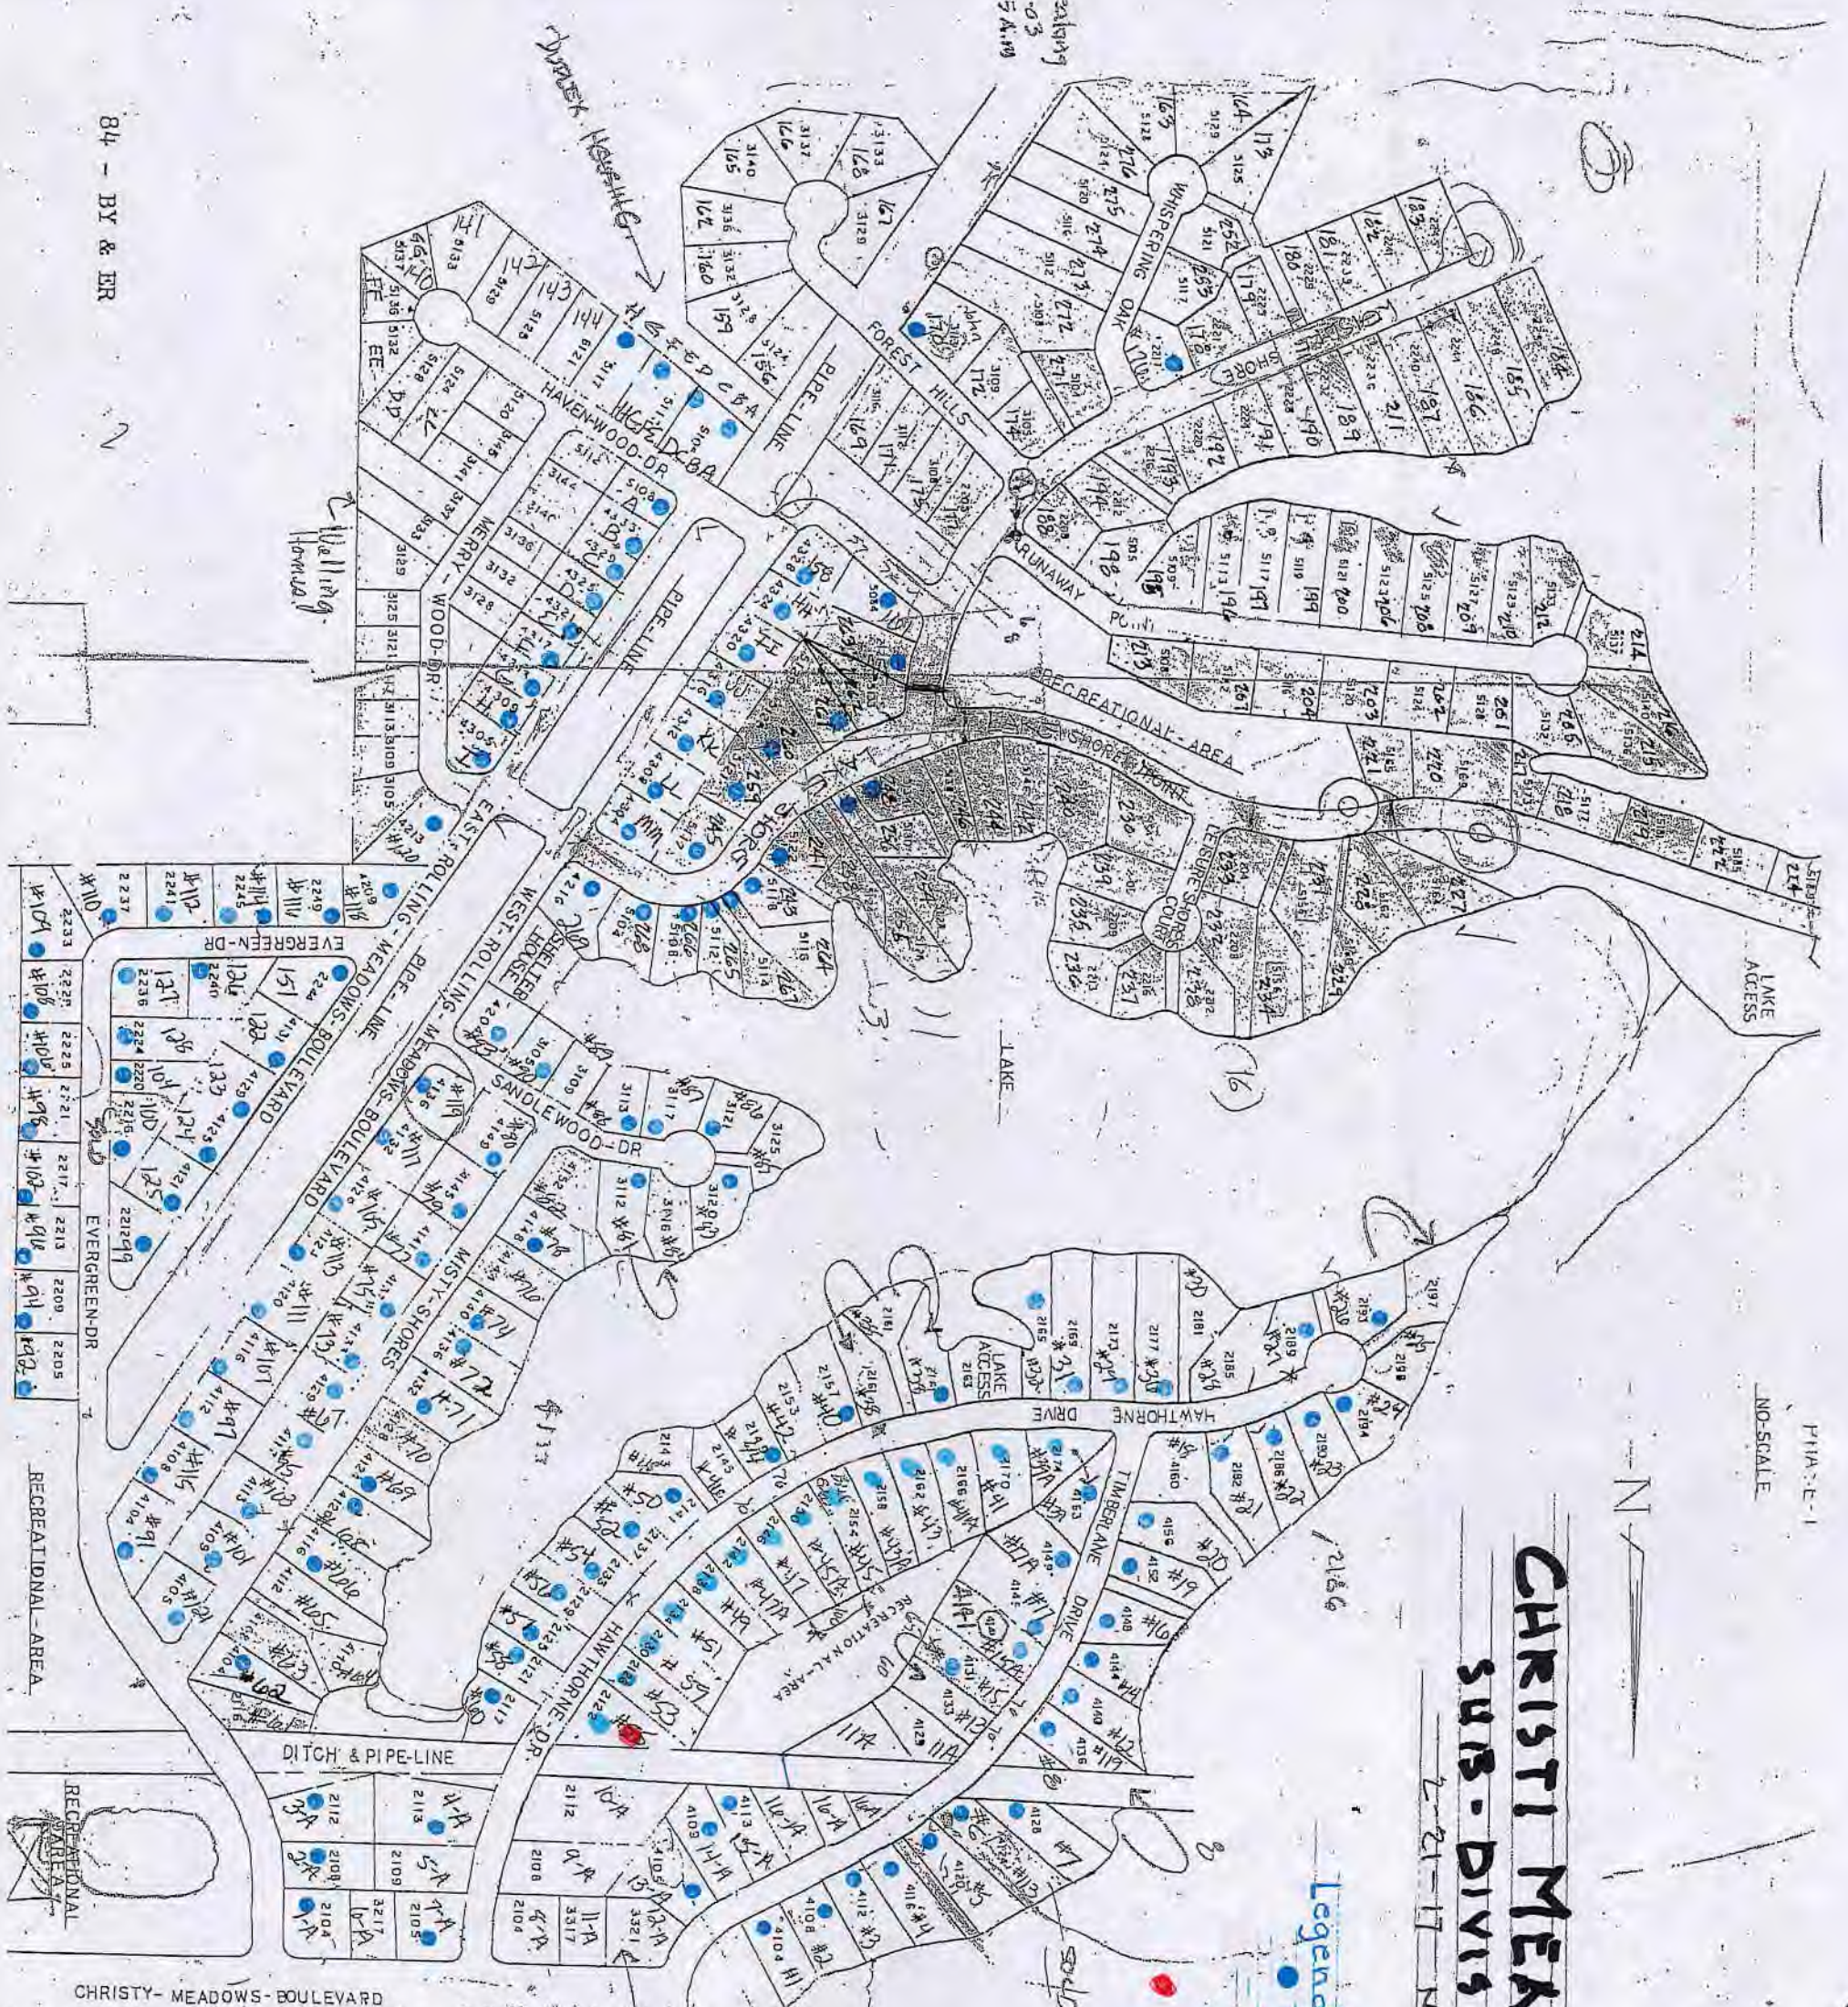

84 - BY & ER

RECEIVED  
MAR 02 2017  
OHIO EPA  
NWDO

DEERFIELD LANE  
DEERFIELD LN  
200 feet

Legend

● Indicates Residence w/water service connection

● Lead & Copper Sample Site


1 OF 2 PARTS  
25.909 AC. mapped

1130010000503

1130010000501

5 AC.

RIVER CHASE

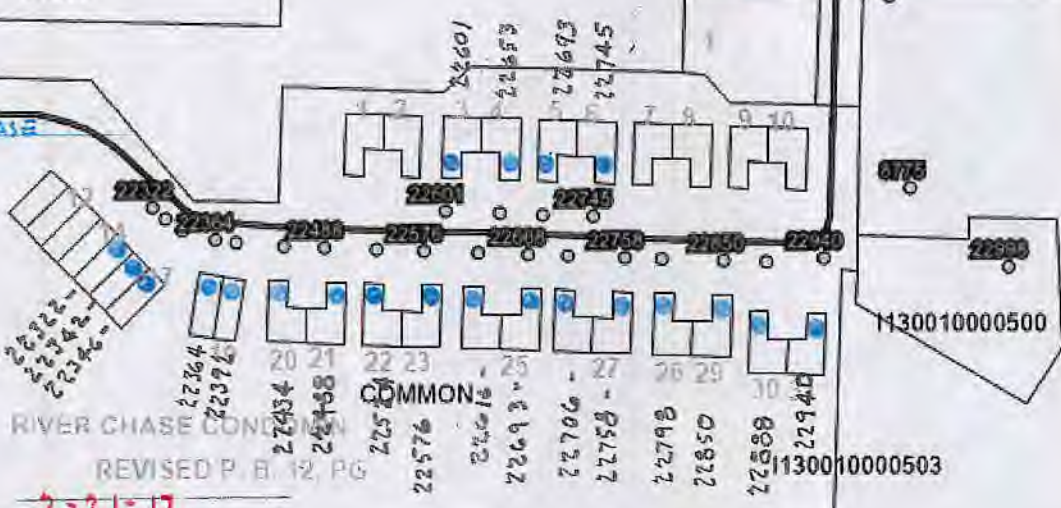

RIVER CHASE CONDOMINIUM

REVISED P. B. 12, PG

2-21-17

TIFFIN RIVER

NORTH

RIVER CHASE DEVELOPEMENT

2-21-17 NIS

CHRISTI WATER SYSTEM INC

OH 2001 003

# 2053837

1130010000700