


RE: Cory Rawson Schools
Report
Drinking Water Program
Hancock County
PWS ID: OH3232112



RECEIVED

MAR 02 2017

OHIO E.P.A.
N.W.D.O.

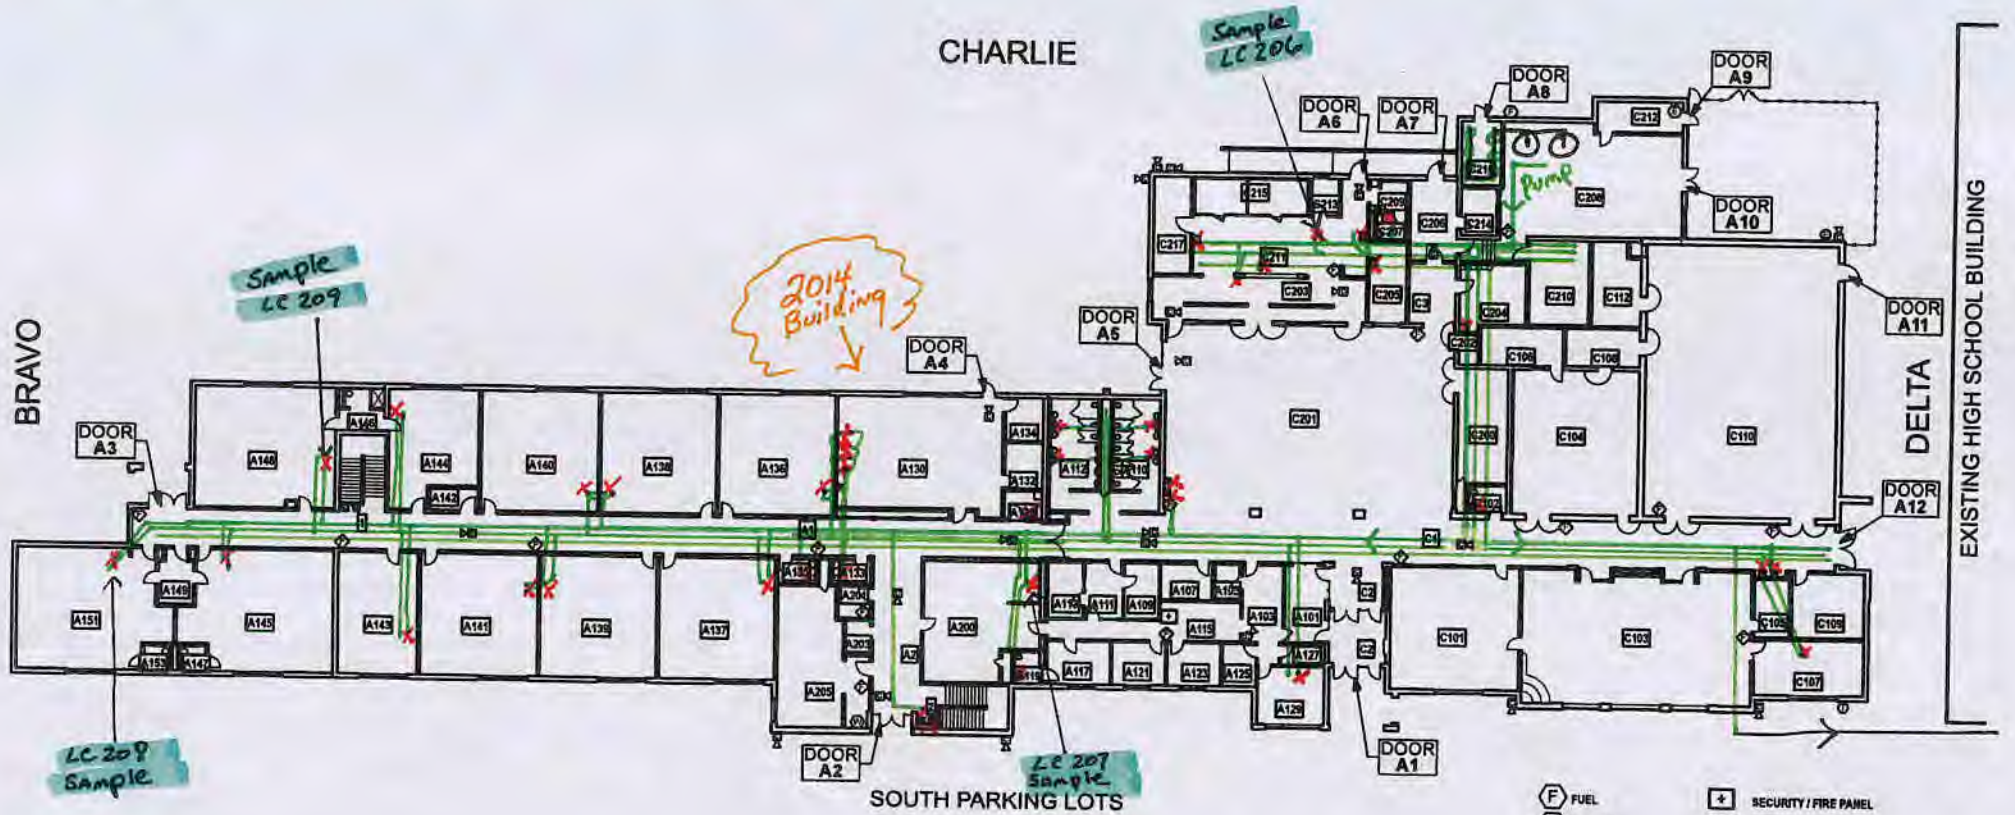

**CORY-RAWSON PK-8
FIRST FLOOR PLAN**

3936 COUNTY ROAD 26 RAWSON, OHIO 45881
DISTRICT IRN: 047431, BUILDING IRN: 031120
Phone: 419-963-7017 (Option 1) Maintenance: W. Young 419-722-1801

ALPHA
OLD COUNTY ROAD 26
RUNS IN FRONT OF THE SCHOOL
C-R SCHOOLS NOW OWNS THE ROAD

- (F) FUEL
 - (E) ELECTRIC
 - (W) WATER
 - (F) FIRE EXTINGUISHER
 - (S) SECURITY / FIRE PANEL
 - (C) CAMERA
 - (A) AED (LOCATED IN HIGH SCHOOL)
 - (T) TELECOMMUNICATIONS
 - X SINKS
 - Non Lead
- * All Sinks and Fixtures - 2014
Lead Content Unknown



2014 Building
↓

CHARLIE

BRAVO



DELTA

LC 210
Sample

- | | |
|-------------------|-----------------------|
| F FUEL | SECURITY / FIRE PANEL |
| E ELECTRIC | CAMERA |
| W WATER | AEO |
| FIRE EXTINGUISHER | TELECOMMUNICATIONS |

ALPHA


**CORY-RAWSON PK-8
SECOND FLOOR PLAN**

3936 COUNTY ROAD 26 RAWSON, OHIO 45881
DISTRICT IRN: 047431, BUILDING IRN: 031120

Phone: 419-963-7017 (Option 1) Maintenance: W. Young 419-722-1801



NEW ELEMENTARY SCHOOL

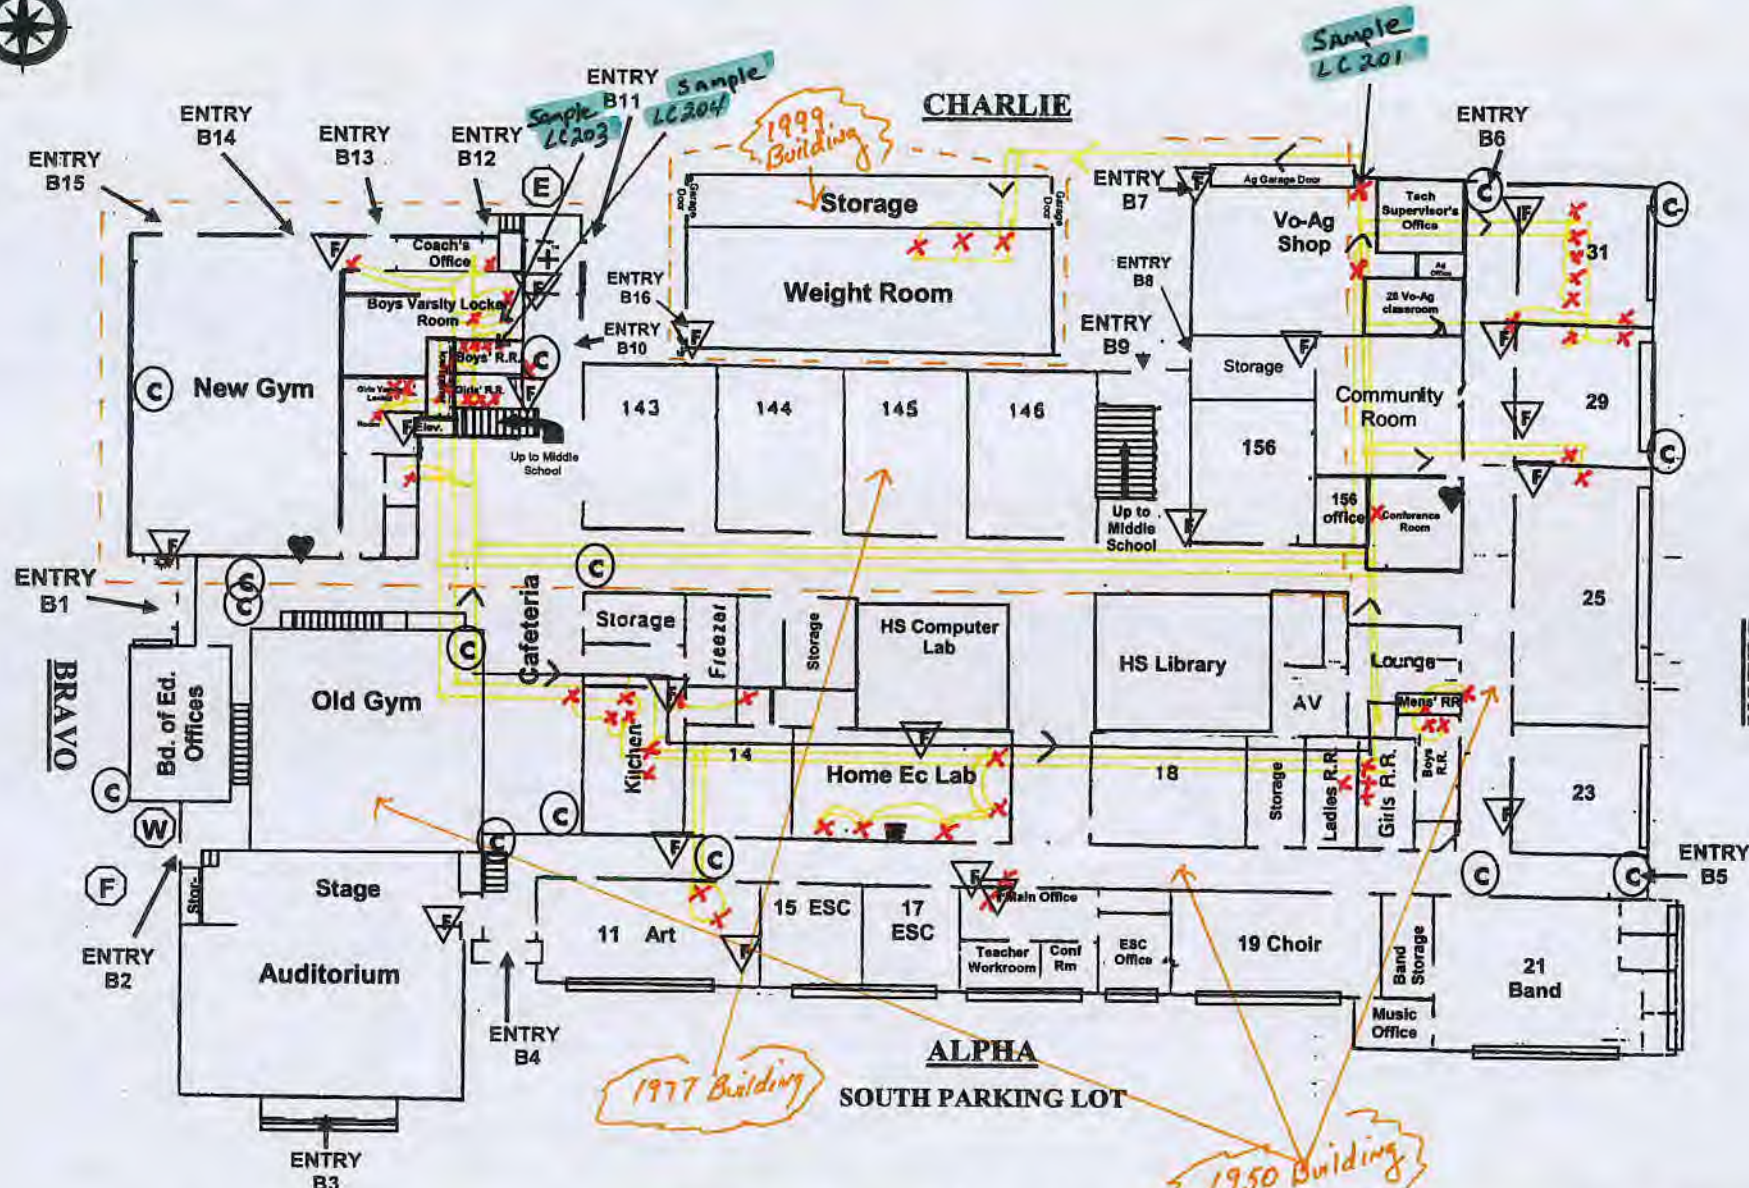

WEST PARKING LOT

Old County Road 26 Runs in front of the school
C-R Schools Now Owns the Road

- X Sinks
 - (F) Fuel
 - (E) Electric
 - (W) Water
 - (F) Fire Extinguisher
 - Copper Lines Lead Joints
 - + Security/Fire Panel
 - (C) Camera
 - ♥ AED
- Sinks and Fixtures Range from 1950 - 2016

Cory-Rawson High School

District IRN: 047431, Building IRN: 007401
3930 CR 26, (1st Floor)
Rawson, OH 45881

419 963-2611, Maintenance: W. Young 419 722-1801

ENTRY B12

Exit
down to
Outside

Cory-Rawson High School (2nd Floor)

District IRN: 047431, Building IRN: 007401

3930 County Road 26, Rawson, OH 45881

419 963-3415, Maintenance: W. Young 419 722-1801

225

223

226

222

227

221

Charlie



2nd Floor, 1977 Building

ENTRY
B9

*Sample
at 205*

Bravo

Delta

Boys
RR

Cust.

Girls
RR

Mechanical

203 Work
Room

204
Office

Storage

205
Conference
Room

206
Office

Closet

RR
RR

Staff
Lounge
208

209

210

211

212

Library
219

Computer
Lab
218

217

216

214

Storage

Exit, Down to
High School

Storage

X Sinks

Sinks and Fixtures - 1977-2016

© Camera

▼ Fire Extinguisher

— Copper Lines w/Lead Solder

Alpha



CHARLIE

Sample LC 202

2 1/2" Gal. Cold

2 1/2" Cu. Cold


2" Cu. Hot

Feed lines to 1977 Building

1 1/2" Cu. Hot

BRAVO

DELTA

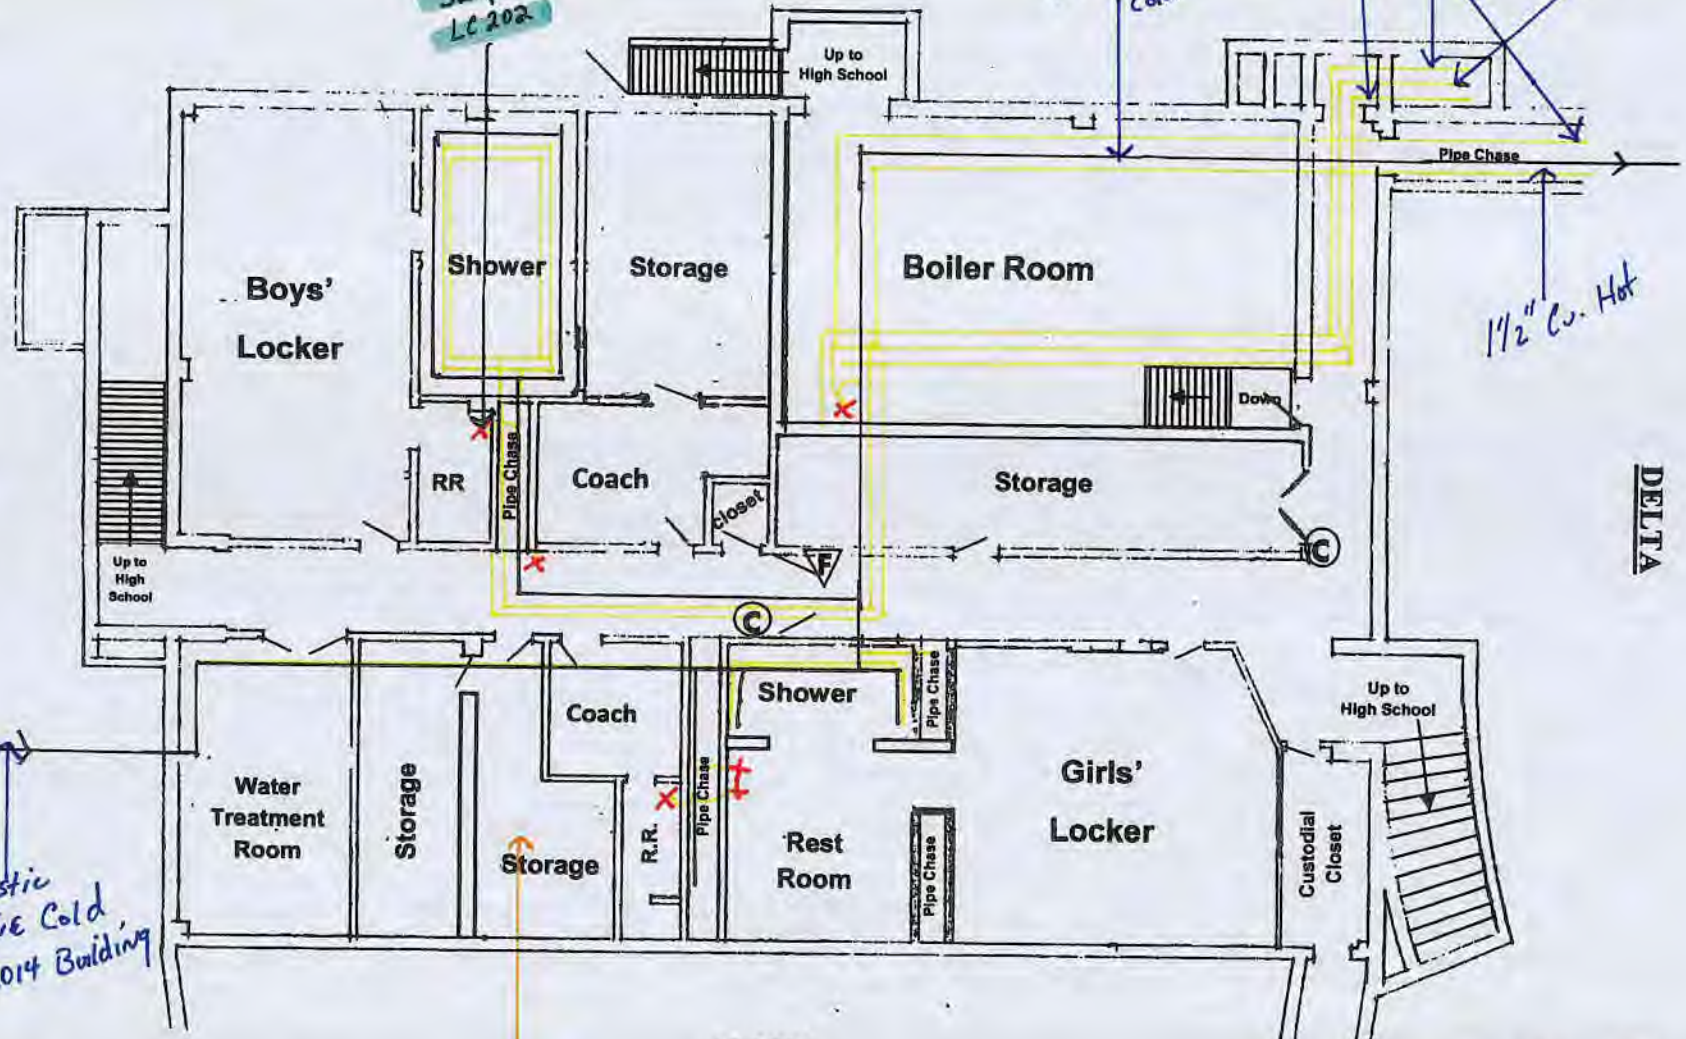

3" Plastic Feed line Cold from 2014 Building

1950 Building

ALPHA

Sinks and Fixtures 1950-2016

F Fire Extinguisher

C Camera

— Copper Lines Lead Solder

— Galvanized Pipes

X Sinks

Cory-Rawson High School—Basement

3930 County Road 26, Rawson, Ohio 45881

District IRN: 047431, Building IRN: 007401

Phone: 419-963-3415 Maintenance: W. Young 419-722-1801