


RE: LHS Maumee Youth Center
Report
Drinking Water Program
Henry County
PWS ID: OH3500912

WATER HOUSE

LHS MAUMEE YOUTH CENTER
U-469 W RD 1D
LIBERTY CENTER, OHIO
43532



RANDY MCGARTHY
419.376.2825

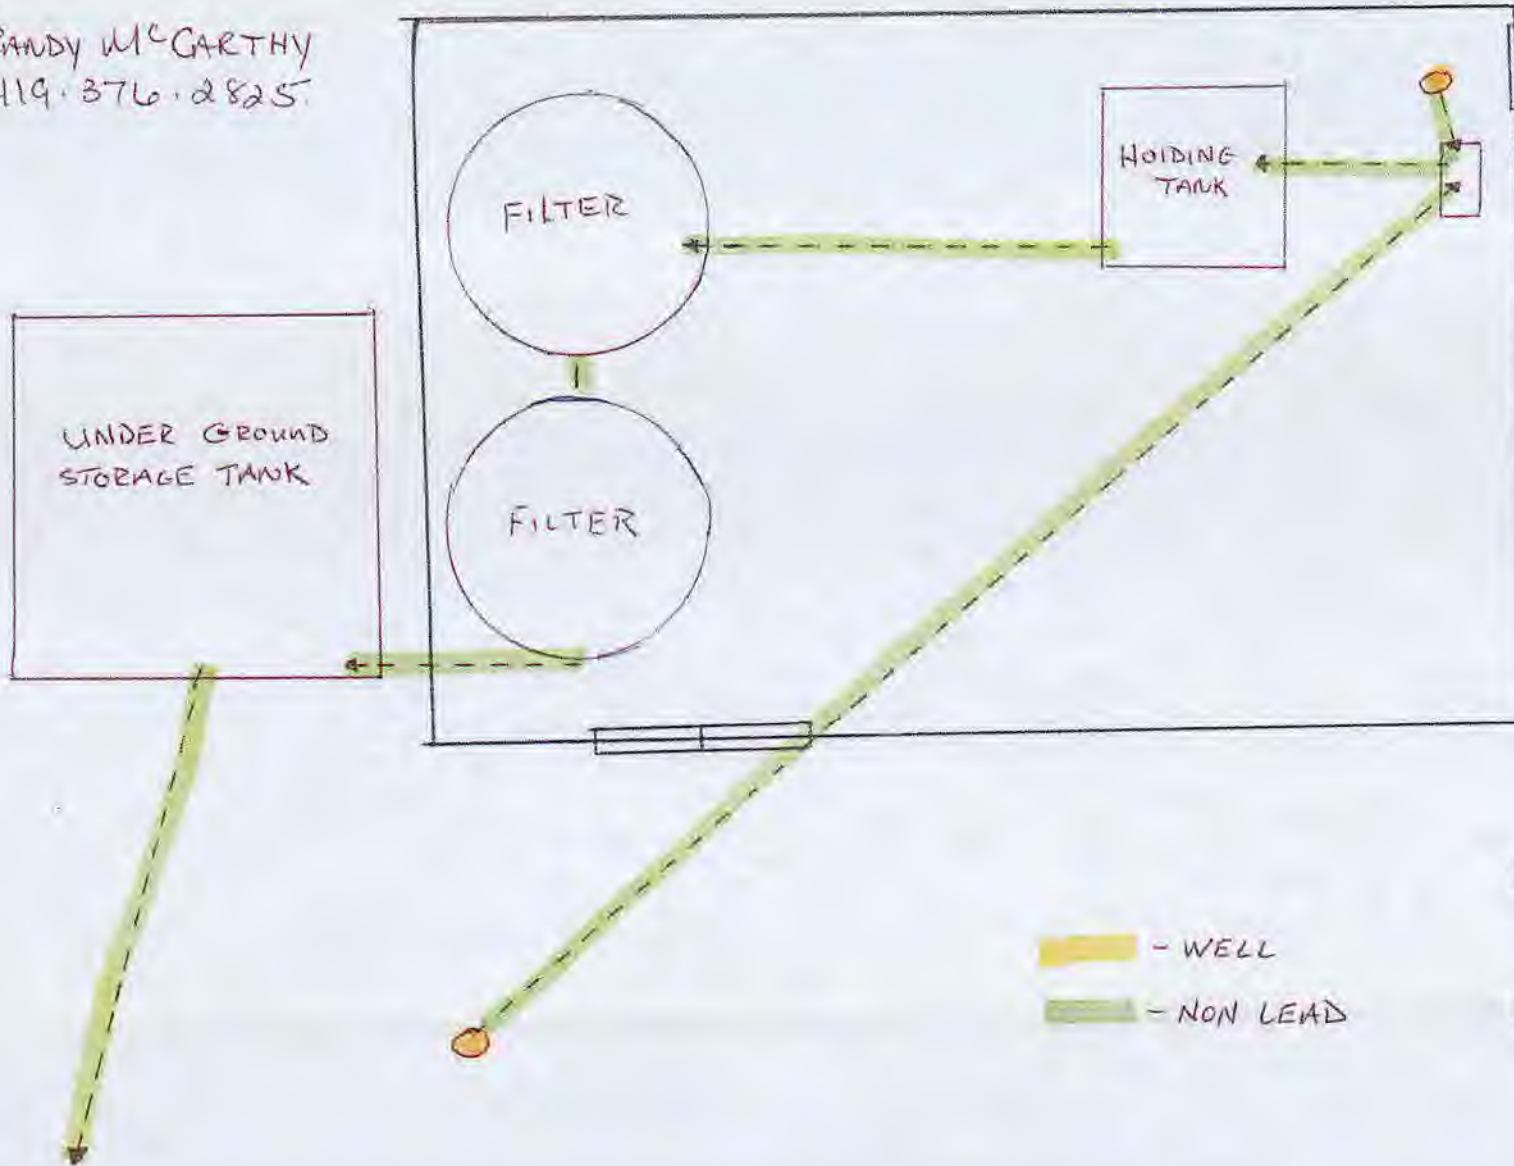


RECEIVED

MAR 01 2017

DDAGW - NWDO

MAINTENANCE BUILDING

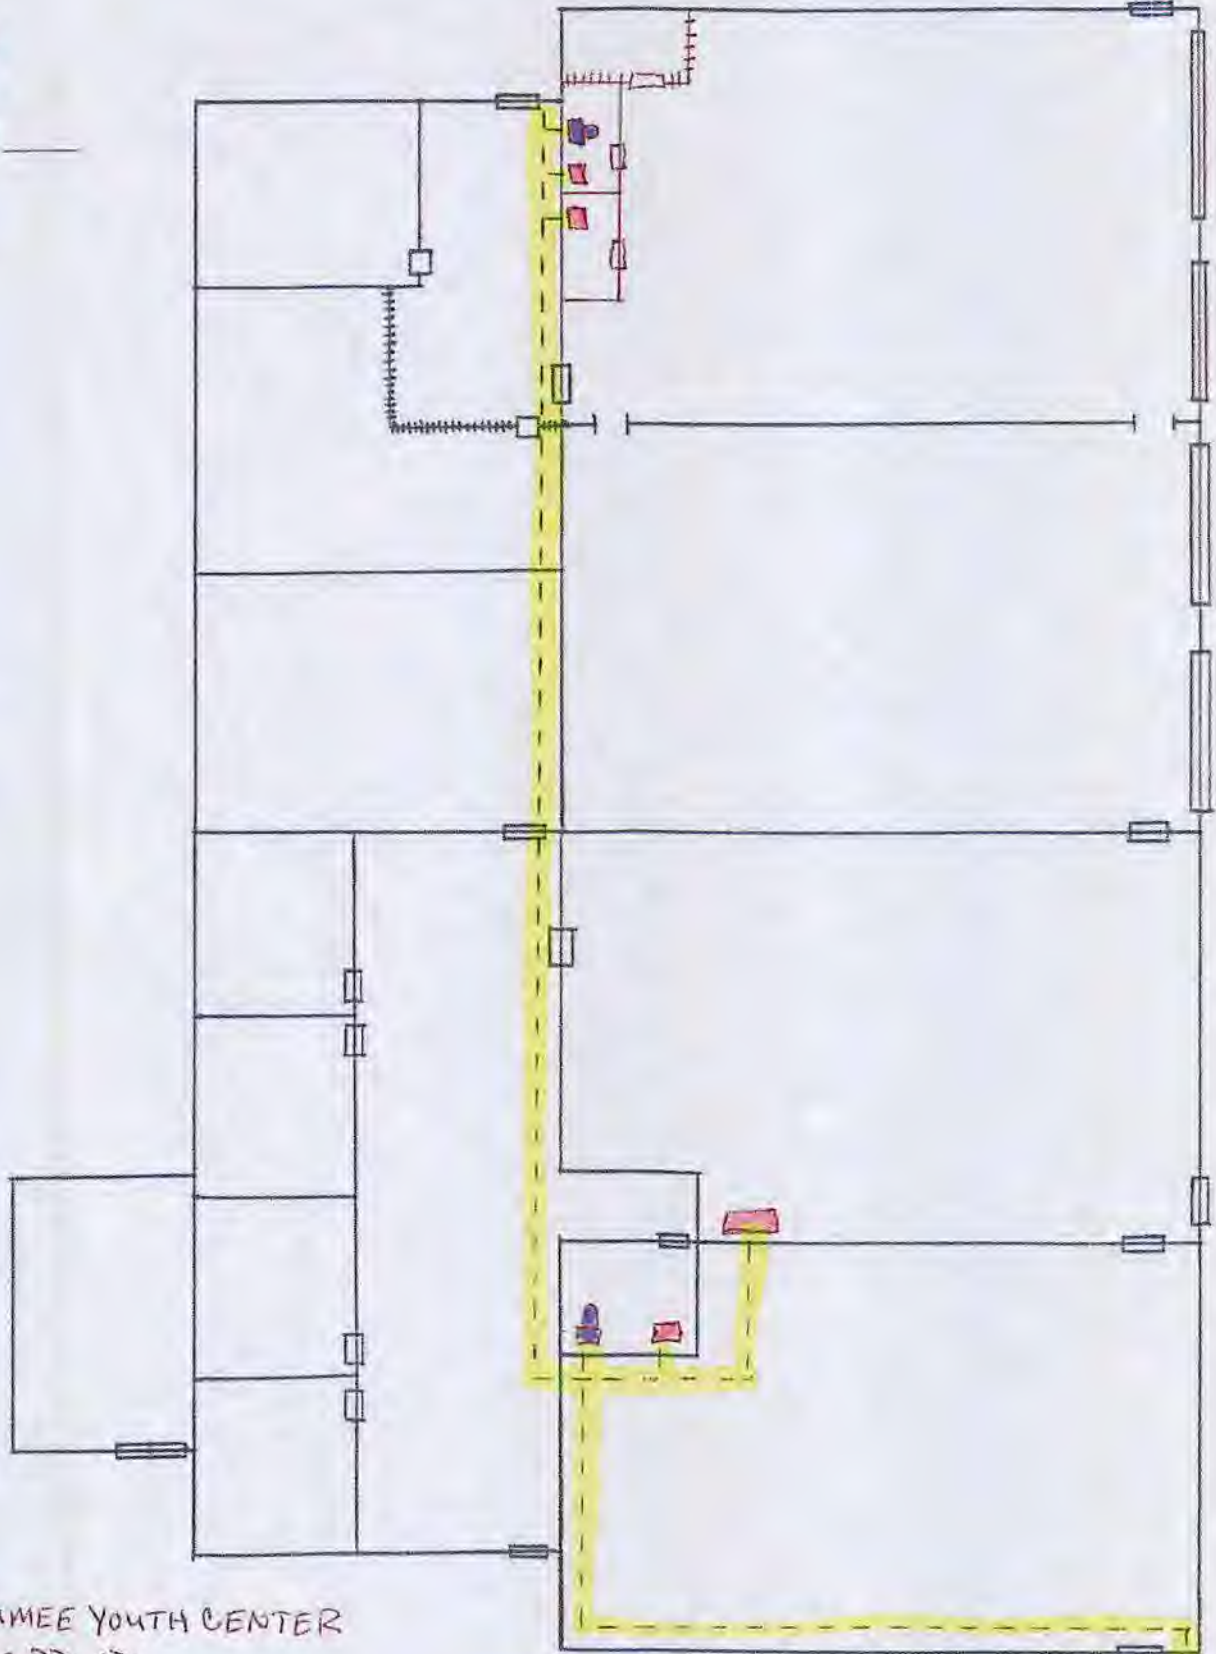


LHS MAUMEE YOUTH CENTER
4469 CO RD 1D
LIBERTY CENTER, OHIO
43532

RAUDY MCCARTHY
119-276-2625

- - - - - LEAD
- - SINK
- - TOILET

COLD WATER ONLY

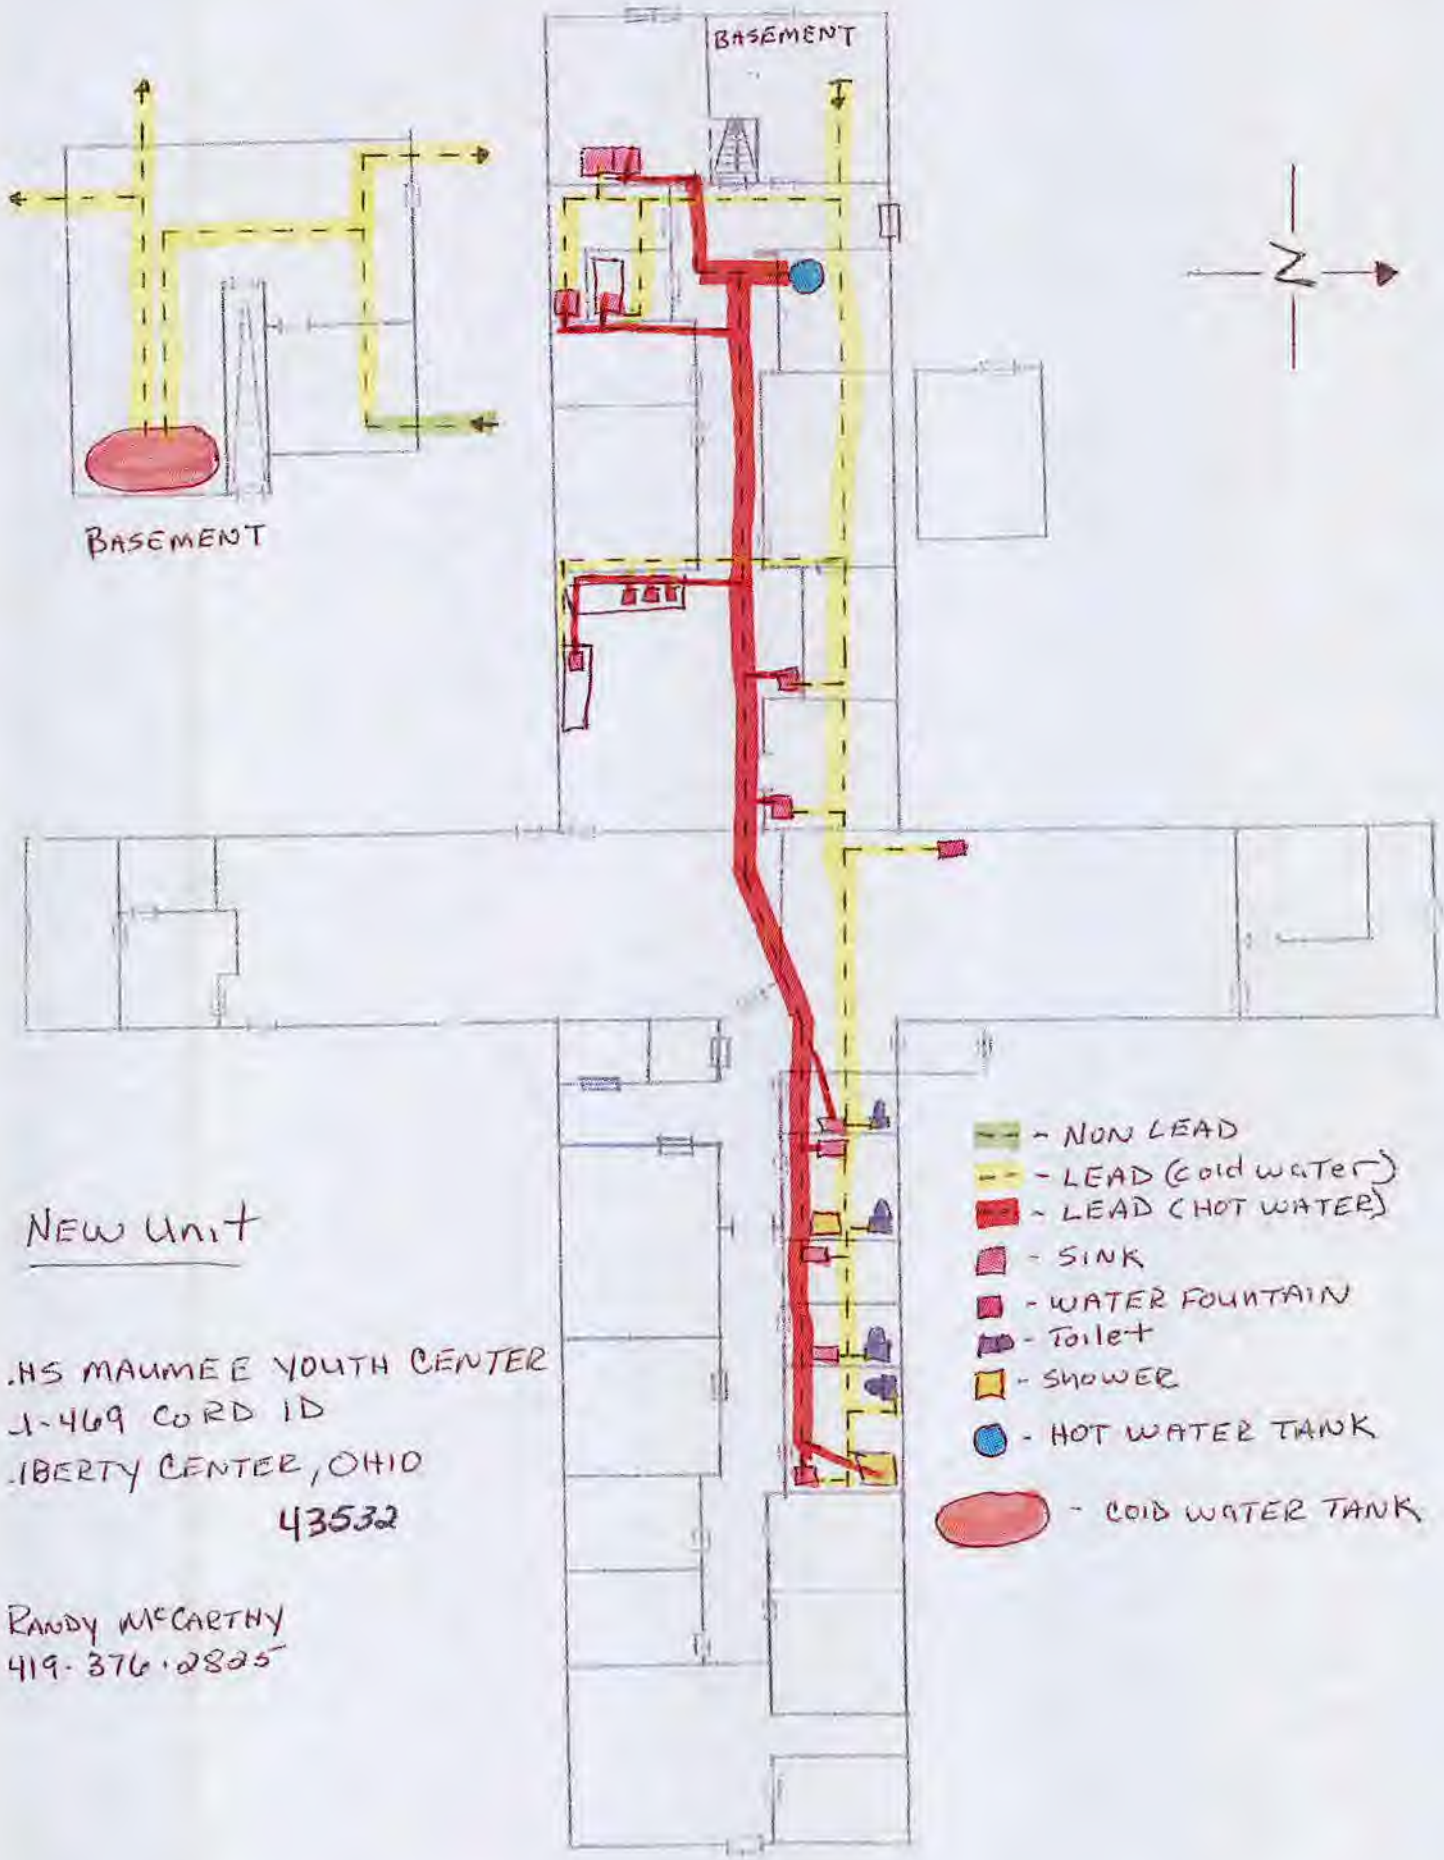

NEW Unit

.HS MAUMEE YOUTH CENTER
 J-469 CORD ID
 LIBERTY CENTER, OHIO
 43532

RANDY MCCARTHY
 419-376-2825







- NON LEAD
- LEAD (COLD WATER)
- LEAD (HOT WATER)
- SINK
- WATER FOUNTAIN
- TOILET
- SHOWER
- HOT WATER TANK
- COLD WATER TANK




SCHOOL

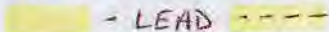
LHS MAUMEE YOUTH CENTER
U-469 Co RD 1D
LIBERTY CENTER, OHIO
43532

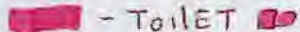RANDY MCCARTHY
419-376-2825

-  - LEAD
-  - HOT WATER TANK
-  - SINK
-  - TOILET
-  - URINAL
-  - WATER FOUNTAIN


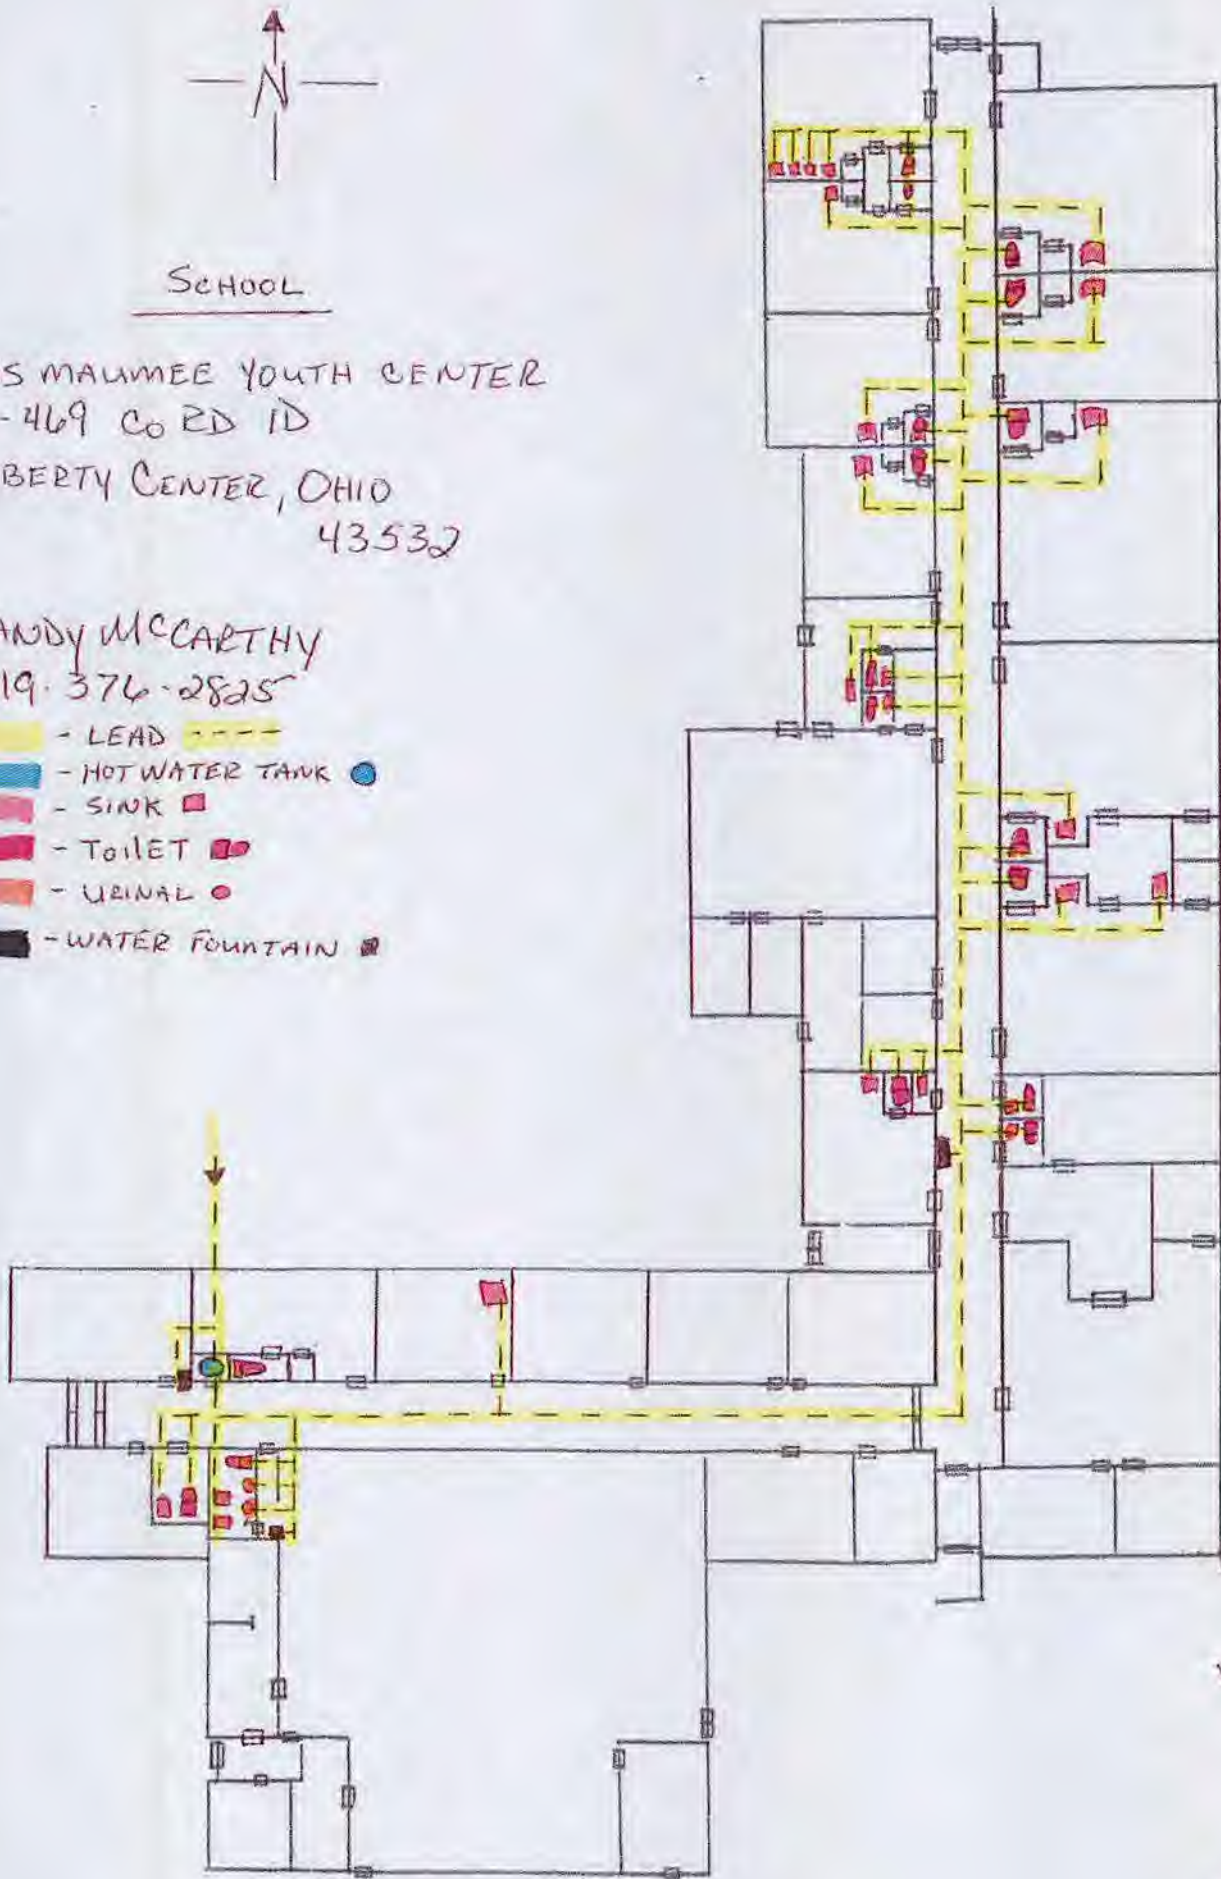




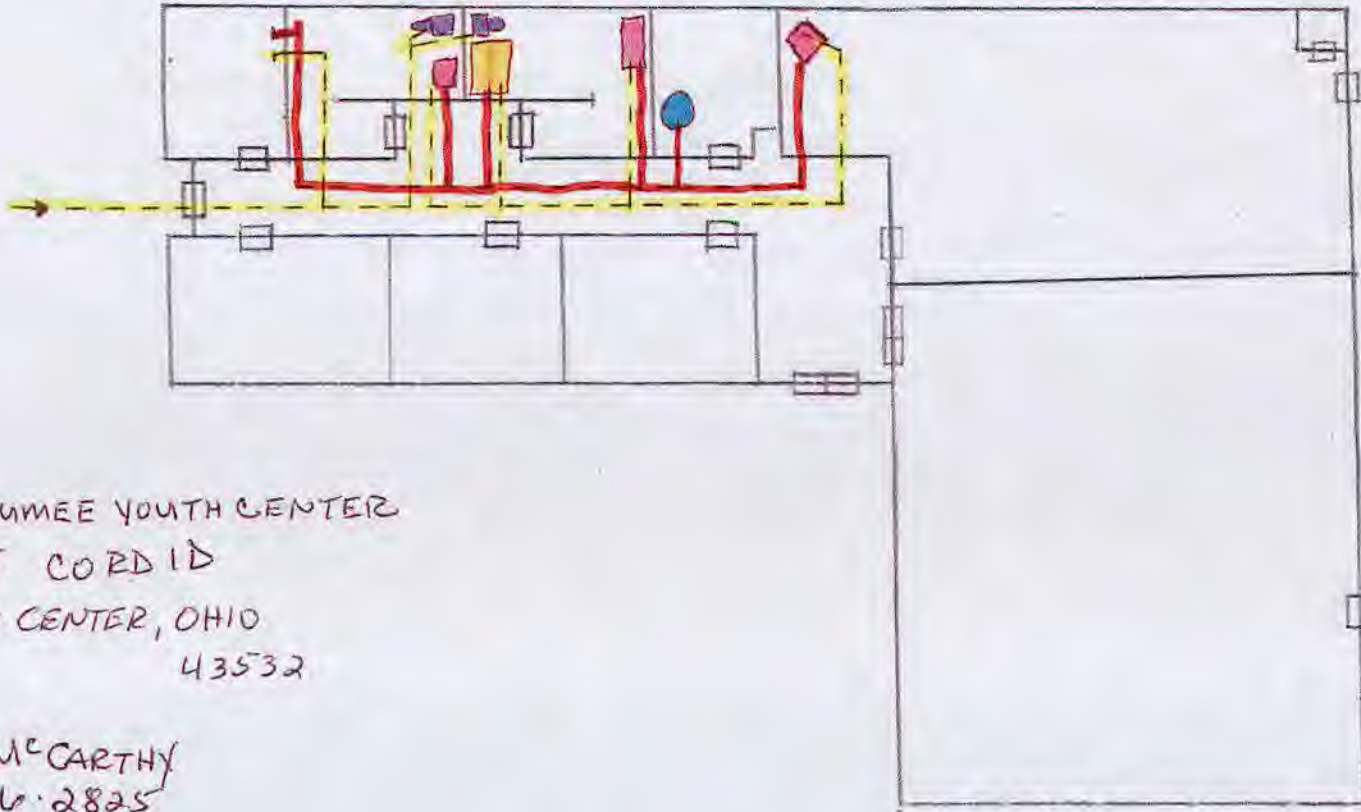

CHURCH

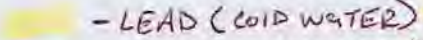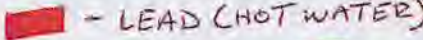


LHS MAUMEE YOUTH CENTER
4505 CORD RD
LIBERTY CENTER, OHIO
43532

RAUDY MCCARTHY
419-376-2825




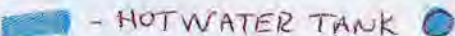
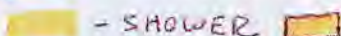
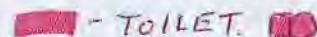

-  - LEAD (COLD WATER)
-  - LEAD (HOT WATER)
-  - SHOWER
-  - SINK
-  - TOILET
-  - HOT WATER TANK

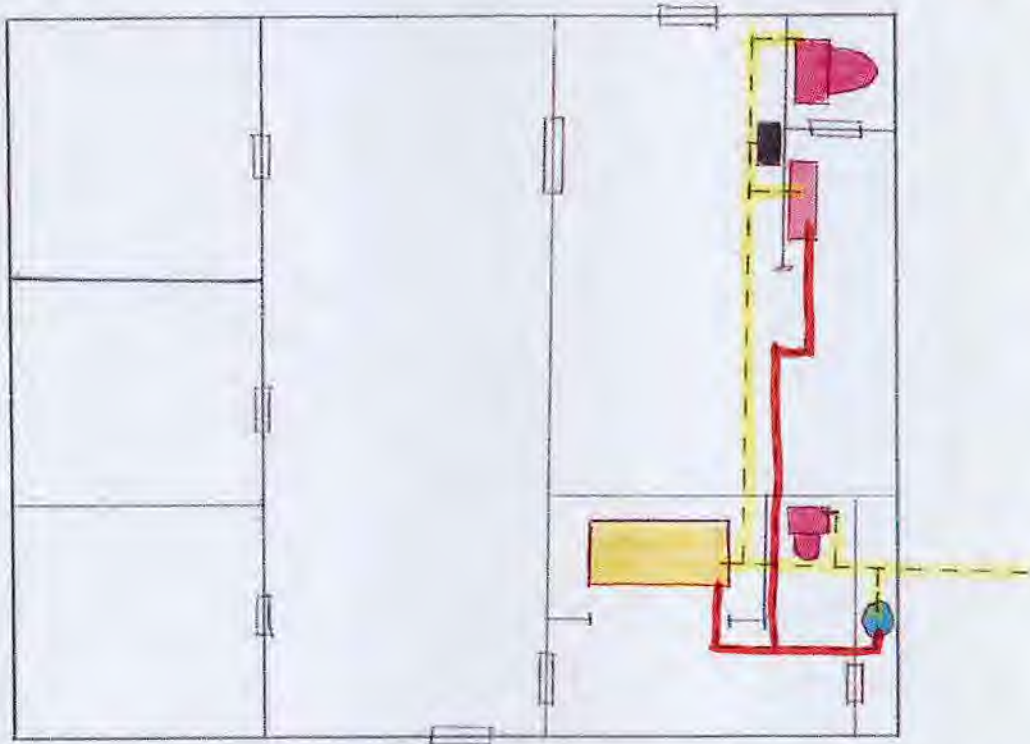NORTH HOUSE




LHS MAUMEE YOUTH CENTER
U-469 CO RD 1D
LIBERTY CENTER, OHIO
43532

RANDY MCCARTHY
419-376-2825

-  - LEAD (COLD WATER)
-  - LEAD (HOT WATER)
-  - WATER FOUNTAIN
-  - HOT WATER TANK
-  - SHOWER
-  - TOILET
-  - SINK

LIVING UNIT

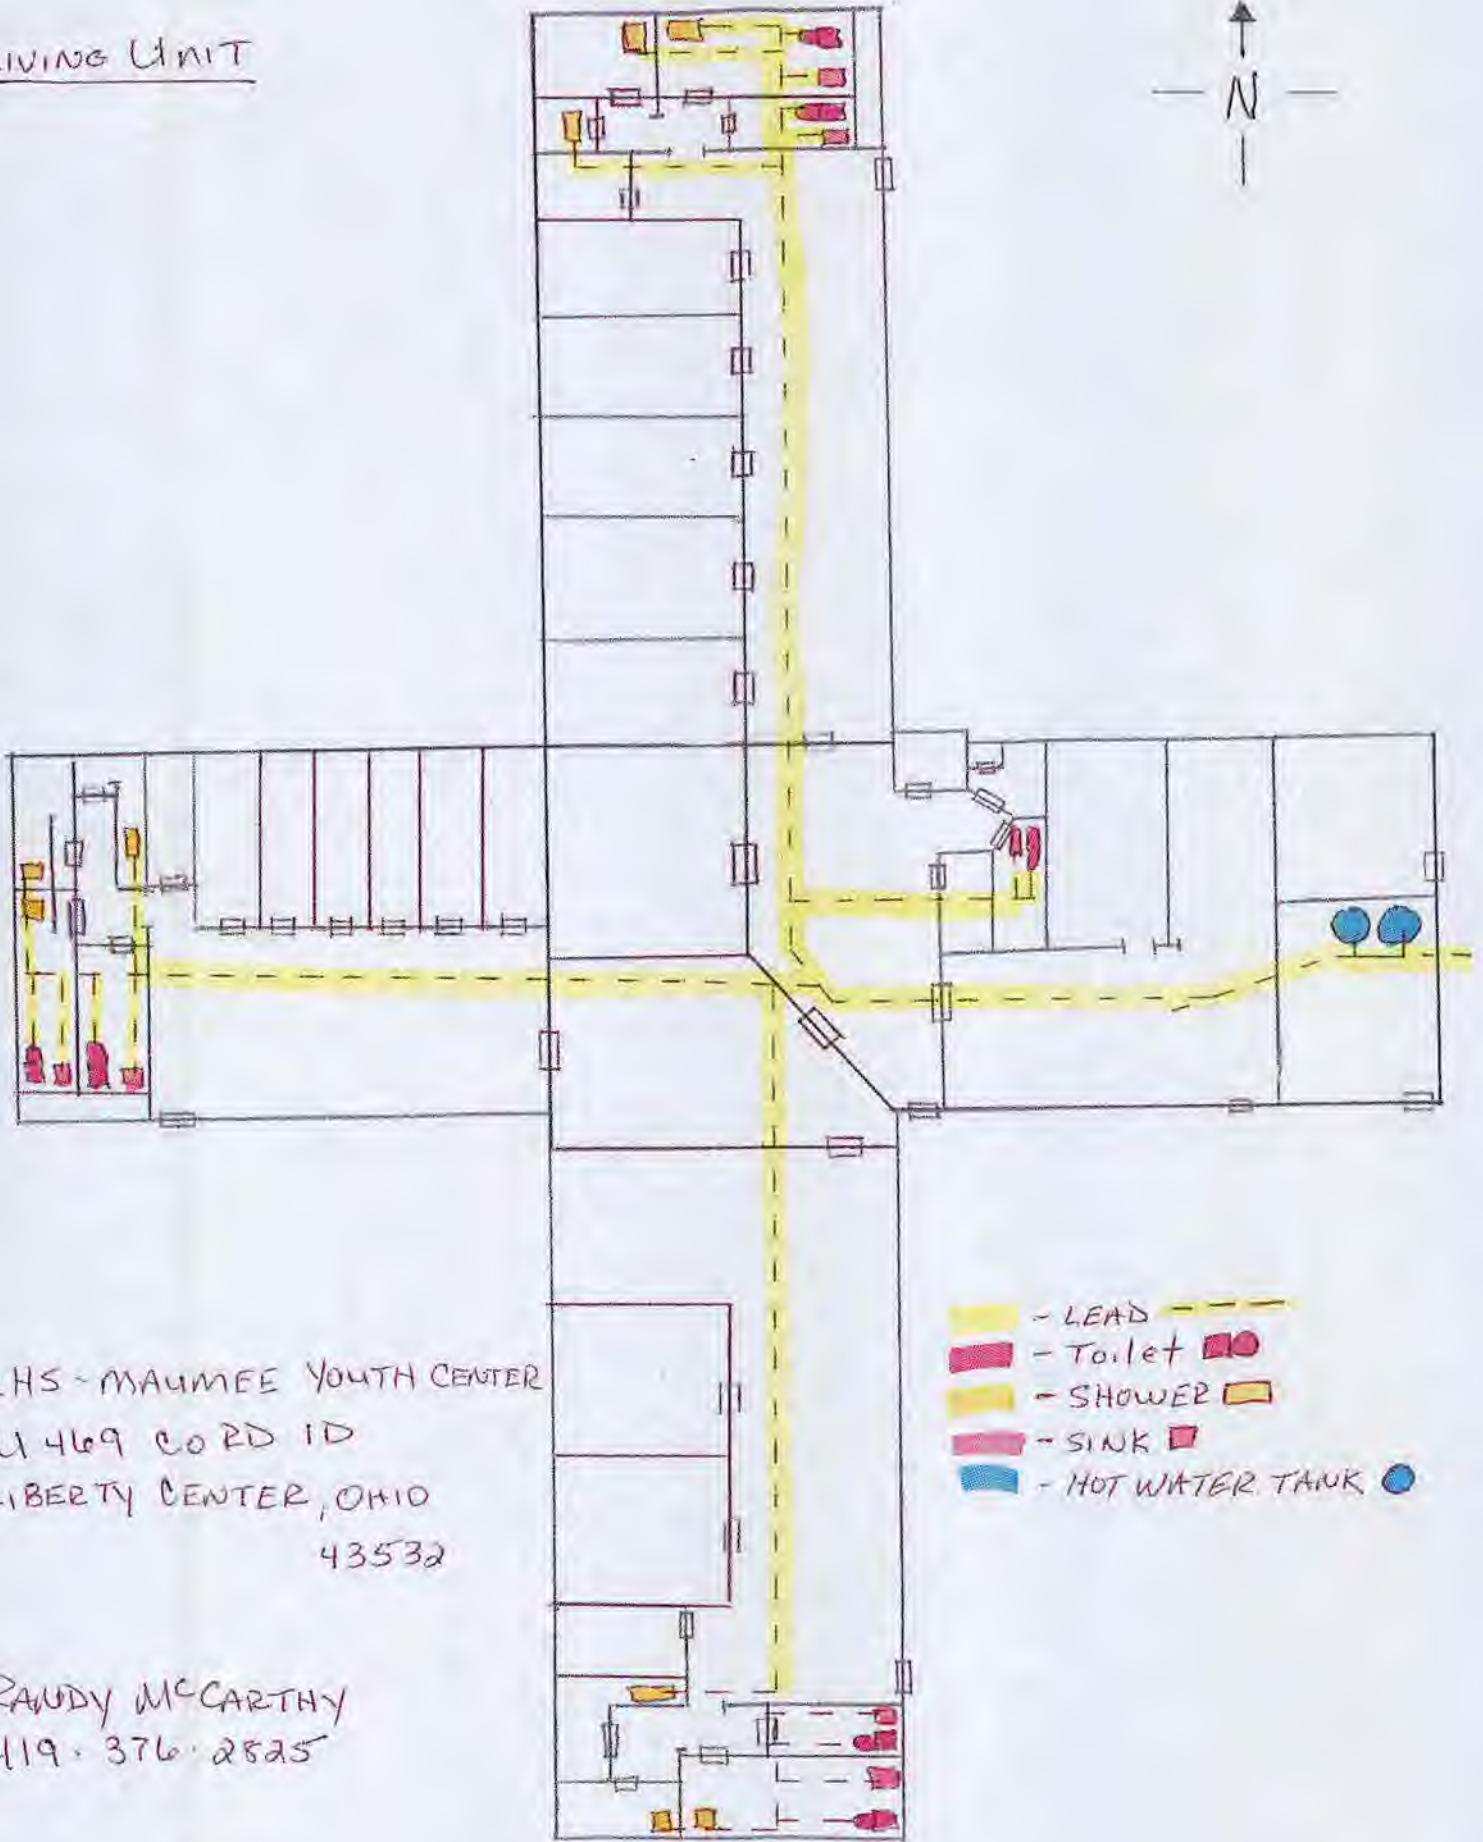


LHS - MAUMEE YOUTH CENTER
U 469 CORD ID
LIBERTY CENTER, OHIO
43532

RAUDY MCCARTHY
419.376.2825





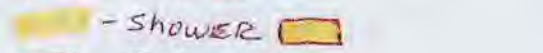

- LEAD (yellow dashed line)
- Toilet (red square)
- SHOWER (yellow rectangle)
- SINK (pink square)
- HOT WATER TANK (blue circle)

South House

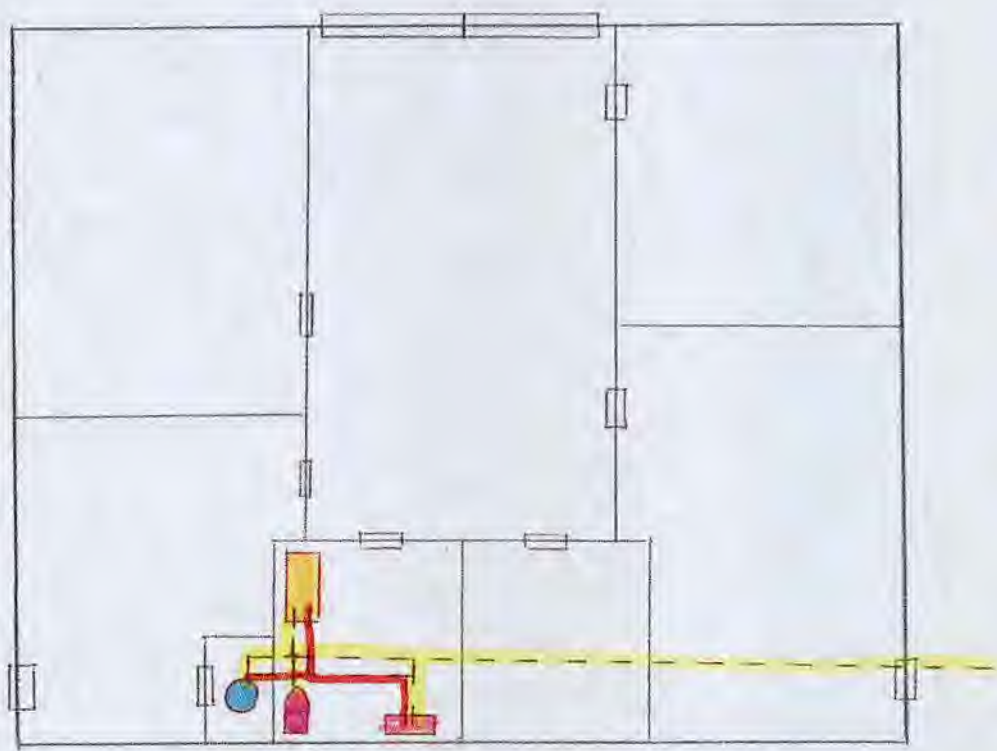


LHS MAUMEE YOUTH CENTER
W-469 CO RD 1D
LIBERTY CENTER, OHIO
43532

RANDY MCCARTHY
419-376-2825

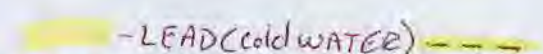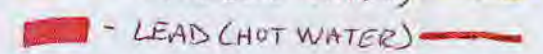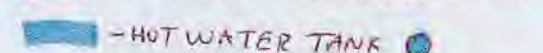



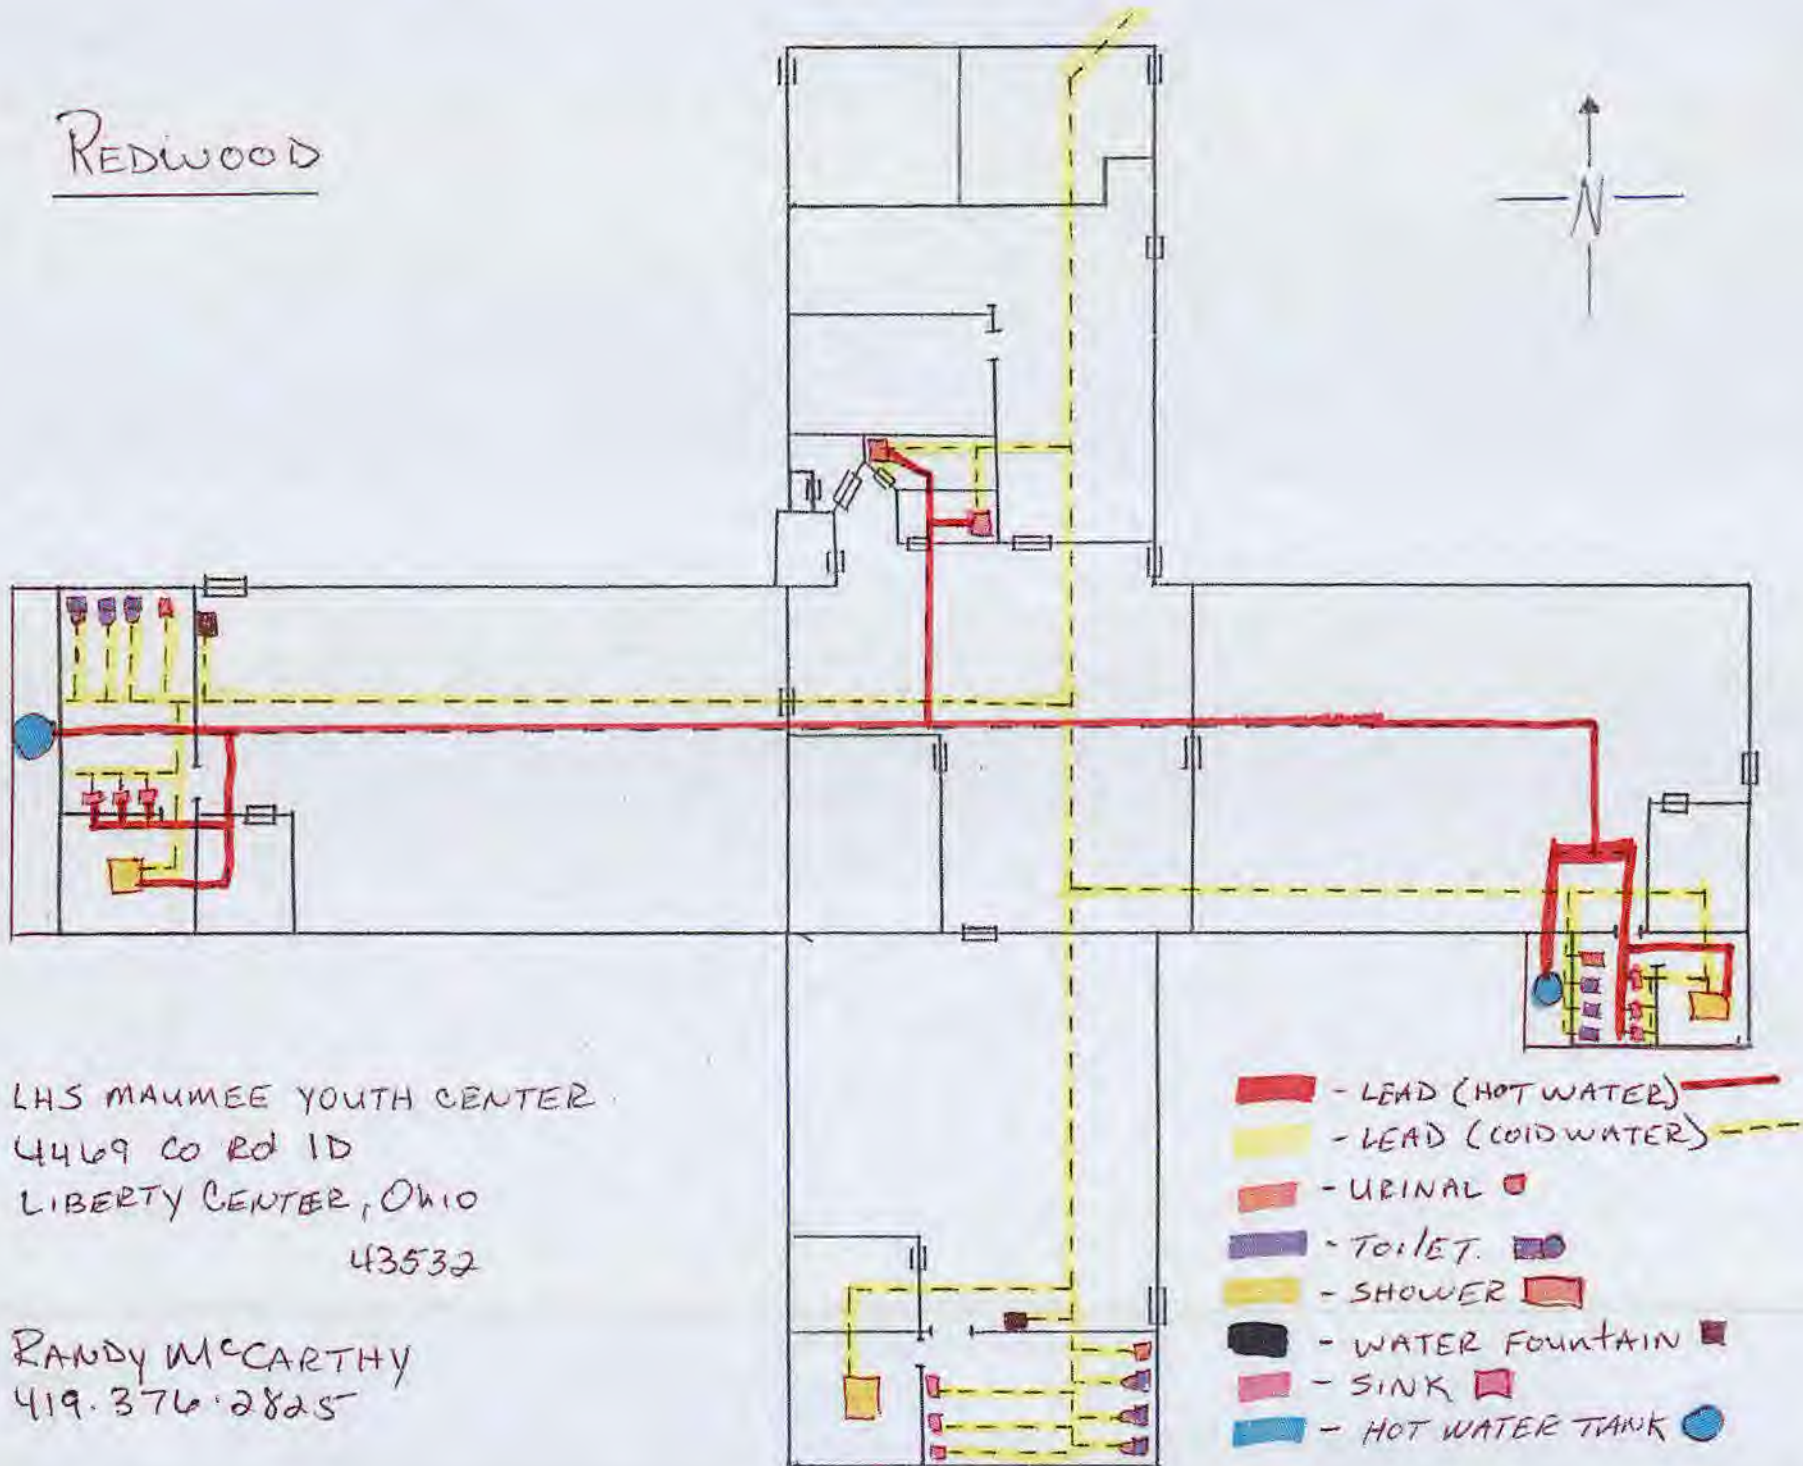



-  - LEAD (COLD WATER)
-  - LEAD (HOT WATER)
-  - HOT WATER TANK
-  - SINK
-  - SHOWER
-  - TOILET

REDWOOD



LHS MAUMEE YOUTH CENTER
4469 CO RD 1D
LIBERTY CENTER, OHIO
43532

RANDY MCCARTHY
419.376.2825




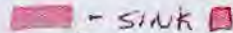



-  - LEAD (HOT WATER)
-  - LEAD (COLD WATER)
-  - URINAL
-  - TOILET
-  - SHOWER
-  - WATER FOUNTAIN
-  - SINK
-  - HOT WATER TANK


4379 MODULAR



HS MAUMEE YOUTH CENTER
1379 CO RD 1D
LIBERTY CENTER, OHIO
43032

ZANDY MCCARTHY
419.376.2825

-  - NON LEAD
-  - TOILET
-  - HOT WATER TANK
-  - SINK
-  - WASHER
-  - TUB / SHOWER
-  - Dishwasher

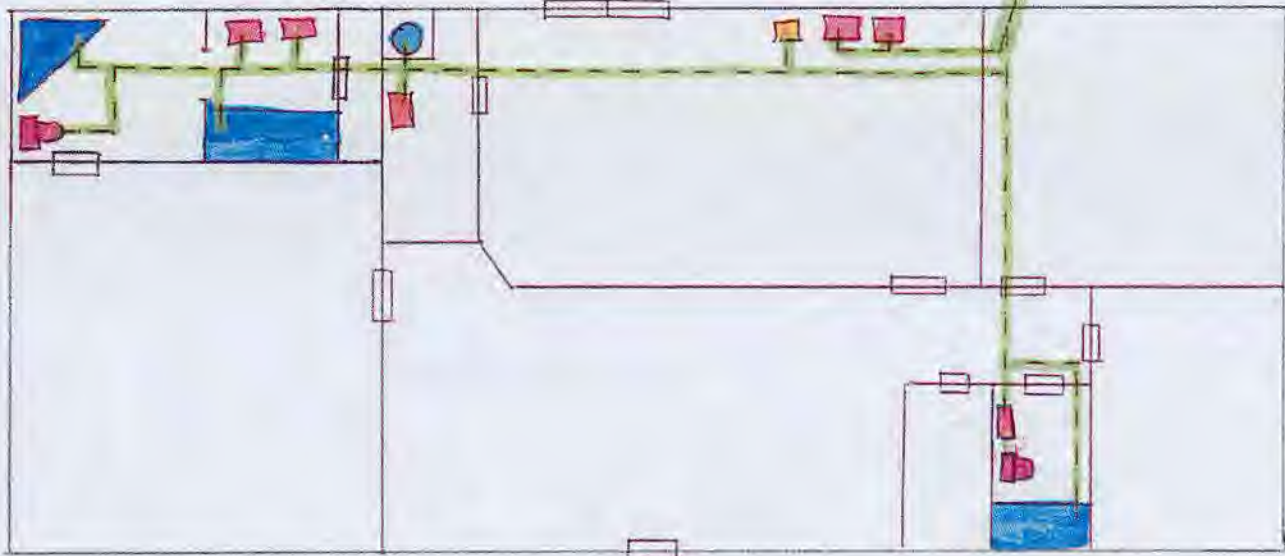


CO RD 1D

LHS
MAUMEE YOUTH CENTER
4373 CO RD 1D
LIBERTY CENTER, OHIO
43532


RANDY MCCARTHY
419.376.2825

4373 MODULAR

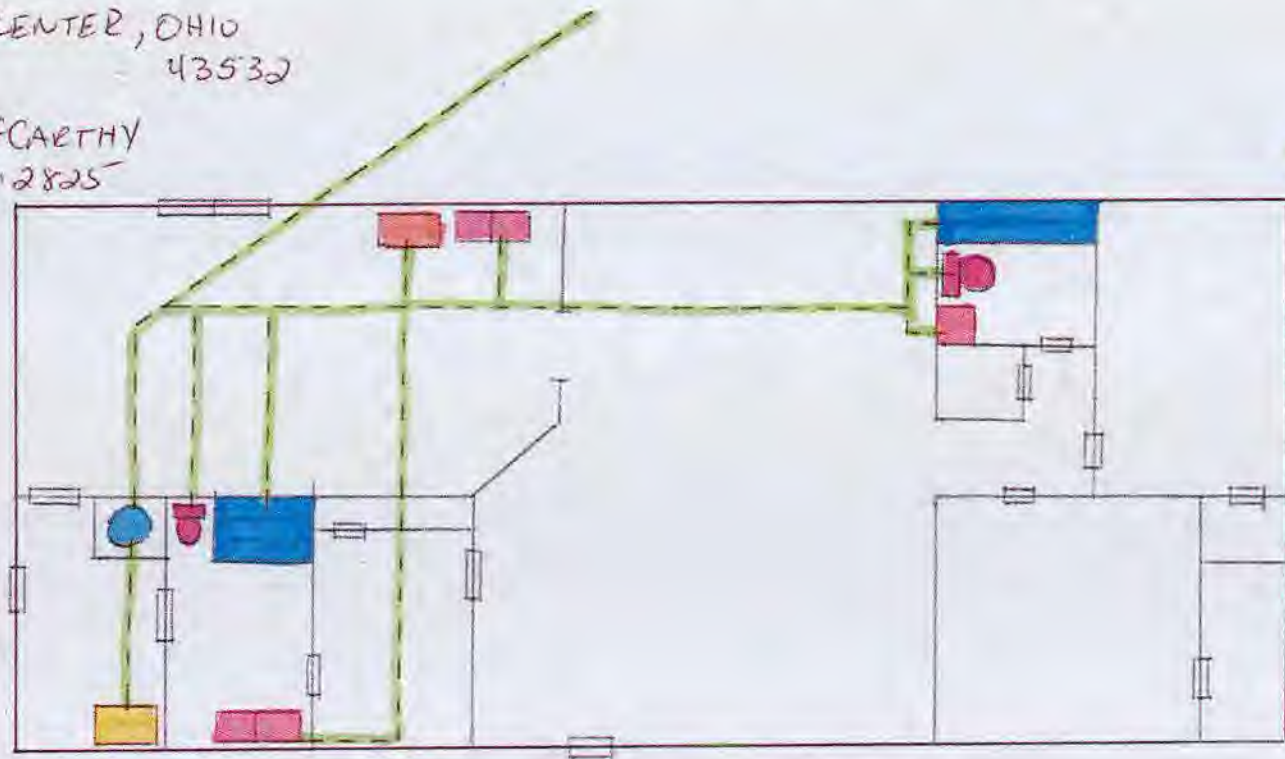

-  - NON LEAD
-   - HOT WATER TAN
-   - SINK
-   - TOILET
-   - WASHER
-   - TUB / SHOWER
-   - DISHWASHER



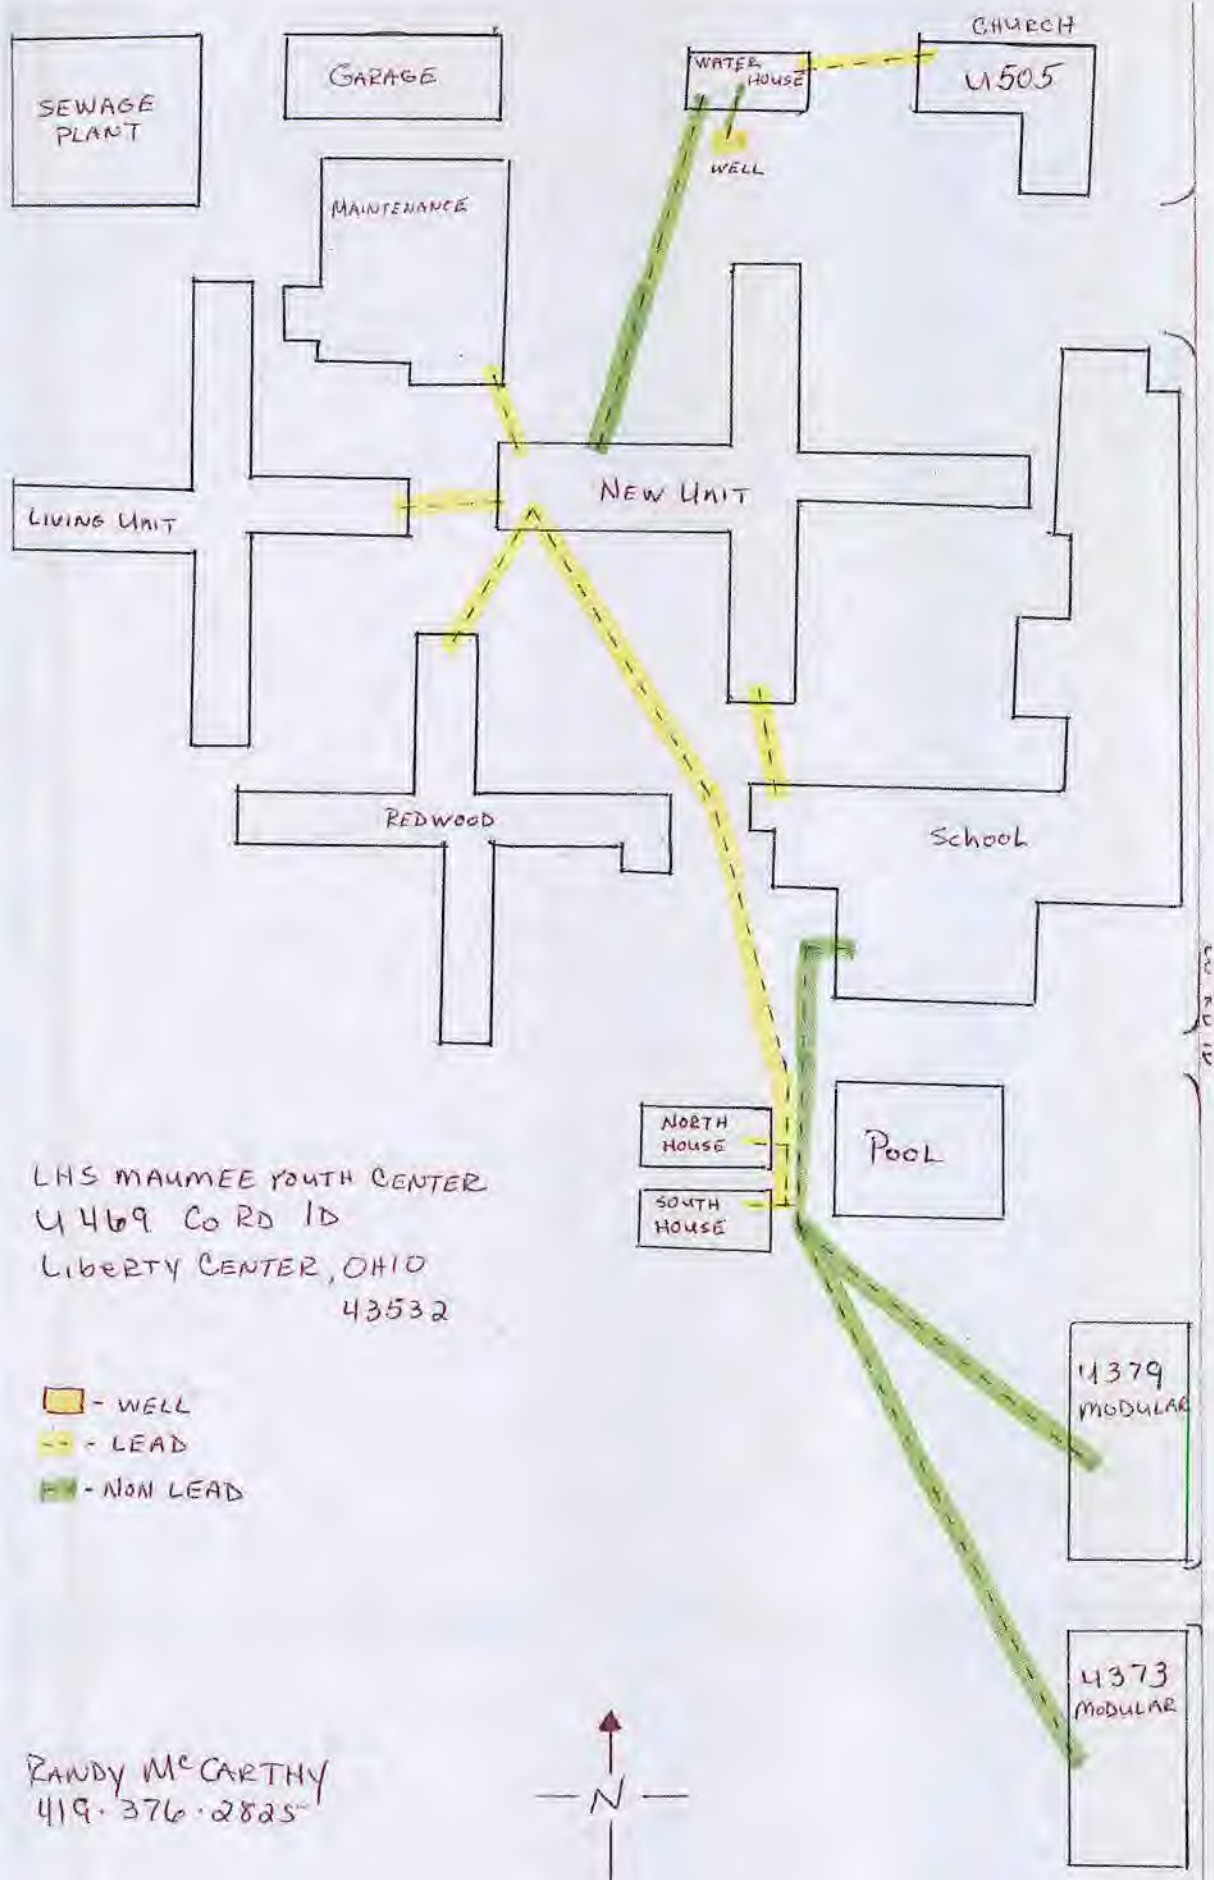

LHS MAUMEE YOUTH CENTER
 U 469 Co RD 1D
 LIBERTY CENTER, OHIO
 43532

- WELL
- LEAD
- NON LEAD

RANDY MCCARTHY
 419-376-2825

