

RE: Maurers Mobile Home Park
Report
Drinking Water Program
Wood County
PWS ID: OH8701412

I have been employed by Maurers approximately since 1974. I have been involved with or responsible for repairing water line leaks and breaks too numerous to remember. All lines that have been exposed and repaired have been Sch 20 blue plastic. Most lot still have 1" plastic feeding them with a 3/4 galvanized riser and 3/4 brass valve. Any lot riser leaks have been replaced with plastic line and brass valves. There are no lead service lines in our park.

In previous lead and copper sampling we have marked our testing sample sites as other. Most of the mobile homes in our park have plastic lines on the residents side. The homes that do have copper lines do not have soldered connections as flare and compression connections were the common practice. We have not observed any soldered connections in any homes. Some homes still have copper lines connecting their homes to the valves we supply in the water crocks, those are flare connections also.


I have contacted wood co building inspection, wood county health dept, state of Ohio health dept, and the Ohio mobile home commission. They have purged their files of our records. I am including copies of an original Ohio dept of health data sheet showing water line sizing and marked if plastic NSF approved. We also have a copy of a health dept. letter showing that item #6 that we were installing plastic lines.

I am also including pictures of the last couple of line repairs showing plastic in ground. There are also pictures of left over pipe from the original install.

We hope this satisfies your Requirements.

Alan Steinke

President

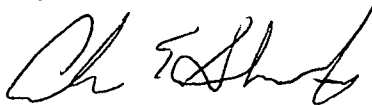

RECEIVED

MAR 01 2017

OHIO E.P.A.
N.W.D.O.

OHIO DEPARTMENT OF HEALTH
HOUSE TRAILER PARK DATA SHEET

Name of Park MAURER'S MOBILE CT. Address 18330 BRIM RD BOWLING GREEN
City or Township CENTER PLAIN County WOOD

Owner EARL MAURER Designer _____
Reg. Engr. ___ Arch. ___ Contractor ___ Other ___

Exact Location TWO MILES NORTH OF BOWLING GREEN OHIO
ONE MILE WEST
Zoning or Planning Commission Approval Yes No ___

House Trailer Lots
No. of Lots 111 Typical lot size 40 ft x 98 ft.
Min. Area 3130 sq. ft. Shape of lot; rectangular Parallelogram ___
Total area in park 12 acres Paved ramp under each trailer; Yes No ___

Driveways and Walkways
Driveway Width 35 ft. All lots abut a driveway Yes No ___
Driveway Construction, Black Top Concrete ___ 24" walkway from trailer Yes No ___

Auto Parking and Lighting
Parking; In driveway On the lot ___ Artificial lighting; at least 0.3 foot
candles provided; Yes No ___

Water Supply
Source of water; Public ___ Private Type of material _____
If plastic, N.S.F. approved; Yes No ___
Size of main water line 2 inches Number of trailers served 111 *
Size of secondary water line 1 1/4 inches Number of trailers served _____ *
Size of secondary water line 1 1/4 inches Number of trailers served _____ *
Size of lot service line 1 inches
Detail of individual water connection provided; Yes No ___
Adequate valves provided to isolate system for repairs; Yes No ___
Distance between water line and sewer line 10 ft.

*Include all trailers that must be served by water from this main.
(If additional space is needed, please supply additional information on the back)
111

Sewerage
Public sewer system available; Yes ___ No
Size of main sewer line 8 inches
Type of material TILE
Premium joint connections; Yes No ___
Detail of lot connection provided; Yes No ___

Garbage and Refuse
Garbage and/or refuse containers provided on each lot; Yes No ___
Central container racks provided; Yes ___ No
Frequency of collection TWICE weekly

JAMES A. RHODES, Governor

State of Ohio

EMMETT W. ARNOLD, M.D.
Director of Health

450 East Town Street
P.O. Box 118
Columbus, Ohio 43216



Department of Health

111 West Washington
Bowling Green, Ohio
43402

PUBLIC HEALTH COUNCIL
Mr. Von H. Klepinger
Chairman
Richard V. Brunner, D.D.S.
Vice Chairman
J. Howard Holmes, M.D.
Ralph K. Ramsayer, M.D.
J. F. Mear, Ph.G.
Phillip T. Knies, M.D.
Lloyd E. Larrick M.D.

RECEIVED

MAR 01 2017

OHIO E.P.A.
N.W.D.O.

re: Wood County
Plain Township
Maurer Trailer Park Addition

June 5, 1969

Mr. Robert Jones
Consulting Engineer
Napoleon, Ohio 43545

Dear Mr. Jones:

On May 28, 1969, detail plans were received for the addition to the Maurer Trailer Park.

Following is a list of additional items required for approval:

- 1) Tertiary waste treatment will be required and should be included in overall waste treatment plant design. Please detail the complete plant on one drawing.
- 2) Also, please show the complete park layout with both new and existing lots.
- 3) Data sheets should all be signed and dated.
- 4) The lot detail should include complete construction specs.
- 5) Please include sewer specifications, manholes specifications and details.
- 6) Water lines should be looped and increased in size. Serving 32 families from a single 1 1/2" dead end plastic lines is not considered good design.
- 7) Please include a letter of first phase completion from the Wood County Health Department
- 8) We will collect a water sample for chemical analysis in order to determine the need for treatment. Disinfection will be required and should be included in the design. Also please include the final well development and isolation. Additional storage should also be considered in the design.




2" PLASTIC MAIN
 1 1/4" PLASTIC MAIN
 1" LOT FEED ...
 PLASTIC

1/2


RECEIVED
 MAR 0 1 2017
 OHIO E.P.A.
 N.W.D.O.

* This map is not a survey-grade map or legal document. This map is solely provided for reference. *

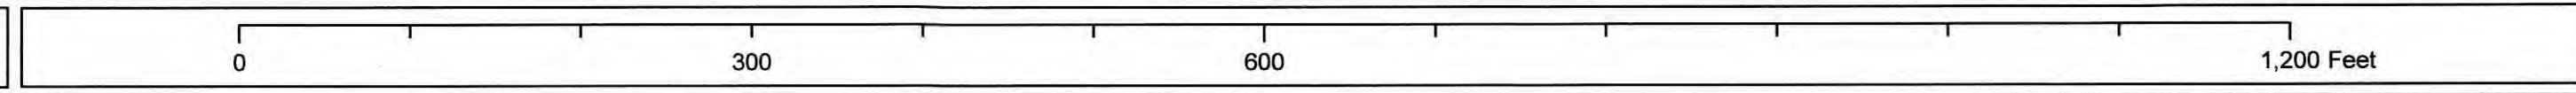

1:1,200
 1 inch = 100 feet

Product of the Wood County Auditor's Office: GIS Department
 Map Date: February 6, 2016; Orthophotography: April 2014
 Auditor Michael Sibbersen

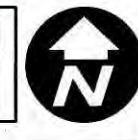

-- Maurer Mobile Home Court, Plain Twp, Wood County, Ohio --