

LEAD MAPPING-IN DISTRIBUTION

(ALL ONE FLOOR)


 330-637-7906
 OH-7900712

NTNE

ORIGINAL
 EXISTING BUILDING (1974)
 TIER 2

LEGEND

- POSSIBLE LEAD SOLDER (COPPELINES)
- LEAD FREE BUILDING
- SAMPLE TAP LOCATIONS
- HOT FIXTURE
- COLD FIXTURE
- WATER HEATER
- WELL (ONE SERVICE LINE) COPPER

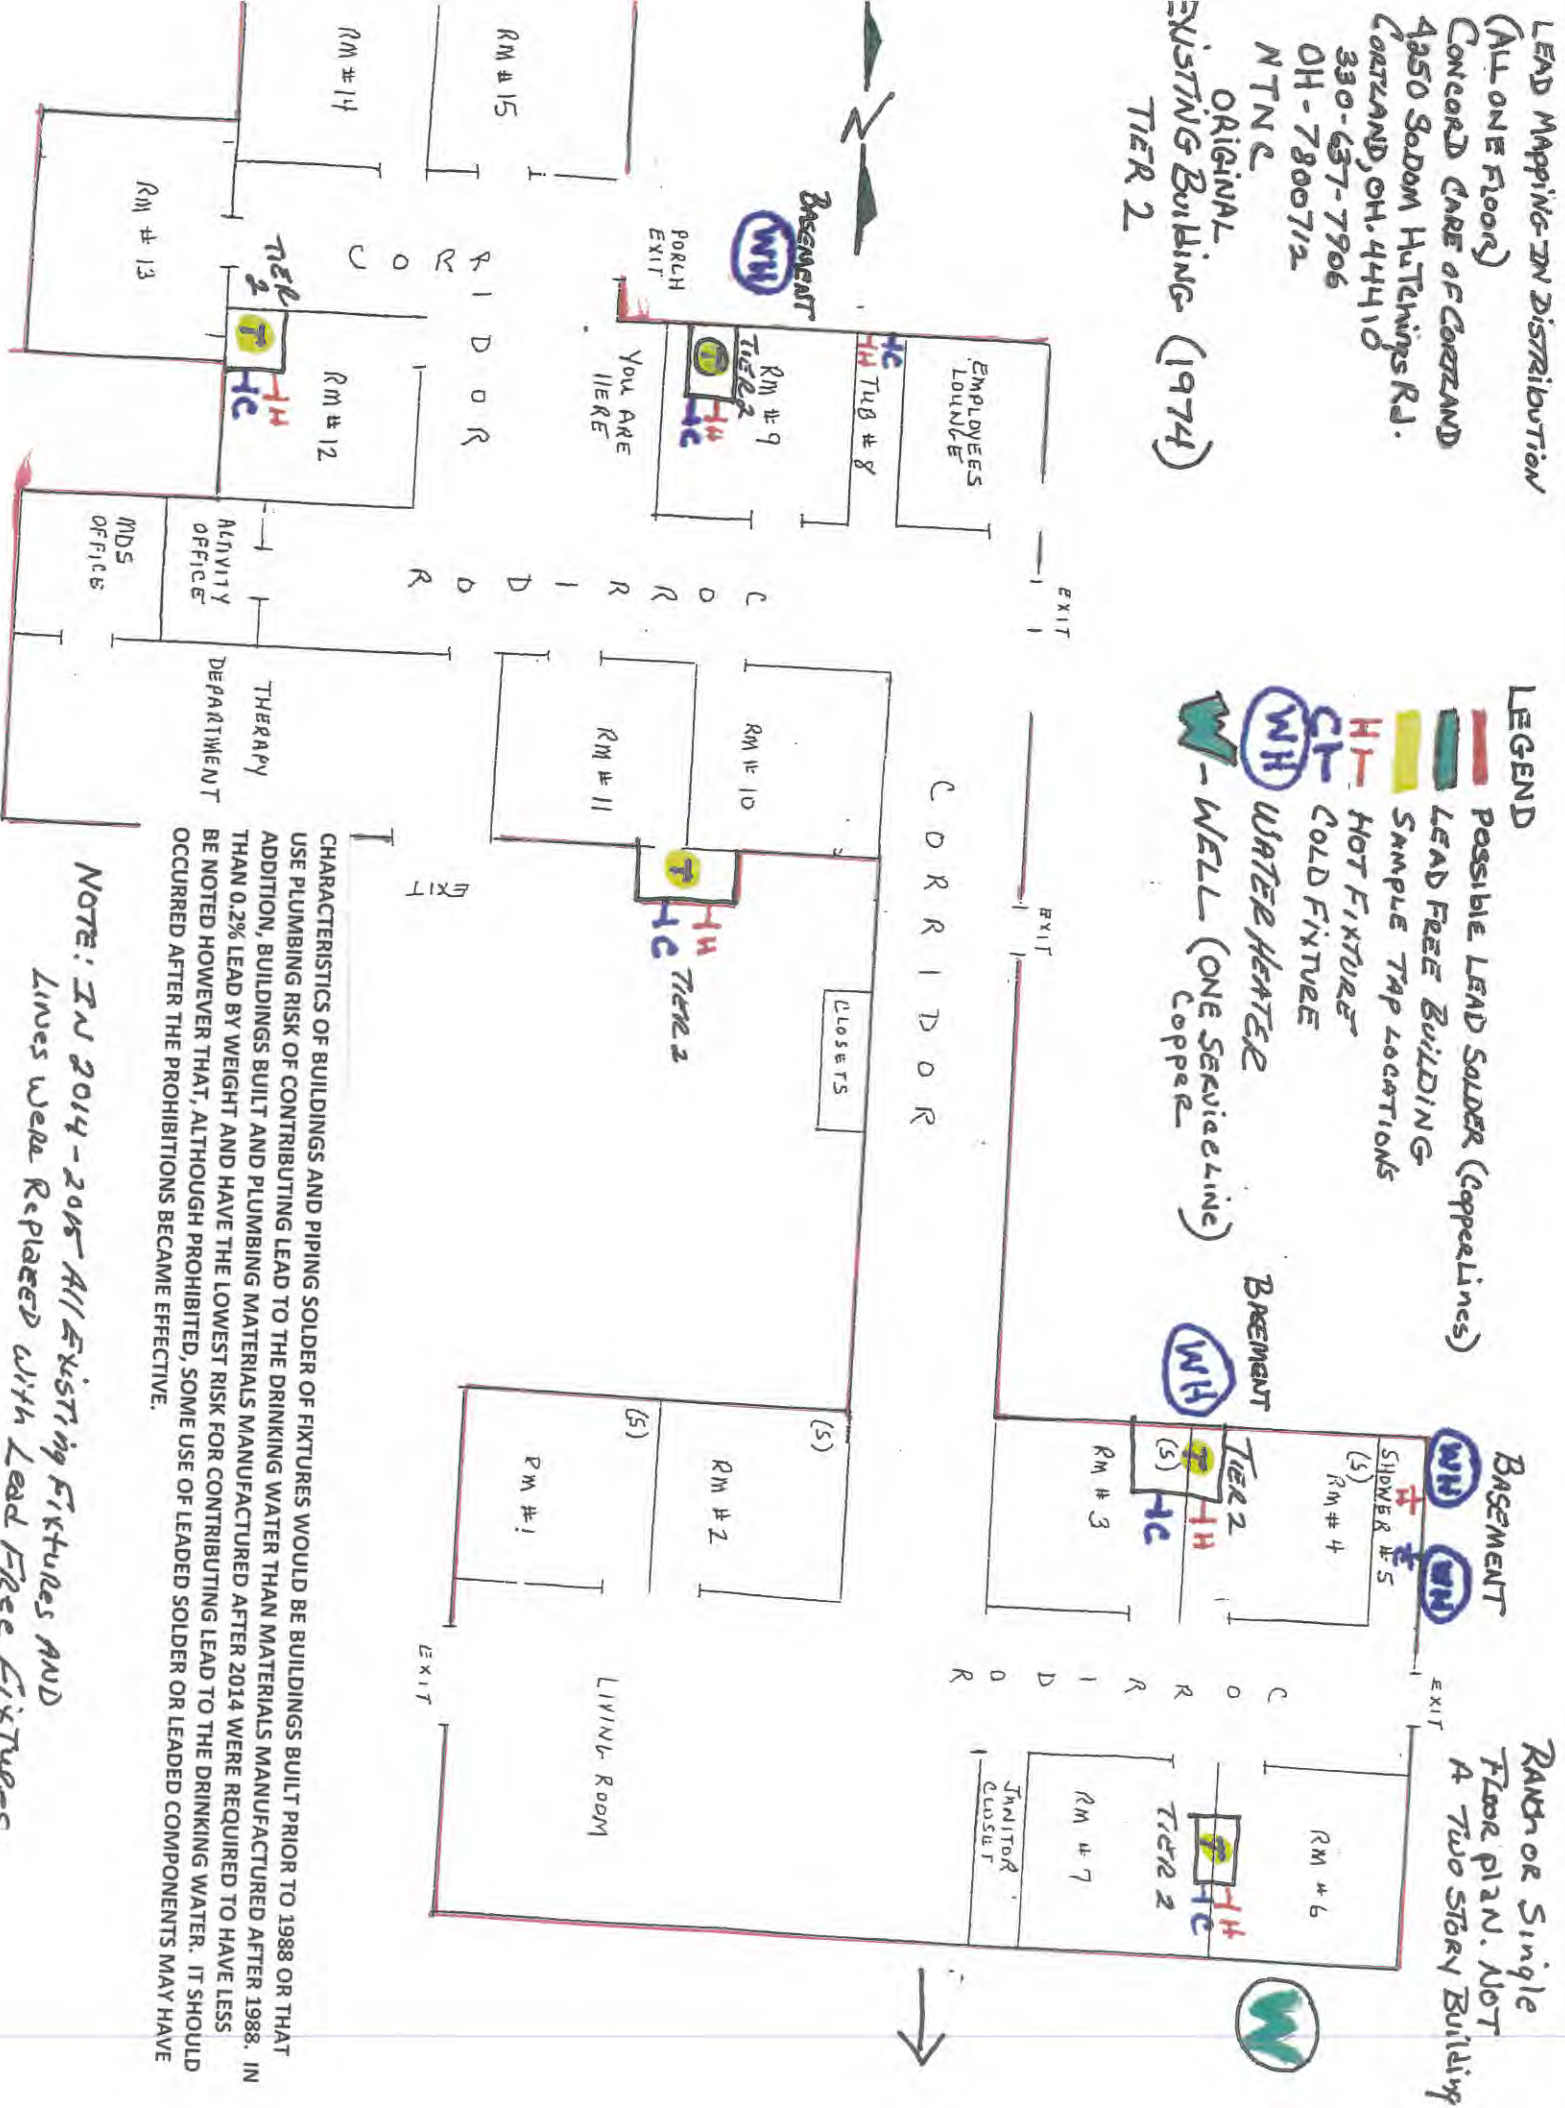




 FLOOR PLAN. NOT
 A TWO STORY BUILDING

CHARACTERISTICS OF BUILDINGS AND PIPING SOLDER OF FIXTURES WOULD BE BUILDINGS BUILT PRIOR TO 1988 OR THAT USE PLUMBING RISK OF CONTRIBUTING LEAD TO THE DRINKING WATER THAN MATERIALS MANUFACTURED AFTER 1988. IN ADDITION, BUILDINGS BUILT AND PLUMBING MATERIALS MANUFACTURED AFTER 2014 WERE REQUIRED TO HAVE LESS THAN 0.2% LEAD BY WEIGHT AND HAVE THE LOWEST RISK FOR CONTRIBUTING LEAD TO THE DRINKING WATER. IT SHOULD BE NOTED HOWEVER THAT, ALTHOUGH PROHIBITED, SOME USE OF LEADED SOLDER OR LEADED COMPONENTS MAY HAVE OCCURRED AFTER THE PROHIBITIONS BECAME EFFECTIVE.

NOTE: IN 2014 - 2015 ALL EXISTING FIXTURES AND LINES WERE REPLACED WITH LEAD FREE FIXTURES.

LEGEND

- █ Possible Lead Solder (Copper Lines)
- █ Lead Free Building
- █ Sample Tap Locations
- H Hot Fixtures
- CT Cold Fixtures
- WH Water Heater
- W Well (One Service Line) Copper

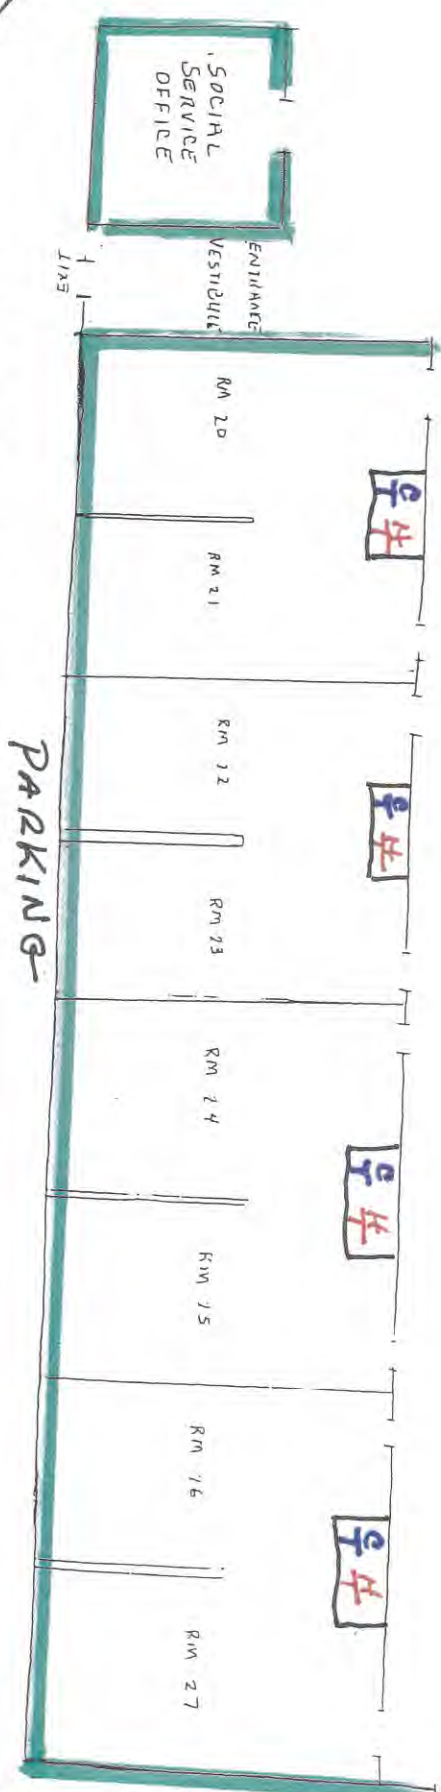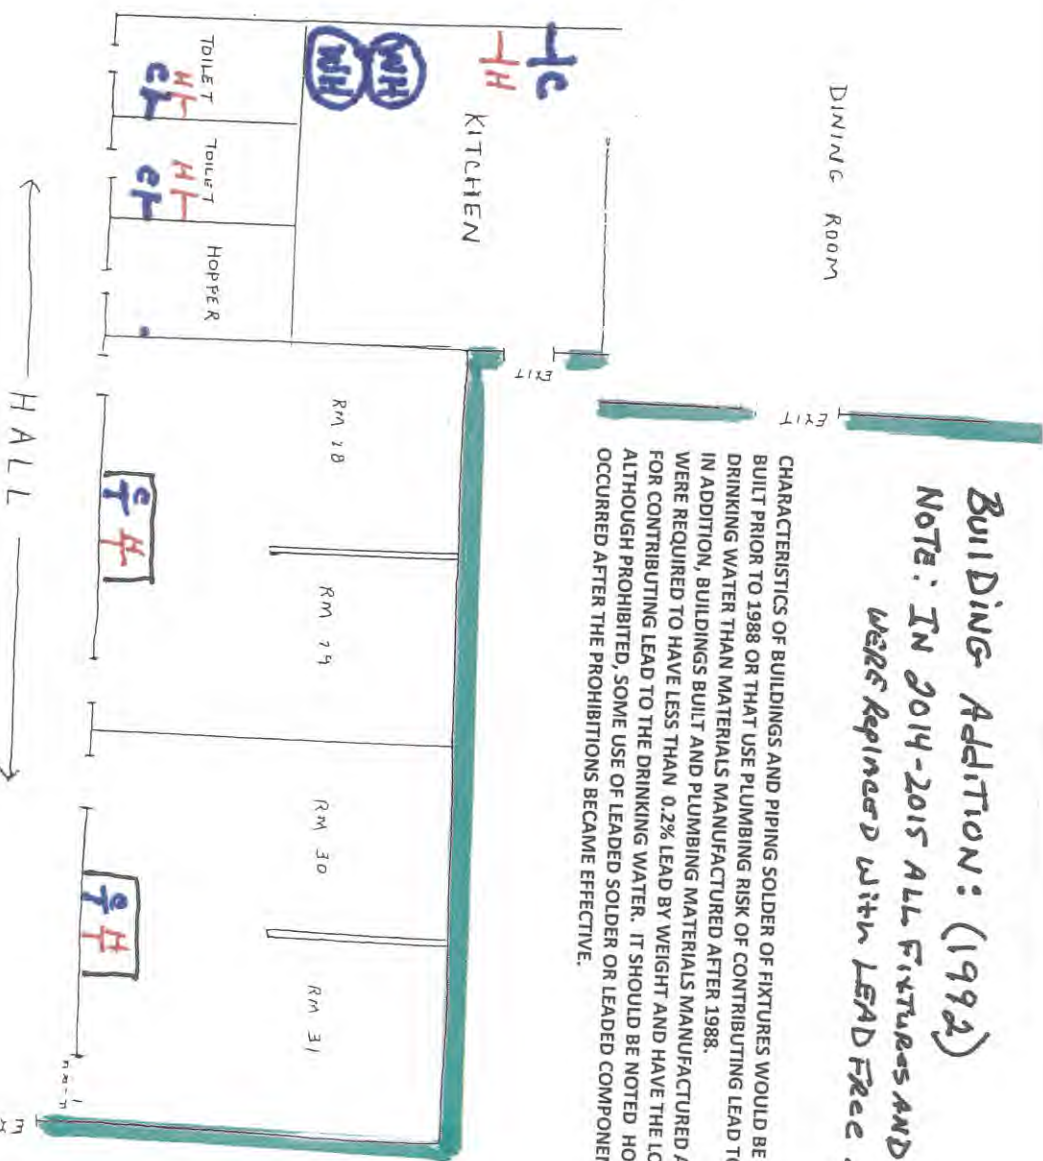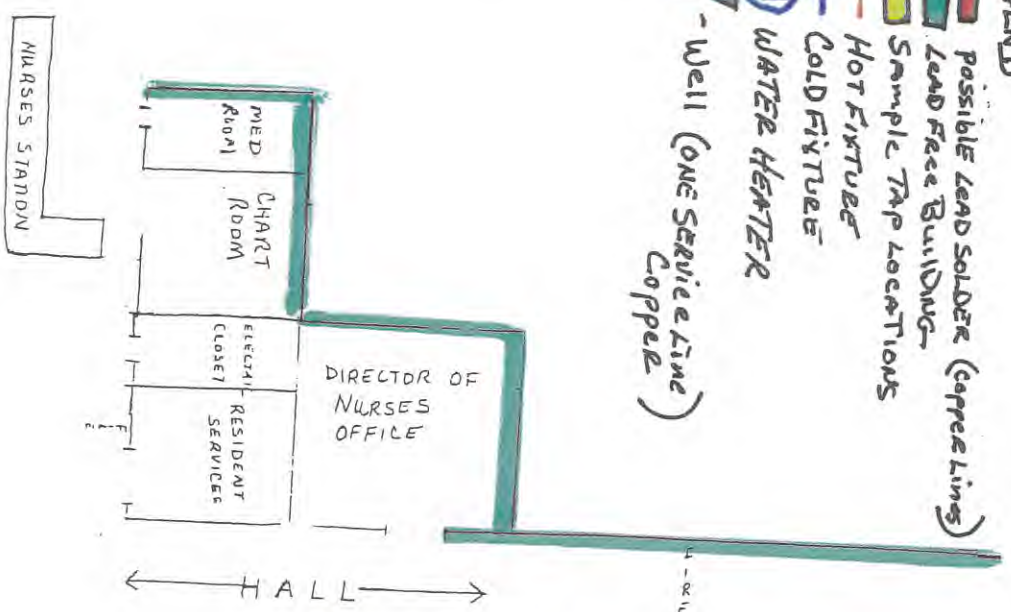

BUILDING ADDITION: (1992)
NOTE: IN 2014-2015 ALL FIXTURES AND LINES WERE REPIPED WITH LEAD FREE.

CHARACTERISTICS OF BUILDINGS AND PIPING SOLDER OF FIXTURES WOULD BE BUILDINGS BUILT PRIOR TO 1988 OR THAT USE PLUMBING RISK OF CONTRIBUTING LEAD TO THE DRINKING WATER THAN MATERIALS MANUFACTURED AFTER 1988. IN ADDITION, BUILDINGS BUILT AND PLUMBING MATERIALS MANUFACTURED AFTER 2014 WERE REQUIRED TO HAVE LESS THAN 0.2% LEAD BY WEIGHT AND HAVE THE LOWEST RISK FOR CONTRIBUTING LEAD TO THE DRINKING WATER. IT SHOULD BE NOTED HOWEVER THAT, ALTHOUGH PROHIBITED, SOME USE OF LEADED SOLDER OR LEADED COMPONENTS MAY HAVE OCCURRED AFTER THE PROHIBITIONS BECAME EFFECTIVE.

Sodom Waterworks RD.

PARKING

PARKING

RT. 305