

EAST

TROY CAMPUS

Built in 1966

18,090 SQ.FT.


Plastic water Line in to Building, Copper solder Line run in side.

We sample for Lead & Copper out of the sinks in Boy R.R and Girl's R.R and Janitor Room.

North

South

State Rt 422

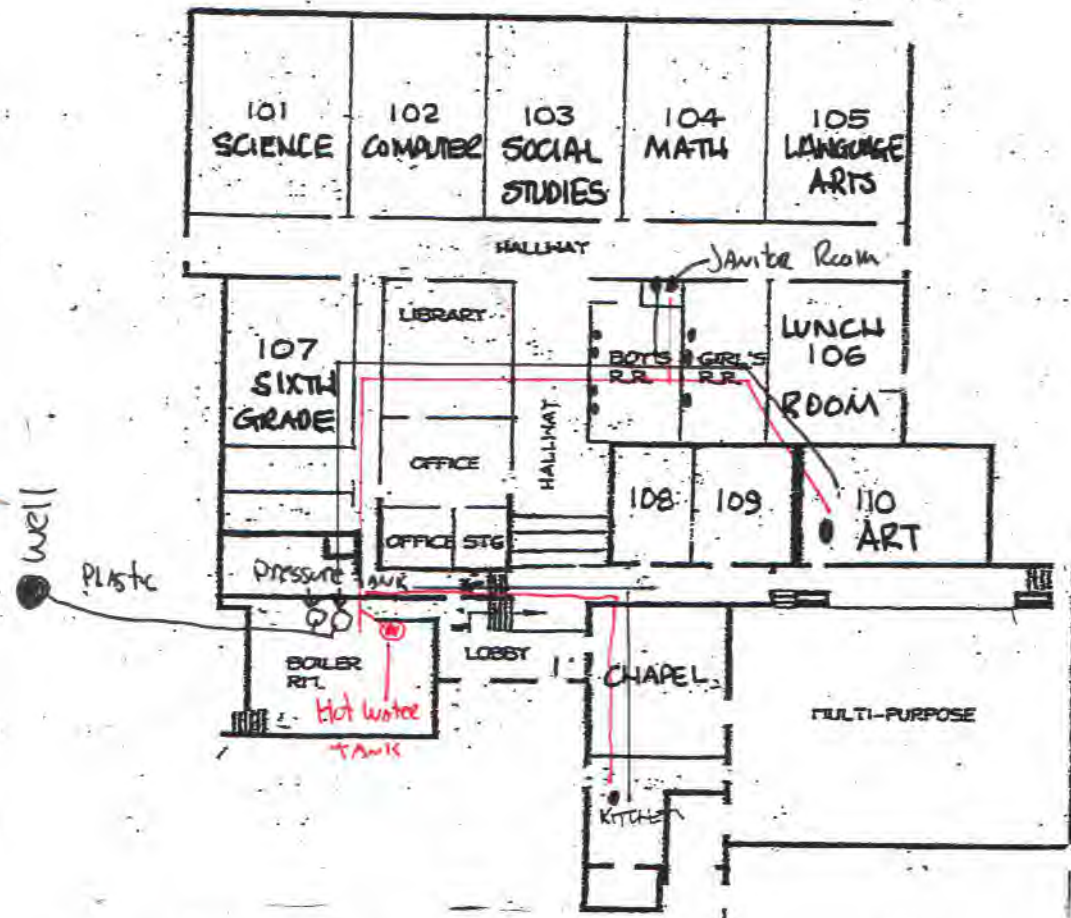

- = Cold water
- (red) = hot water
- = Sinks

AGAPE CHRISTIAN ACADEMY
 14220 Clardium Troy Rd
 440 834 1705

State Rt 700
 West