


WillowWood

15441 Scioto Darby Road
 P.O. Box 130
 Mt. Sterling, Ohio 43143
 740-869-3377
 PWS ID#: OH6537912

PLAN
 SCALE 1/8" = 1'-0"

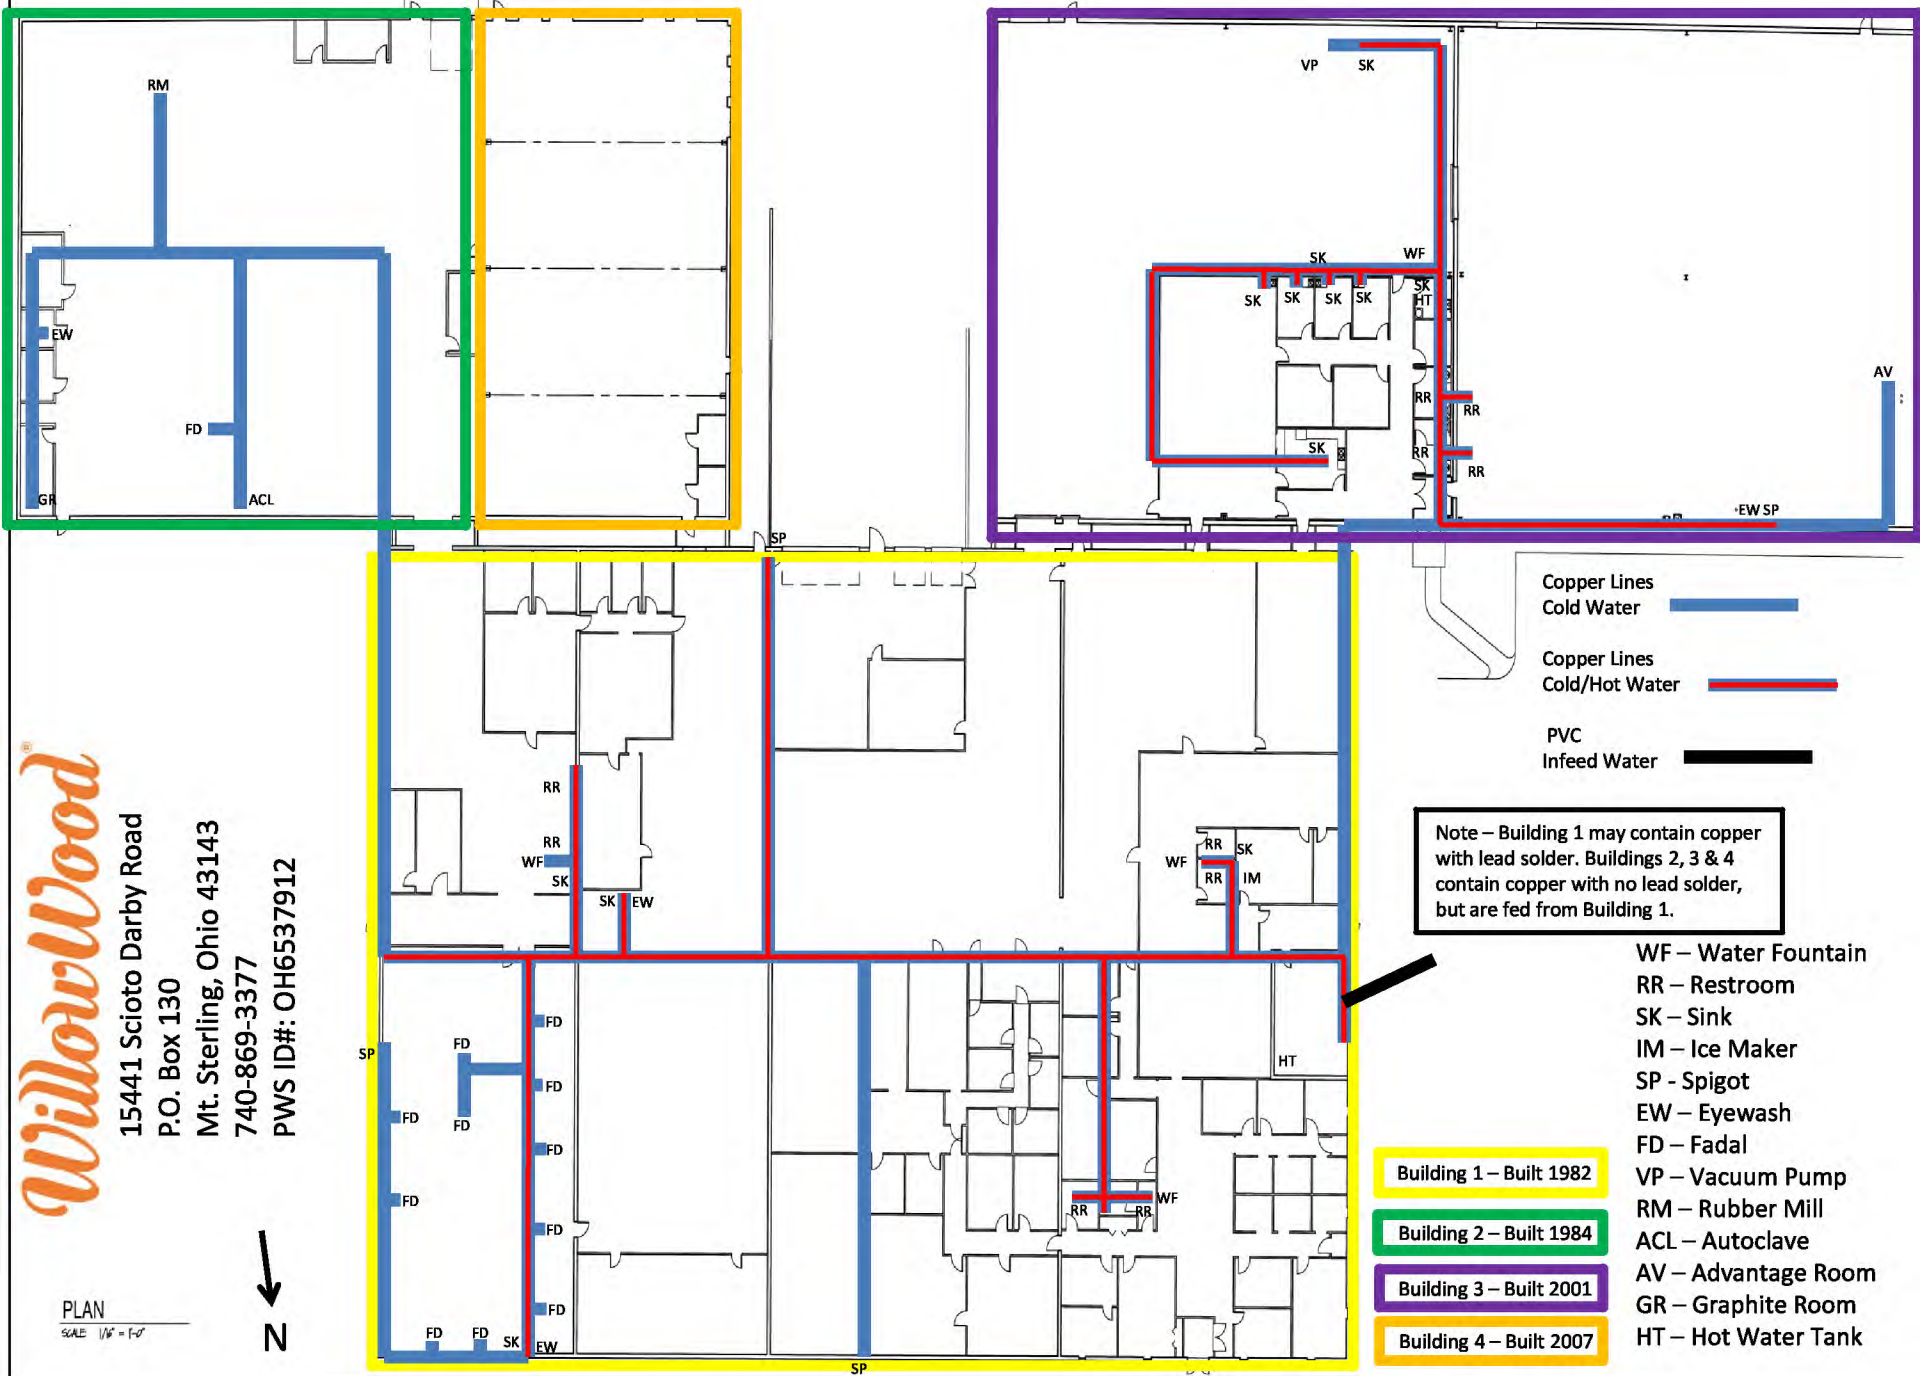

- Copper Lines Cold Water —
- Copper Lines Cold/Hot Water —
- PVC Infeed Water —

Note – Building 1 may contain copper with lead solder. Buildings 2, 3 & 4 contain copper with no lead solder, but are fed from Building 1.

- WF – Water Fountain
- RR – Restroom
- SK – Sink
- IM – Ice Maker
- SP - Spigot
- EW – Eyewash
- FD – Fadal
- VP – Vacuum Pump
- RM – Rubber Mill
- ACL – Autoclave
- AV – Advantage Room
- GR – Graphite Room
- HT – Hot Water Tank

- Building 1 – Built 1982
- Building 2 – Built 1984
- Building 3 – Built 2001
- Building 4 – Built 2007