


VILLAGE OF FREDERICKTOWN
OH4200212

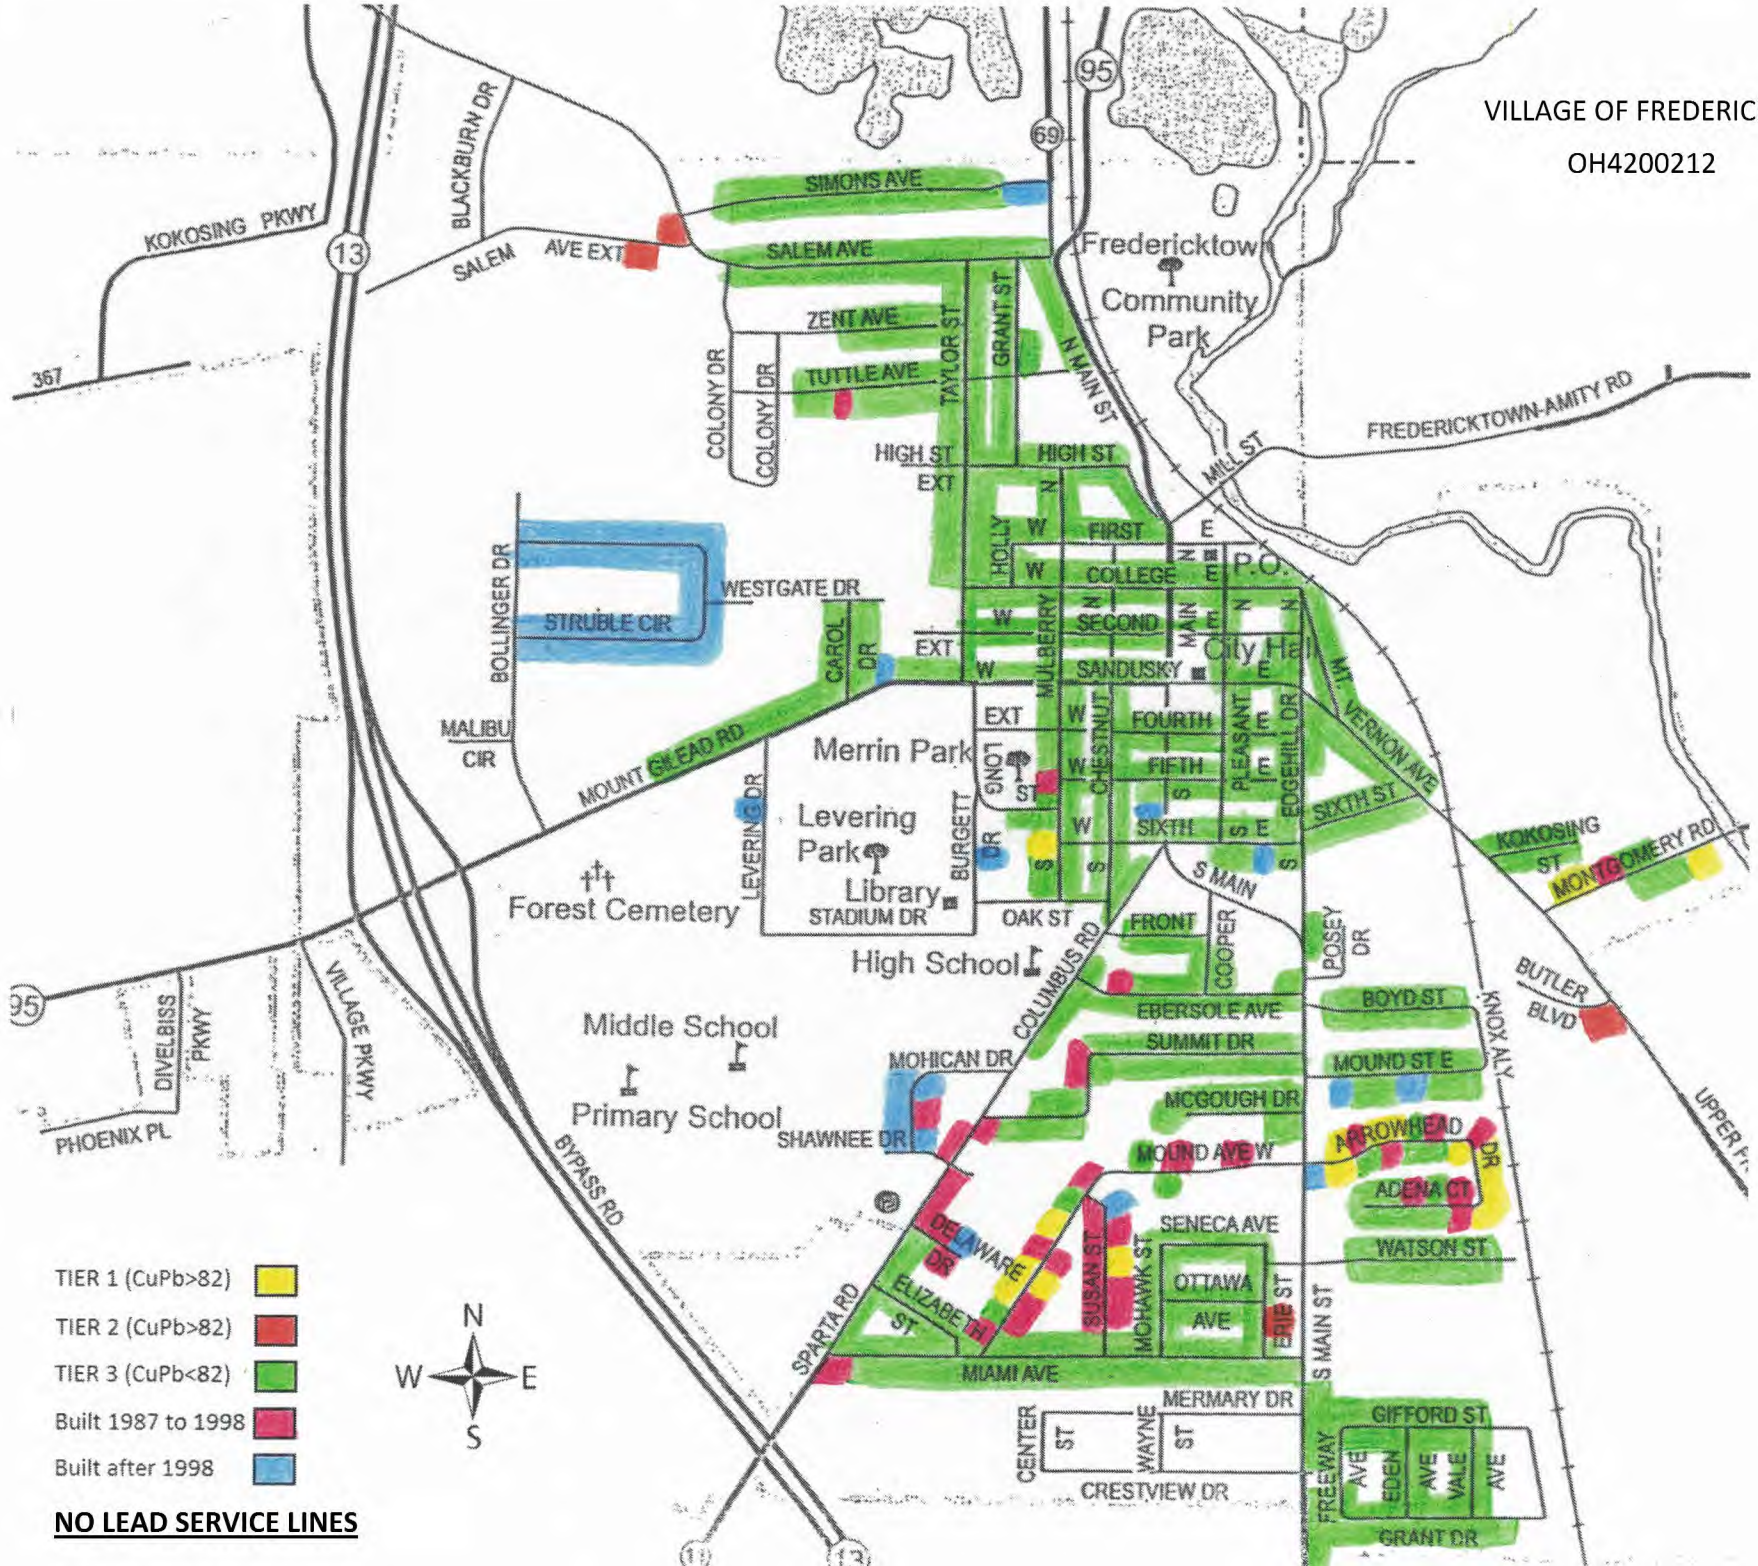

- TIER 1 (CuPb>82)
- TIER 2 (CuPb>82)
- TIER 3 (CuPb<82)
- Built 1987 to 1998
- Built after 1998



NO LEAD SERVICE LINES

VILLAGE OF FREDERICKTOWN OH4200212

There are no lead service lines in the Village of Fredericktown. Distribution maintenance records, installation dates, and permit records were all reviewed. If the information was not available, we checked each residence that we had no information for to determine that there are no lead service lines in the Village. The service lines in the Village are made up of 67% copper, 32% plastic, and 1% galvanized.

The Village of Fredericktown is made up of 800 Single Family Residences (SFRs), 63 Multiple Family Residence (MFRs), and 78 Buildings.

18 SFRs meet the requirements for Tier 1 making up 2.2% of all SFRs in the Village. Not all of the Tier 1 sites are available for testing because of water softeners or not willing to participate in sampling. We currently test 6 Tier 1 sites of the required 10 sites for sampling. These sites are found in the southern part of the village.

4 buildings meet the requirements for Tier 2 making up 2.8% of all buildings and 0.4% of all structures in the Village. There is 1 MFR and 3 commercial buildings. None of these sites are available for testing as they have not been willing to participate in the testing.

669 SFRs meet the requirements for Tier 3 making up 83.6% of all SFRs in the Village. We currently test 4 Tier 3 sites to meet the required 10 sites for sampling. There are also 52 MFRs and 61 buildings that fall into the (CuPb<83) category.

A majority of the Village's services are to structures that were built prior to 1987 (85.4%) but there are some that are 1987+ (14.6%) that have been broken down into 2 categories: Built from 1987 to 1998 (5.5%) and built after 1998 (9.1%). Structures built from 1987 to 1998 include 44 SFRs, 2 MFR, and 5 Buildings. Structures built 1998 and after include 69 SFRs, 8 MFR, and 9 Buildings.


**VERIFICATION FORM FOR COMMUNITY PUBLIC WATER SYSTEMS
CLAIMING NO LEAD SERVICE LINES**

The owner or operator of all community public water systems must identify and map areas of their distribution system that are known or are likely to contain lead service lines. Systems must submit a copy of the applicable map to the Ohio Department of Health and the Ohio Department of Job and Family Services. Systems must also submit a report to the director containing at least both of the following: (1) The applicable map with narrative, and (2) A list of sampling locations used to collect samples as required by Ohio Revised Code (ORC) Section 6109.121 and any rules adopted thereunder, including contact information for the owner and occupant of each sampling site.

Should a water system determine no lead service lines exist in their distribution system, they must provide information stating they reviewed, at the minimum, historical permit records and local ordinances, distribution maintenance records and information pertaining to installation dates or materials for all services lines. This information must be verified below.

I HEREBY CERTIFY THAT THE FOLLOWING METHOD(S) WERE USED TO DETERMINE NO LEAD SERVICE LINES EXIST IN THIS WATER SYSTEM'S DISTRIBUTION SYSTEM, AS REQUIRED BY ORC 6109.121(F):

LEAD SERVICE LINE VERIFICATION
<p>This PWS states they have no lead service lines and has reviewed the following information (select one or more of the following):</p> <ul style="list-style-type: none"> <input checked="" type="checkbox"/> Historical permit records and/or local ordinances <input checked="" type="checkbox"/> Distribution maintenance records (i.e. meter replacement, waterline break repairs) <input checked="" type="checkbox"/> Information pertaining to installation dates for all service lines (i.e. after 1986 when lead services lines were banned) <input checked="" type="checkbox"/> Service line material of all service lines is known (i.e. all service lines are known to be PVC)

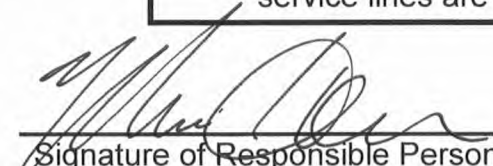
 _____ 3-2-17
 Signature of Responsible Person Date
MICHAEL HANNAN Utilities Superintendent
 Printed Name and Title of Responsible Person

PWS NAME: Fredericktown Village
PWS ID: OH4200212
COUNTY: Knox

<p><u>For Ohio EPA use only:</u></p> <p>Date Verification Rec'd: _____</p>
