



KEY

- Parkwoods Trail (.5 mile paved)
- Daweswood Trail (.75 mile)
- Bur Oak Trail (1 mile)
- Lake Trail (2.75 miles)
- Lake Trail Connector (.5 mile paved)
- Entrance
- One Way Road
- Proposed Trail

Trails traverse a variety of surfaces and terrain.



The Dawes Arboretum
Trees ~ History ~ Nature
www.dawesarb.org
800.443.2937
dawesarb.arboretumexplorer.org



If I have marked a water line in certain location or a certain type it is because I can see it or know its location from repairs done in the past.

I do not know of any lead pipe that we have.

Most of the old steel water line was replaced in the 80's and 90's

I do not know where solder with lead in it may have been used.

Steve Franks

P.S. - The Visitor Center and Administration Building may appear to be two different buildings but they are connected and share the same water lines.


WELL #1
PLWS ID OH 4539912

2-24-17



The
Dawes
Arboretum

7770 Jacksontown Rd. SE, Newark, OH 43056-9380
Phone 740-323-2355 or 1-800-44-DAWES

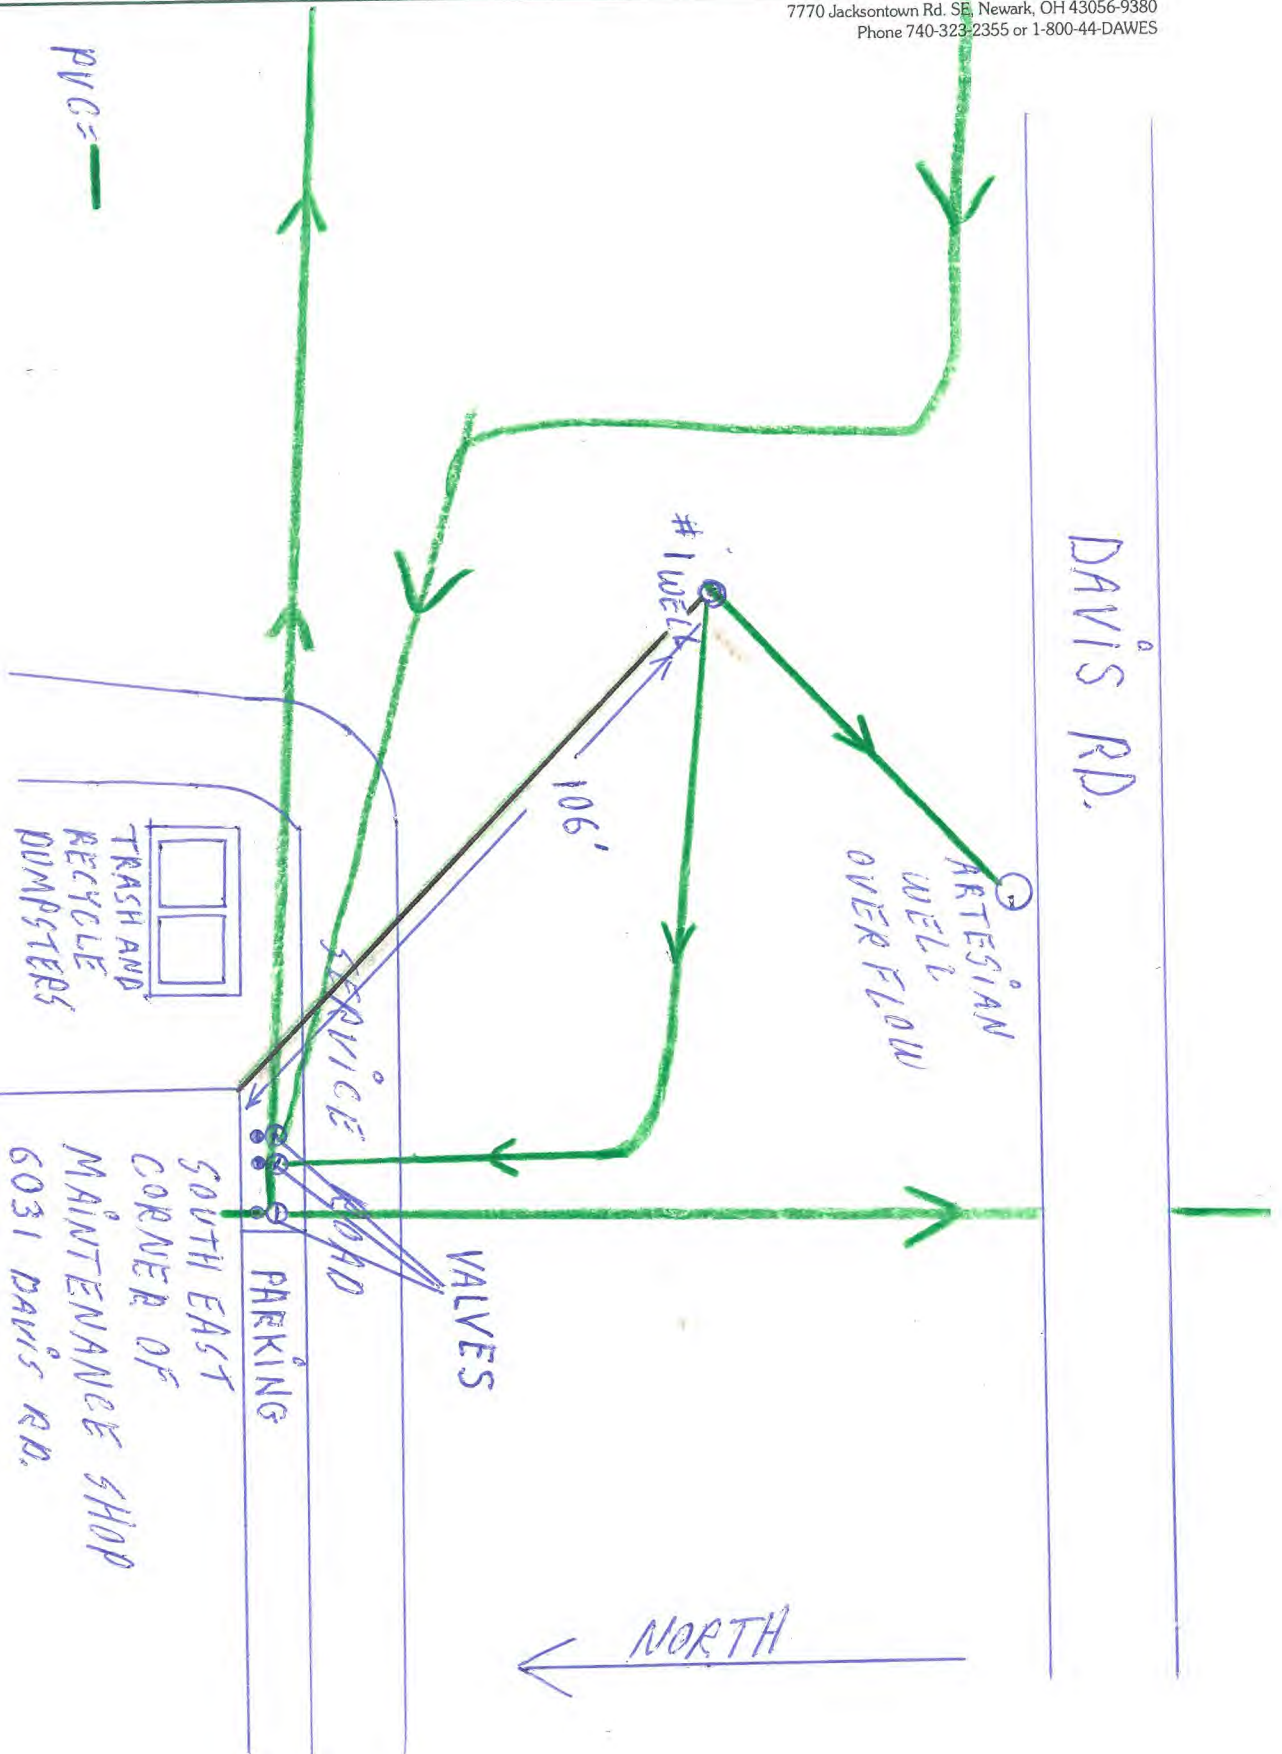

WELL # 2

2-24-17



The
Dawes
Arboretum

PWS ID OH 4539912

7770 Jacksontown Rd. SE, Newark, OH 43056-9380
Phone 740-323-2355 or 1-800-44-DAWES

GREEN HOUSES

PARKING

EDUCATION
CENTER

SAND
FILTER
RETENTION
TANKS
PRESSURE
TANK

SOUTHWEST
CORNER OF
BUILDING

PVC = —
GALVANIZED = —

NORTH
↑

WELL #2

120'

ARCHIVE BUILDING

2-24-17




The
Dawes
Arboretum

PWS ID OH 4539912

YEAR BUILT 2012

7770 Jacksontown Rd. SE, Newark, OH 43056-9380
Phone 740-323-2355 or 1-800-44-DAWES

NO INFORMATION

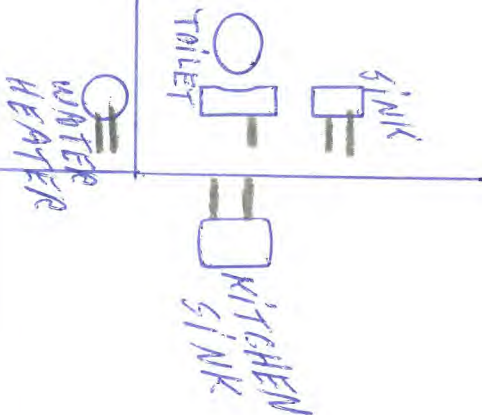

NORTH

ADMINISTRATION BUILDING - 1ST FLOOR

2-24-19




The
Dawes
Arboretum

PWSID OH 4539912

YEAR BUILT 1965

7770 Jacksontown Rd. SE, Newark, OH 43056-9380
Phone 740-323-2355 or 1-800-44-DAWES

- NOT SURE WHAT TYPE
OF PIPE SUPPLIES THESE
FIXTURES -

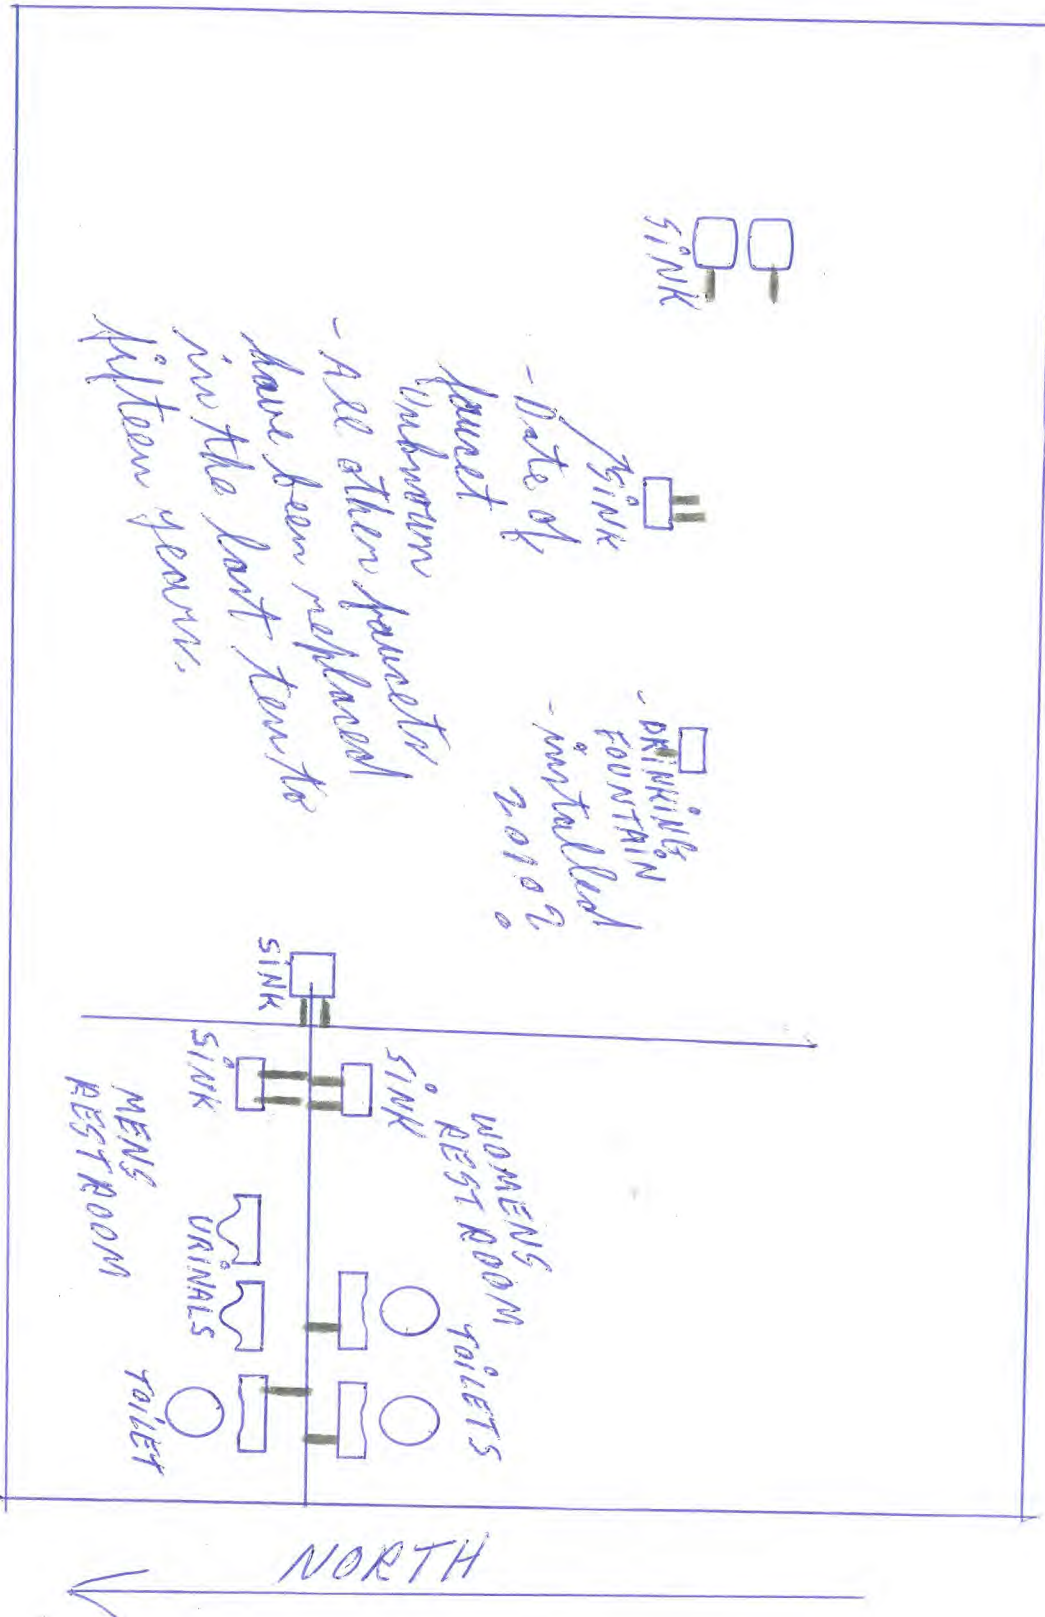

ADMINISTRATION BUILDING - BASEMENT




The
Dawes
Arboretum

PWS ID OH 4539912

Year Built 1965

7770 Jacksontown Rd. SE, Newark, OH 43056-9380
Phone 740-323-2355 or 1-800-44-DAWES

COPPER = 
PLASTIC = 
NO INFORMATION = 

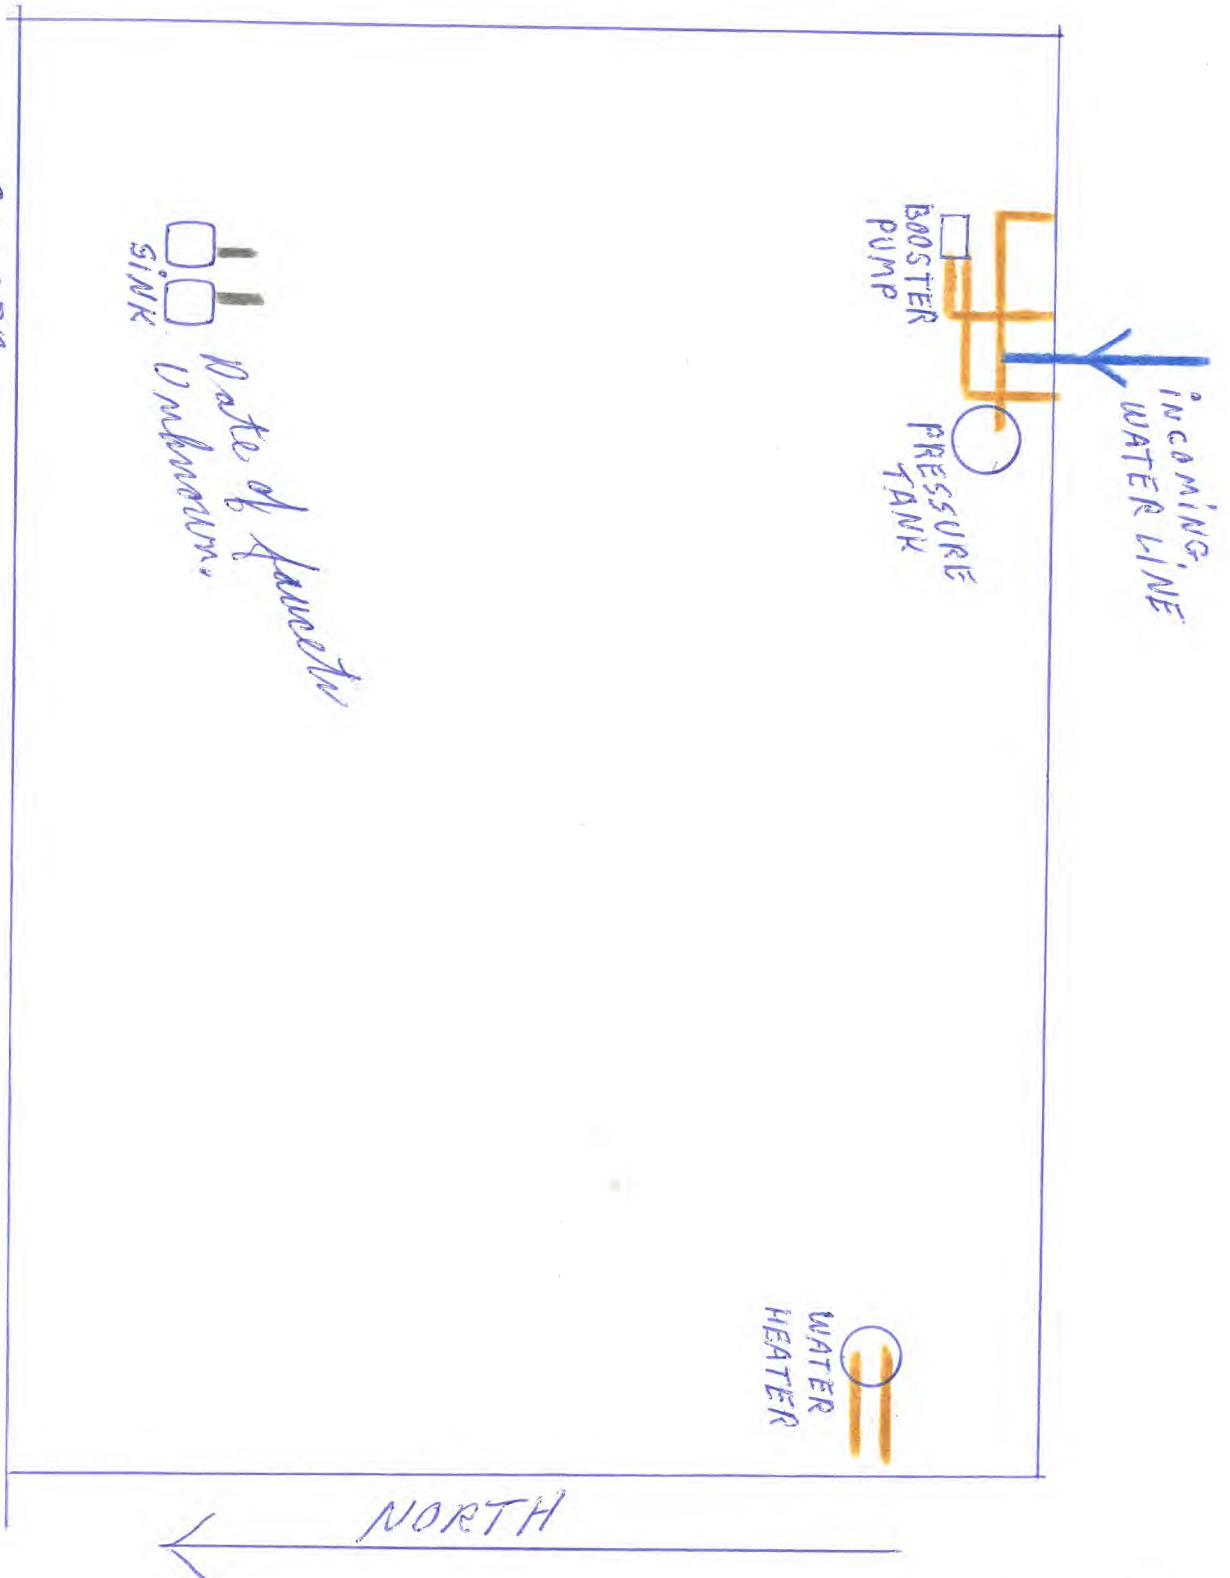

2-24-17

VISITORS CENTER - 1ST FLOOR

2-24-19



The
Dawes
Arboretum

PWS ID 4539912

YEAR BUILT 1979

7770 Jacksontown Rd. SE, Newark, OH 43056-9380
Phone 740-323-2355 or 1-800-44-DAWES

NO INFORMATION =

SINK
KITCHEN SINK

DRINKING
FOUNTAIN

DATE OF DRINKING FOUNTAIN
AND SINKS UNKNOWN.

← NORTH

VISITORS CENTER-BASEMENT

2-24-17



The
Dawes
Arboretum


PWS ID OH 4539912

Year Built 1979

7770 Jacksontown Rd. SE, Newark, OH 43056-9380
Phone 740-323-2355 or 1-800-44-DAWES

NO INFORMATION
COPPER

Date of faucet and
drinking fountain unknown.

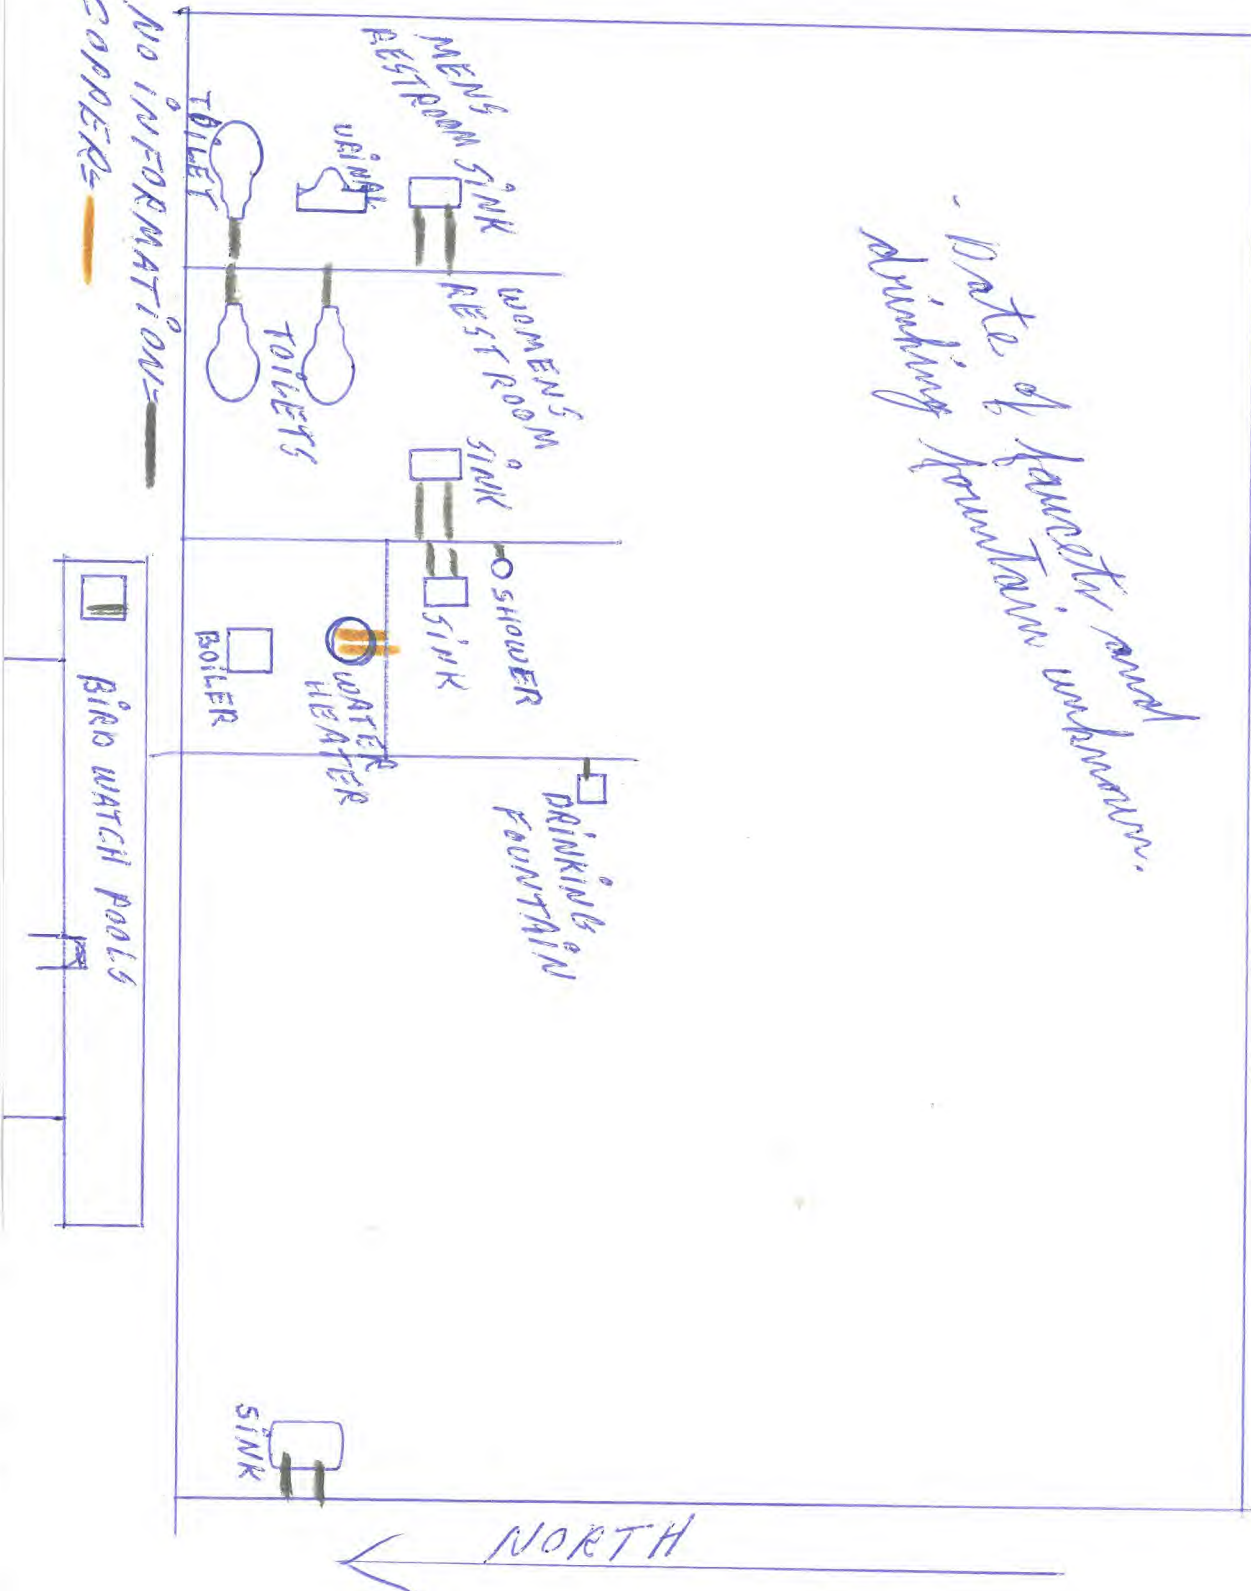


DAWESWOOD HOUSE - 2ND FLOOR

2-24-17



The PWS ID OH4539912
Dawes Year Built 1866-67
Arboretum Bathrooms added in 1929

7770 Jacksontown Rd. SE, Newark, OH 43056-9380
Phone 740-323-2355 or 1-800-44-DAWES

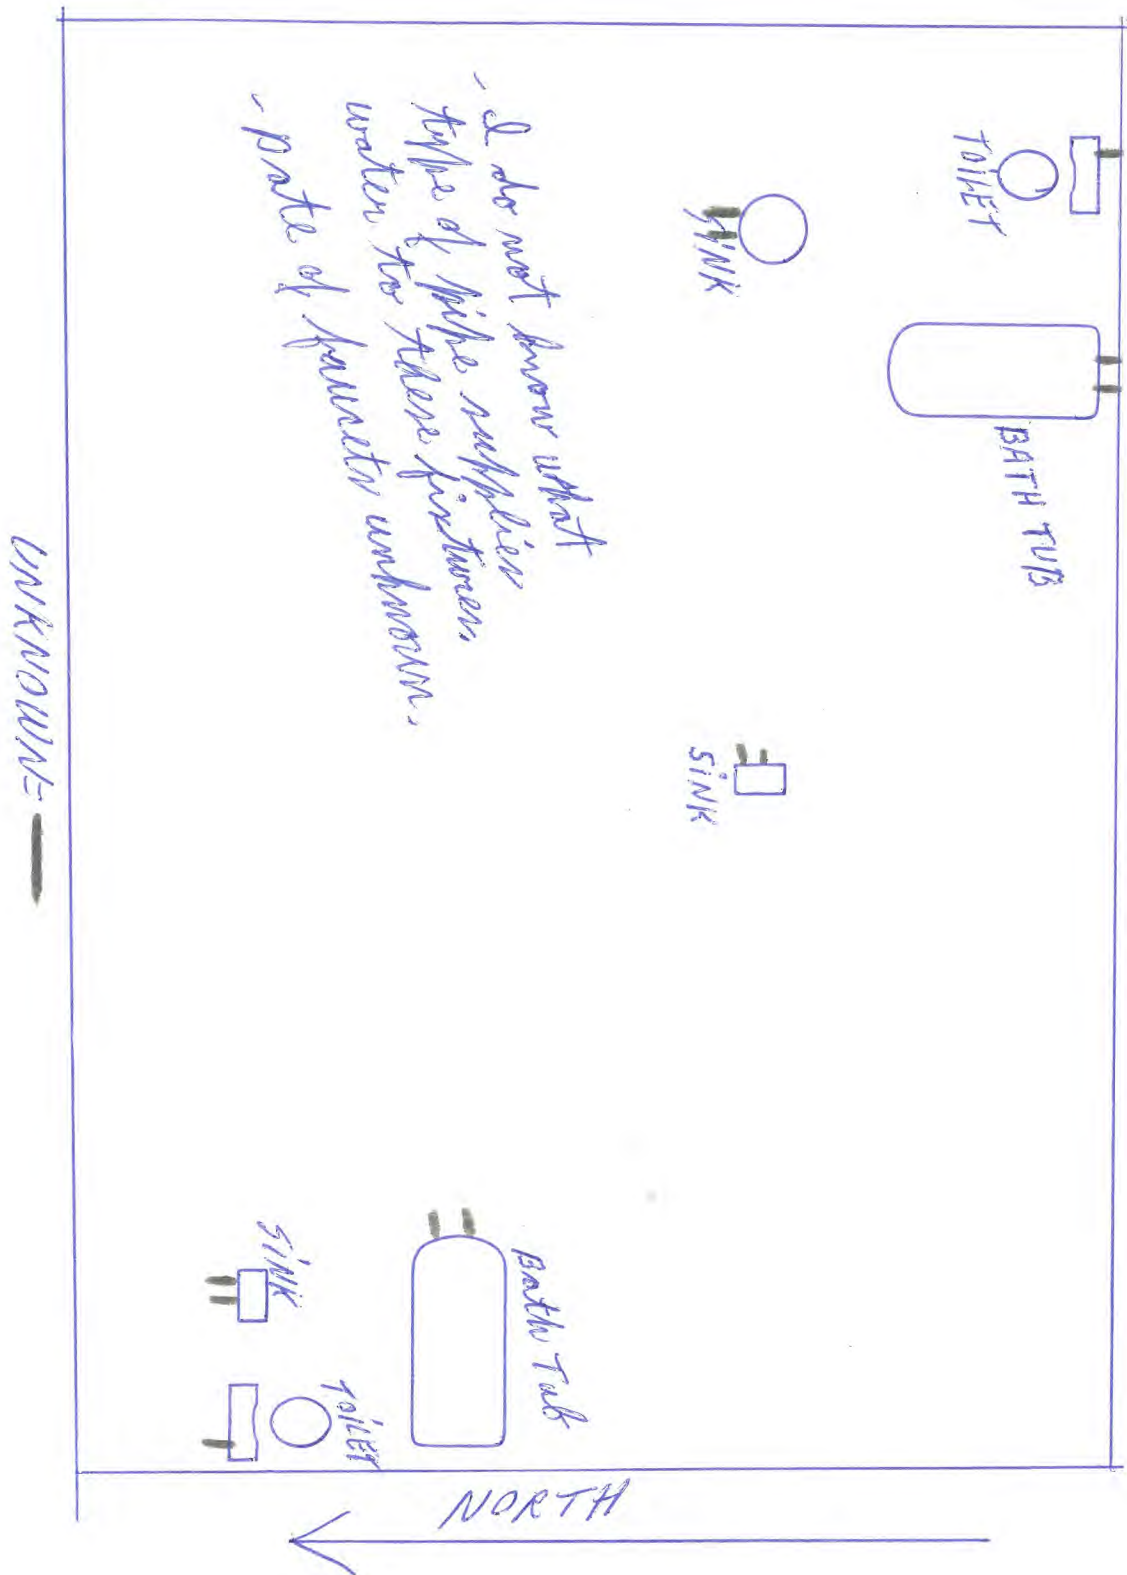

DAWESWOOD HOUSE - 1ST FLOOR

2-24-17




The
Dawes
Arboretum

PWS ID OH 4539912

Year Built 1866-67

Bathroom added in 1929

7770 Jacksontown Rd. SE, Newark, OH 43056-9380
Phone 740-323-2355 or 1-800-44-DAWES

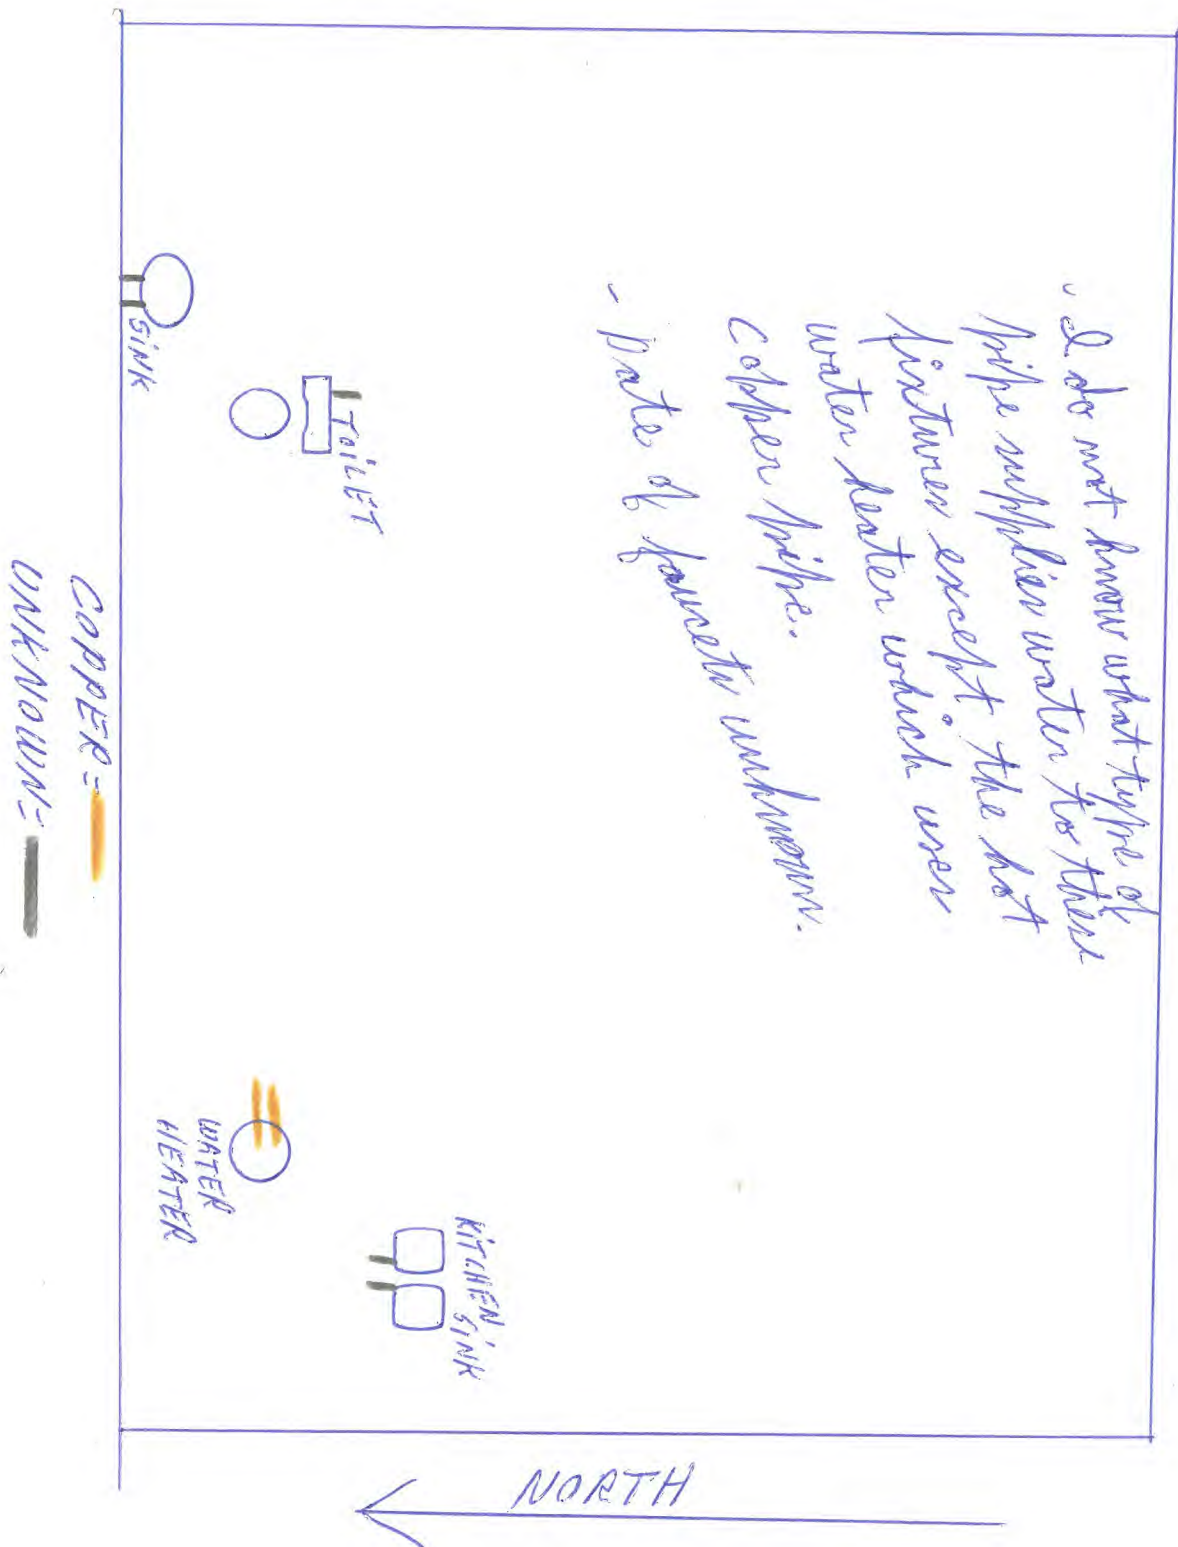

DAWES WOOD HOUSE - BASEMENT

2-24-17



The
Dawes
Arboretum


PWS ID OH 4539912

Year Built 1866-67

Bathrooms added in 1929

7770 Jacksontown Rd. SE, Newark, OH 43056-9380
Phone 740-323-2355 or 1-800-44-DAWES

COPPER = 
PVC = 
GALVANIZED = 

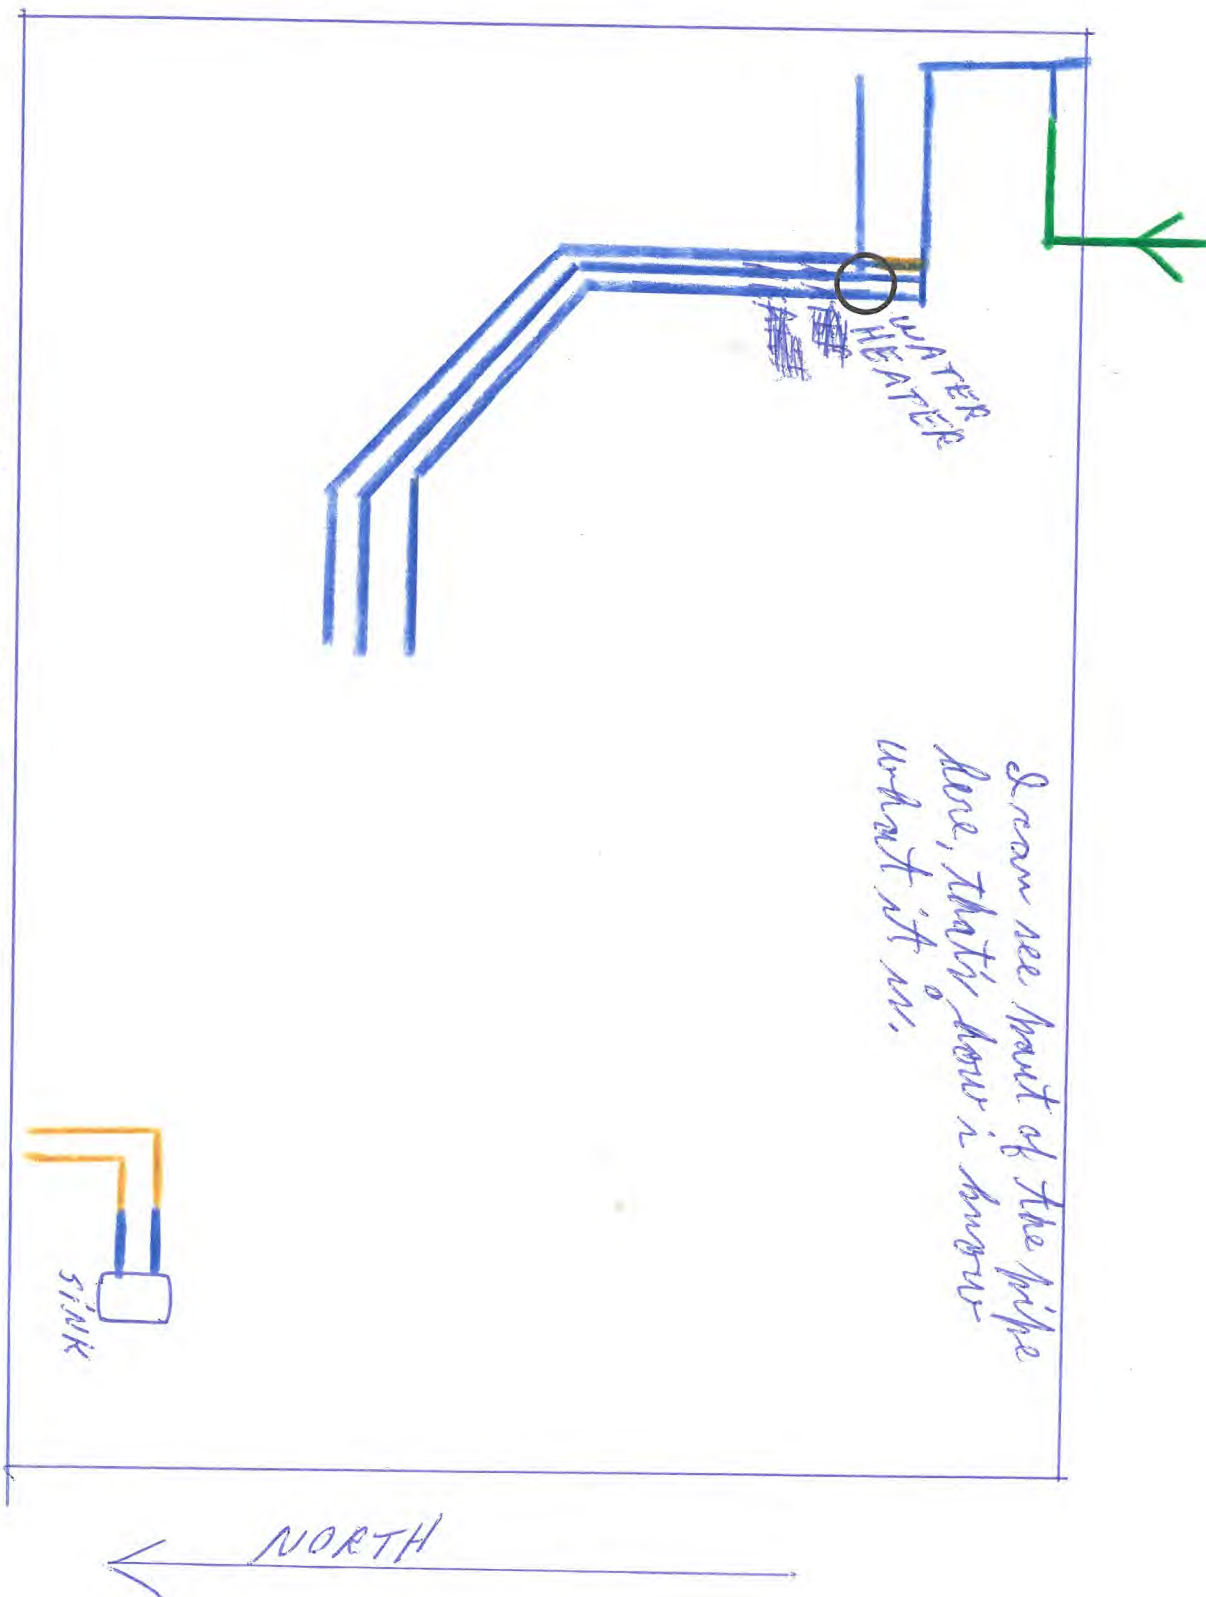

I can see part of the pipe
here, that's how I know
what it is.

SCHOOL HOUSE 1ST FLOOR

2-24-17



The
Dawes
Arboretum

PWS ID OH4539912


WE CALL THIS THE SCHOOL HOUSE
BECAUSE AT ONE TIME THIS WAS A
ONE ROOM SCHOOL HOUSE.

7770 Jacksontown Rd. SE, Newark, OH 43056-9380
Phone 740-323-2355 or 1-800-44-DAWES

NORTH
←

Built in the 1870's
Remodeled into residence
in 1925, has been remodeled
several times since then.
The last one was 2009?
Faucets for sink and
tub were replaced in 2009?

COPPER = —
GALVANIZED = —

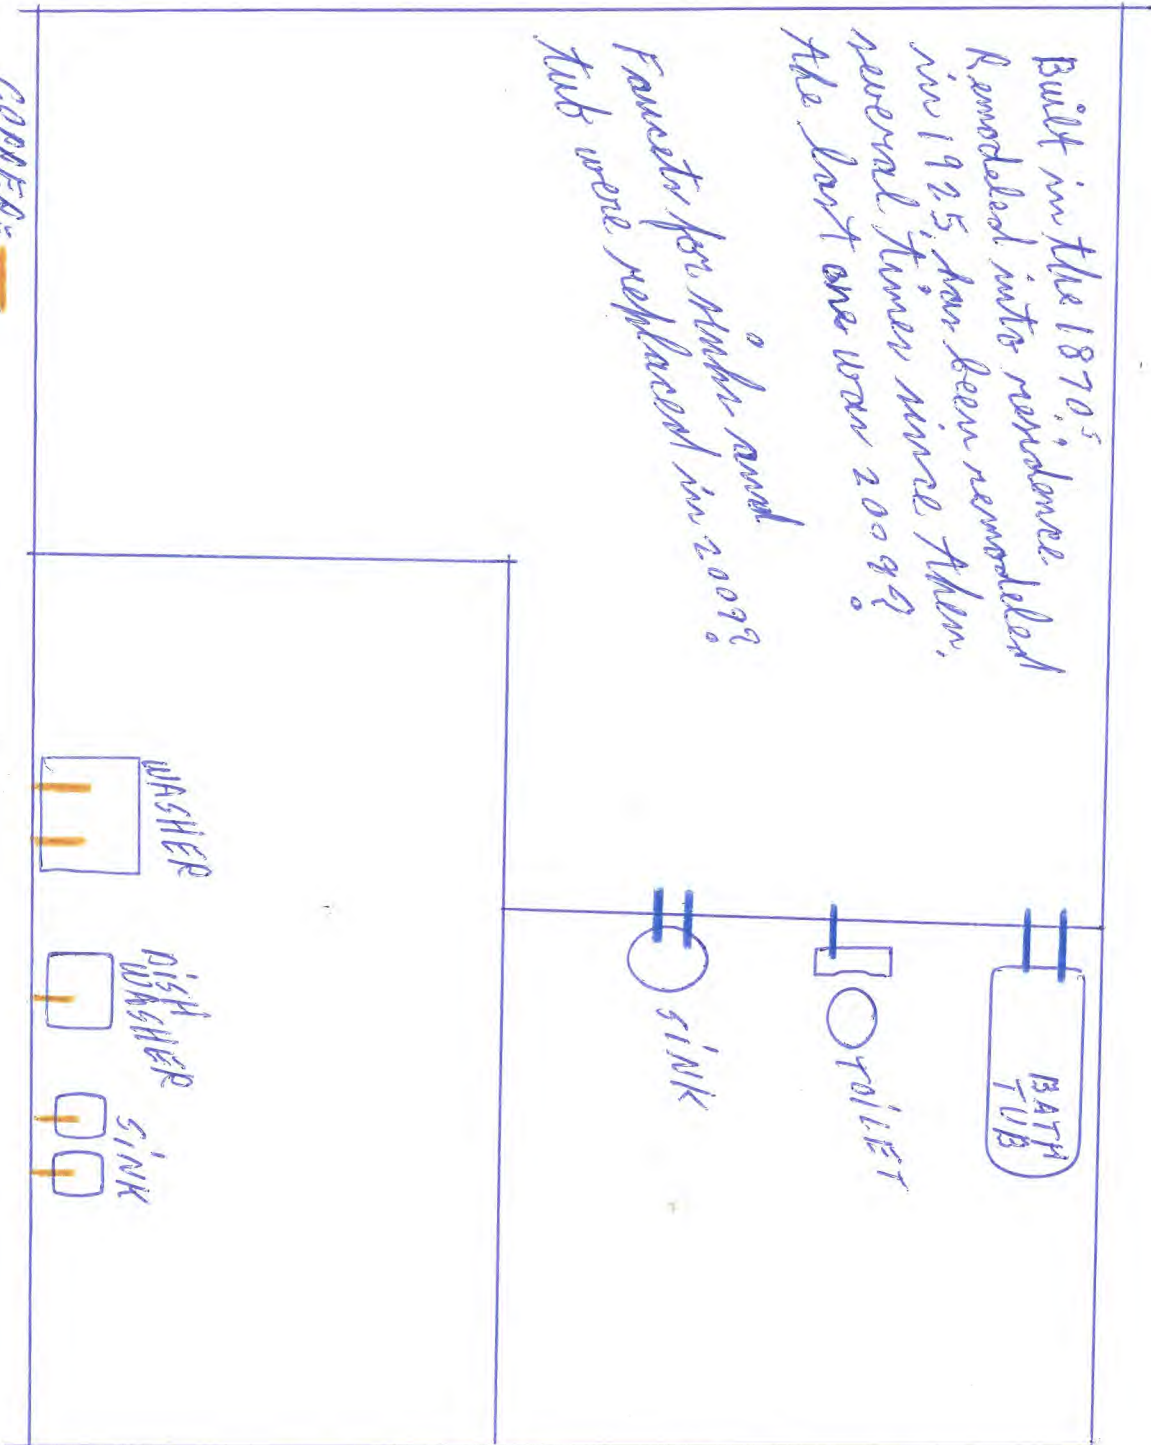

Built in 1870's
Remodeled into
residence in 1925



The
Dawes
Arboretum

SCHOOL HOUSE BASEMENT

2-24-17

PWS ID OH4539912


WE CALL THIS THE SCHOOL HOUSE BECAUSE
AT ONE TIME THIS WAS A ONE ROOM
SCHOOL HOUSE

7770 Jacksontown Rd. SE, Newark, OH 43056-9380
Phone 740-323-2355 or 1-800-44-DAWES

← NORTH

It has been remodeled several
times since 1925, the last one
was 2009.

PVC —
COPPER —
GALVANIZED —

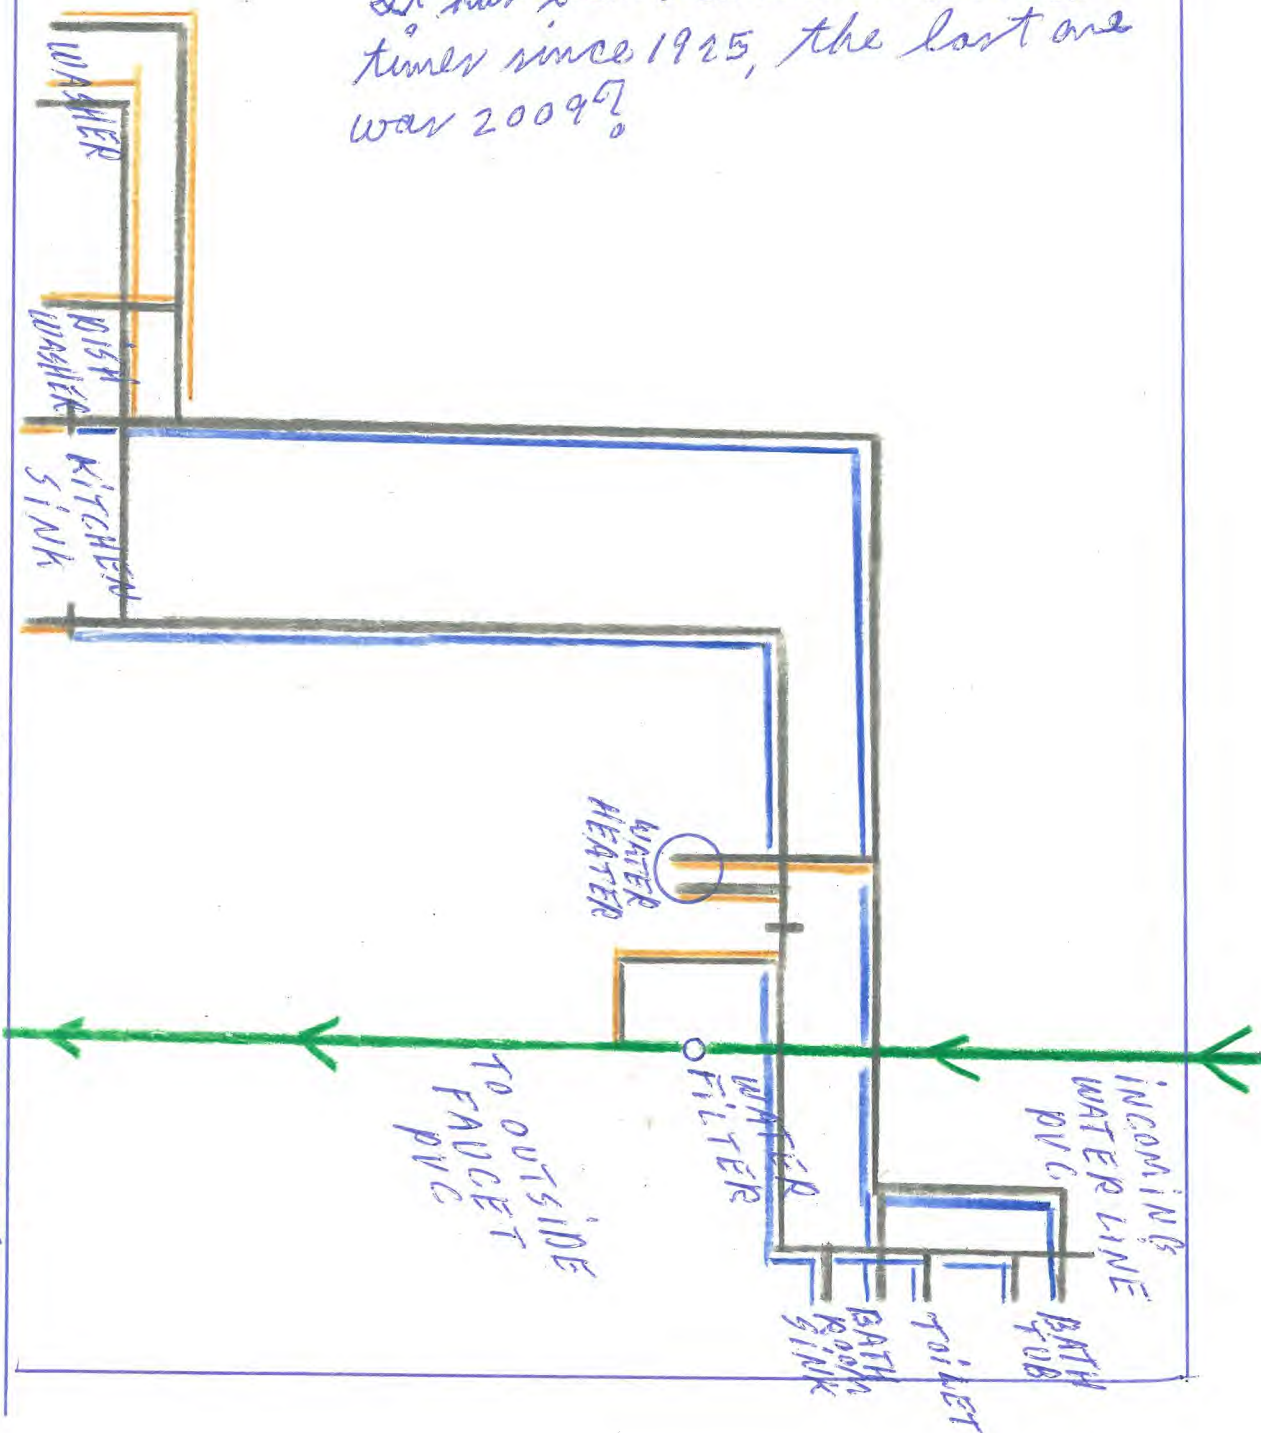

EDUCATION CENTER - NORTH-SOUTH PART


PWS ID OH 4539912



The Dawes Arboretum

This part of the building was refurbished in 1975 and again in 2012?

7770 Jacksontown Rd. SE, Newark, OH 43056-9380
Phone 740-323-2355 or 1-800-44-DAWES

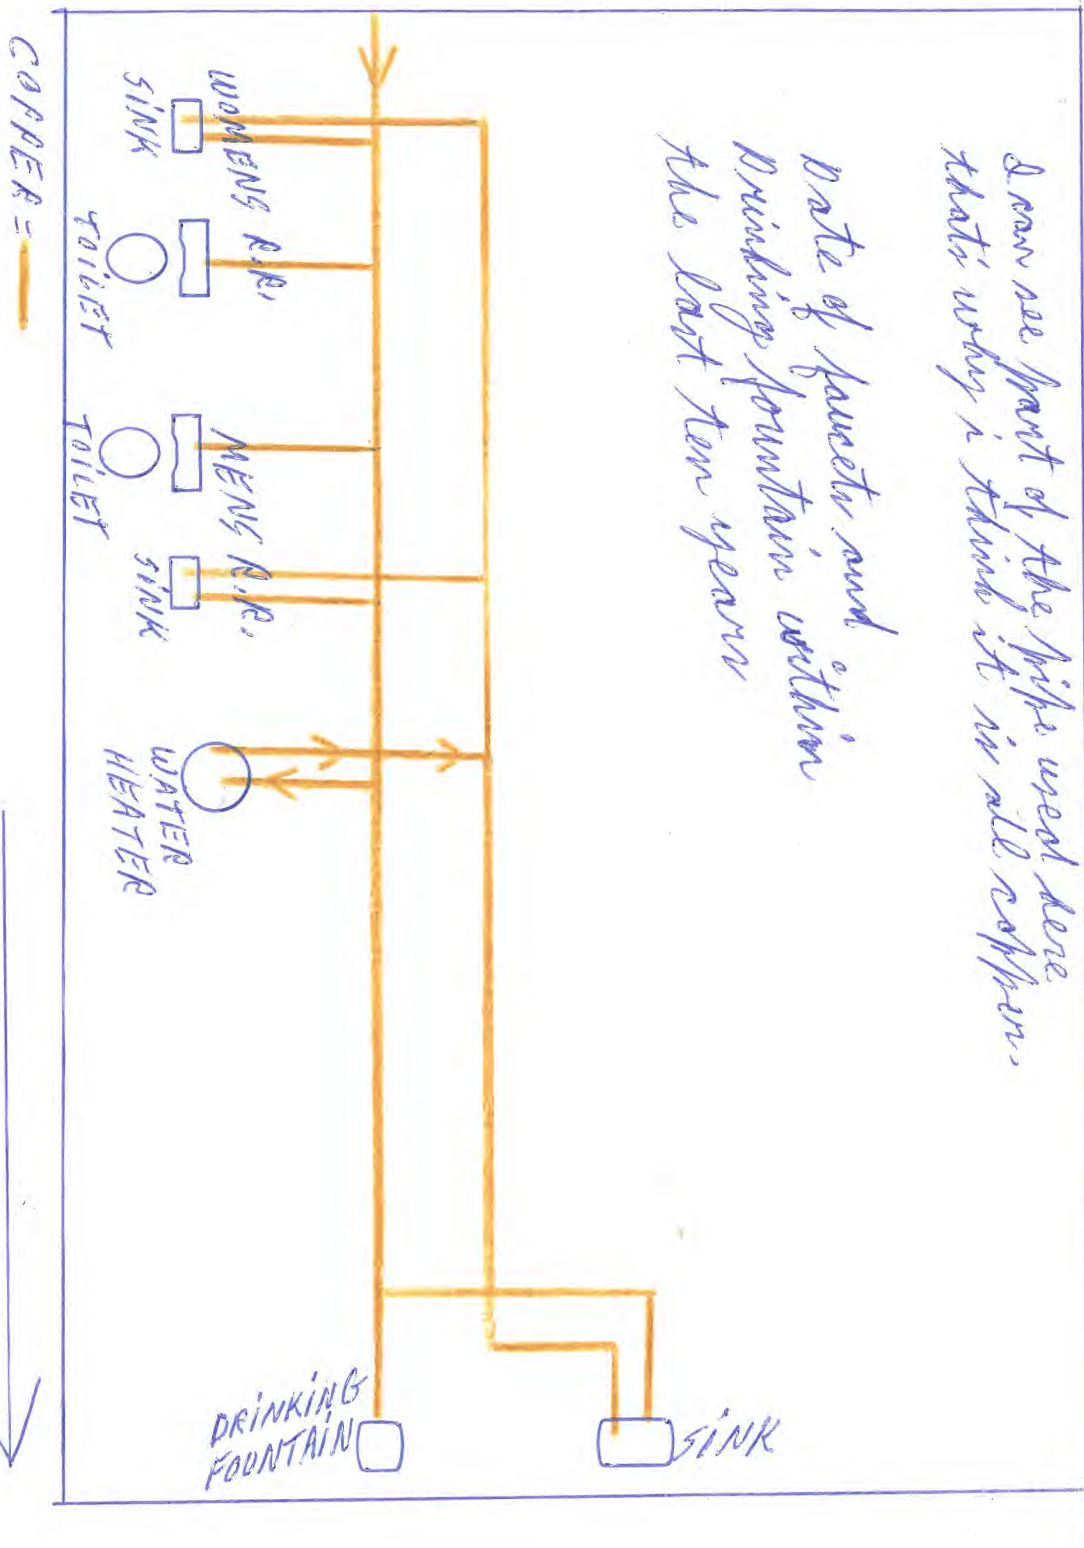


I can see part of the pipe used here that's why I think it is all copper. Date of faucets and drinking fountain within the last ten years

2-24-17



The
 Dawes
 Arboretum

7770 Jacksontown Rd. SE, Newark, OH 43056-9380
 Phone 740-323-2355 or 1-800-44-DAWES

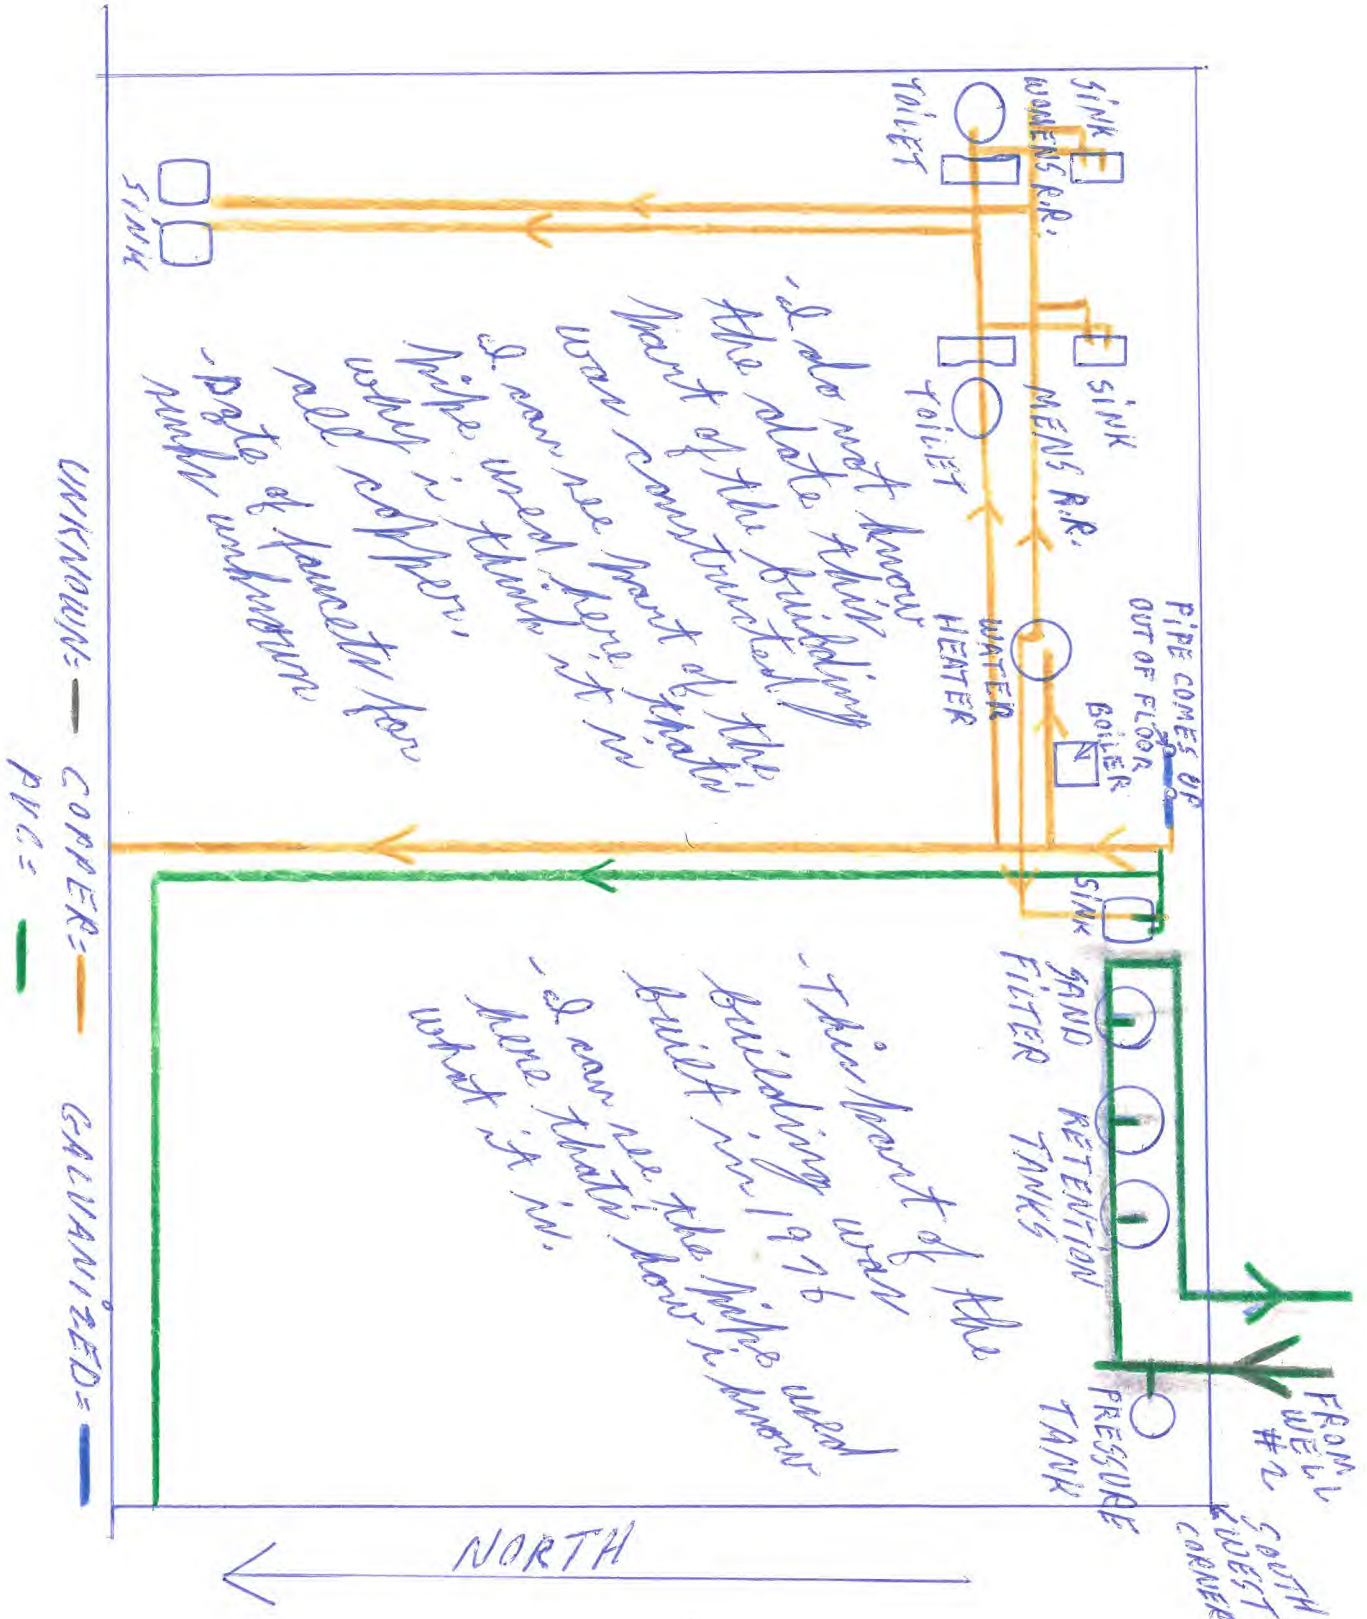

EDUCATION CENTER - EAST-WEST PART B

2-24-19

PWSID OH 4539912



The Dawes Arboretum

Greenhouses built in 1968
mist system added in 2012?

I can see the pipe used here that's how
I know what it is.

7770 Jacksontown Rd. SE, Newark, OH 43056-9380
Phone 740-323-2355 or 1-800-44-DAWES

