

RE: Hemmelgarn and Sons
Report
Drinking Water Program
Mercer County
PWS ID: OH5437812






Hennelgarn & Sons, Inc.

Philothea Road



Legend

- A- Office, Restrooms, Breakroom
- B- West Grading Room
- C- West Cooler
- D- West Dry Storage
- E- West Dock
- F- West Electric Room
- G- West Entrance
- H- Water, Main Room
- I- Air Room
- J- West Boiler Room
- K- East Grading Room
- L- East Boiler Room
- M- South Cooler
- N- East Cooler
- O- East Dock
- P- #4 Dock
- Q- Material Wash Room
- R- Warehouse #1
- S- Warehouse #2
- T- Garage
- U- Old Carton Barn Storage
- V- North Electric Room
- W- Fuel Station

-  - well
-  - underground plastic line
-  - drinking fountain
-  - plastic/pvc line
-  - copper line

RECEIVED


MAR 02 2017







DDAGW - NWDO

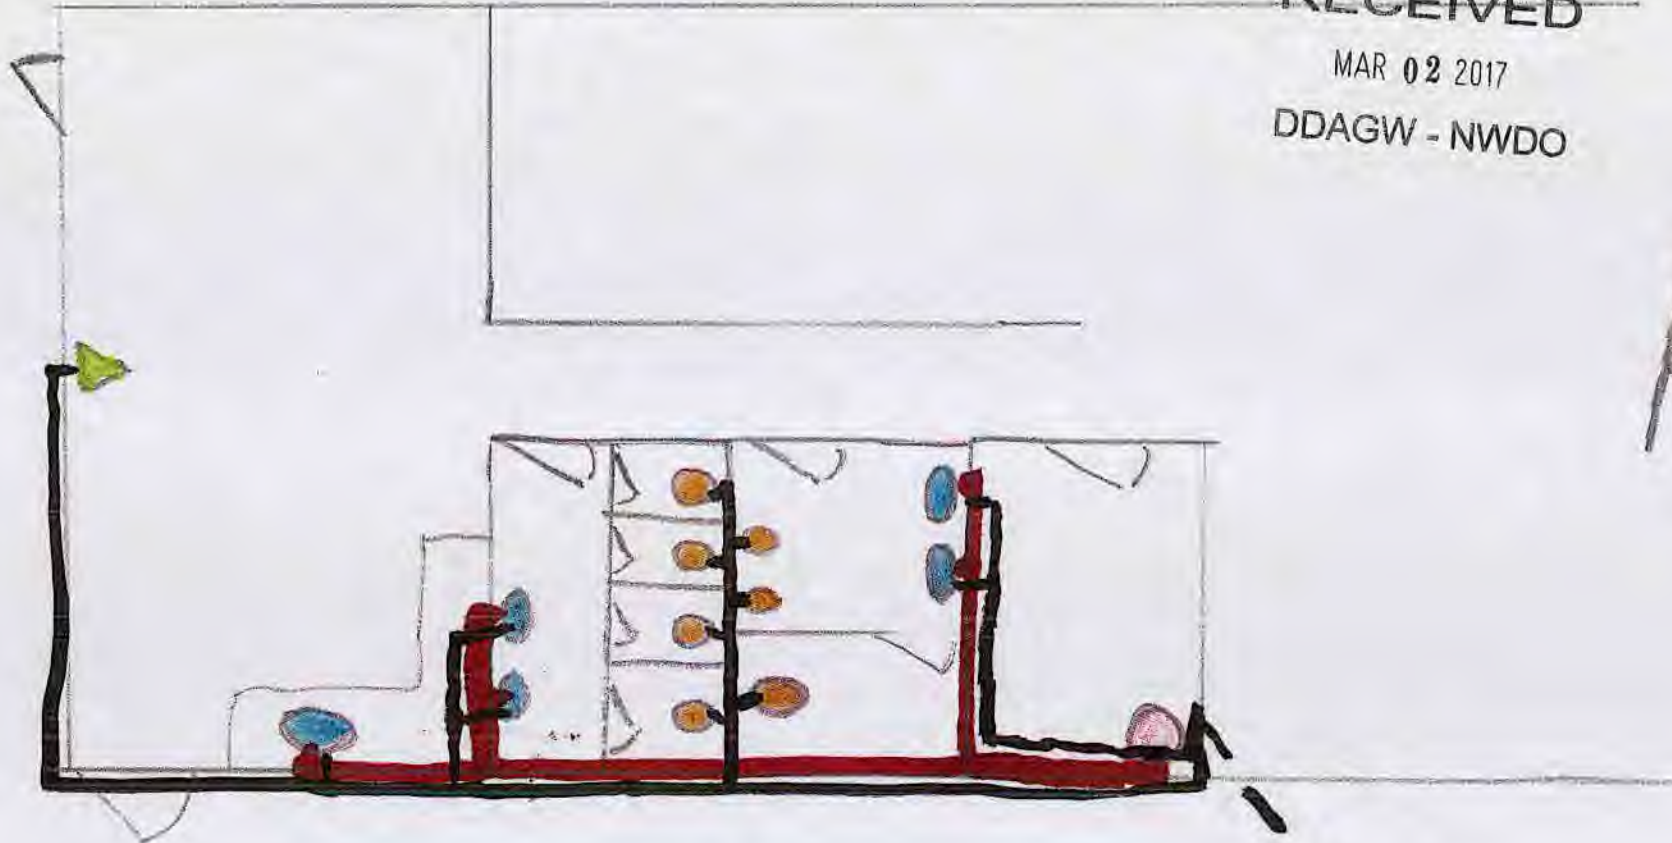

Hemmelgarn & Sons, Inc.

RECEIVED
MAR 02 2017
DDAGW - NWDO




-  sink
-  toilets / urnial
-  hot water heater
-  drinking Fountain
-  hot water
-  cold water

--- plastic service line
from water room



A

Hemmelgarn & Sons, Inc.

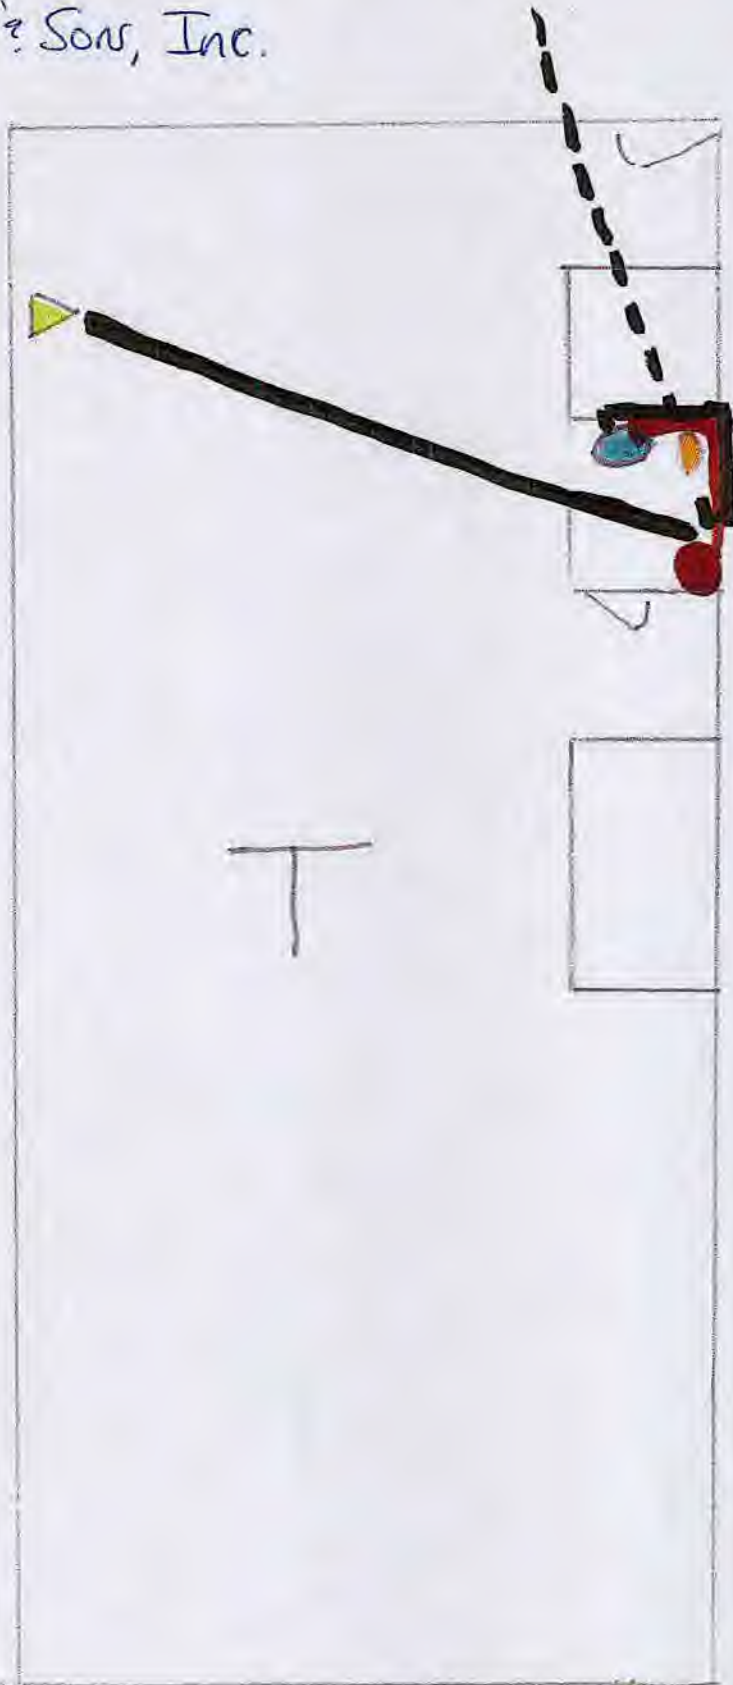

RECEIVED

MAR 02 2017

DDAGW - NWDO



▲ - drinking fountain

● - toilet

● - sink

--- underground service line

— copper line cold water

— copper line - hot water

● - water heater