



BUCKEYE FORD / MADISON COUNTY  
PWS 4939812

110 US RT 42 LONDON, OH 43140 (4 PAGES INCLUDING PHOTO)

3 BLDGS

● = WATER LINES / FIXTURES

MAIN BLDG - 1979 - BLDG A

BLDG # 2 - 2010

BLDG # 3 - 1990

Well PUMP / CASING - 2010

SERVICE LINE - POLY - 1979

“Buildings in Ohio built prior to 1998 or that use plumbing material or solder manufactured before 1998 may have materials with greater than 8% lead and are at a higher risk of contributing lead to the drinking water than materials manufactured after 1998. In addition, buildings built and plumbing materials manufactured after 2014 were required to have less than 0.25% lead by weight and have the lowest risk for contributing lead to the drinking water. It should be noted however that, although prohibited, some use of leaded solder or leaded components may have occurred after the prohibitions became effective.”

MAIN FEED LINE TO BUILDING A 1979

FEED LINE TO B-BUILDING


BUCKEYE FORD  
4939812

COPPER 1979





MAIN BUILDING

A

- 100 - I - WATER HEATER
- 106 - 2 - PRESSURE TANK
- 100 - 3 - WATER SOFTENER

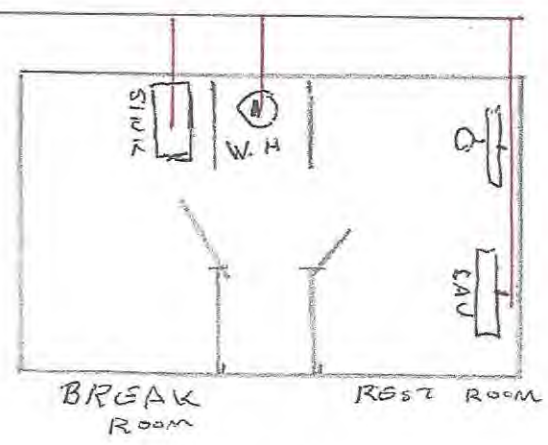


FEED LINE TO BUILDING C

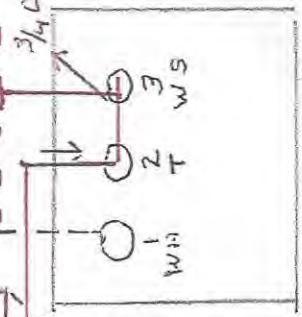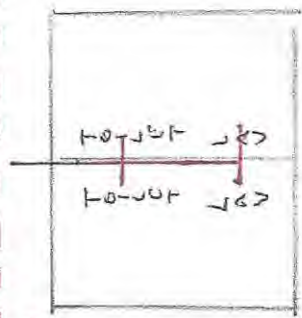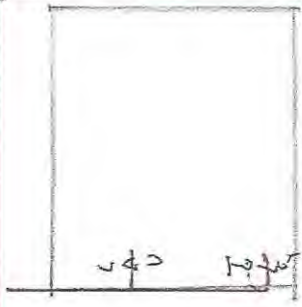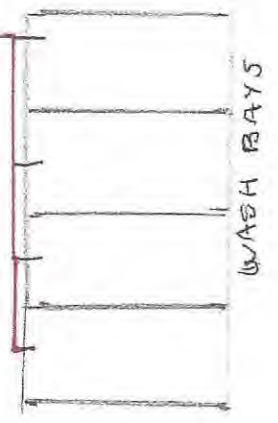

MAIN FEED LINE TO BUILDING A 1979


1" GALV. PIPE

BUCKEYE FORD 4939812

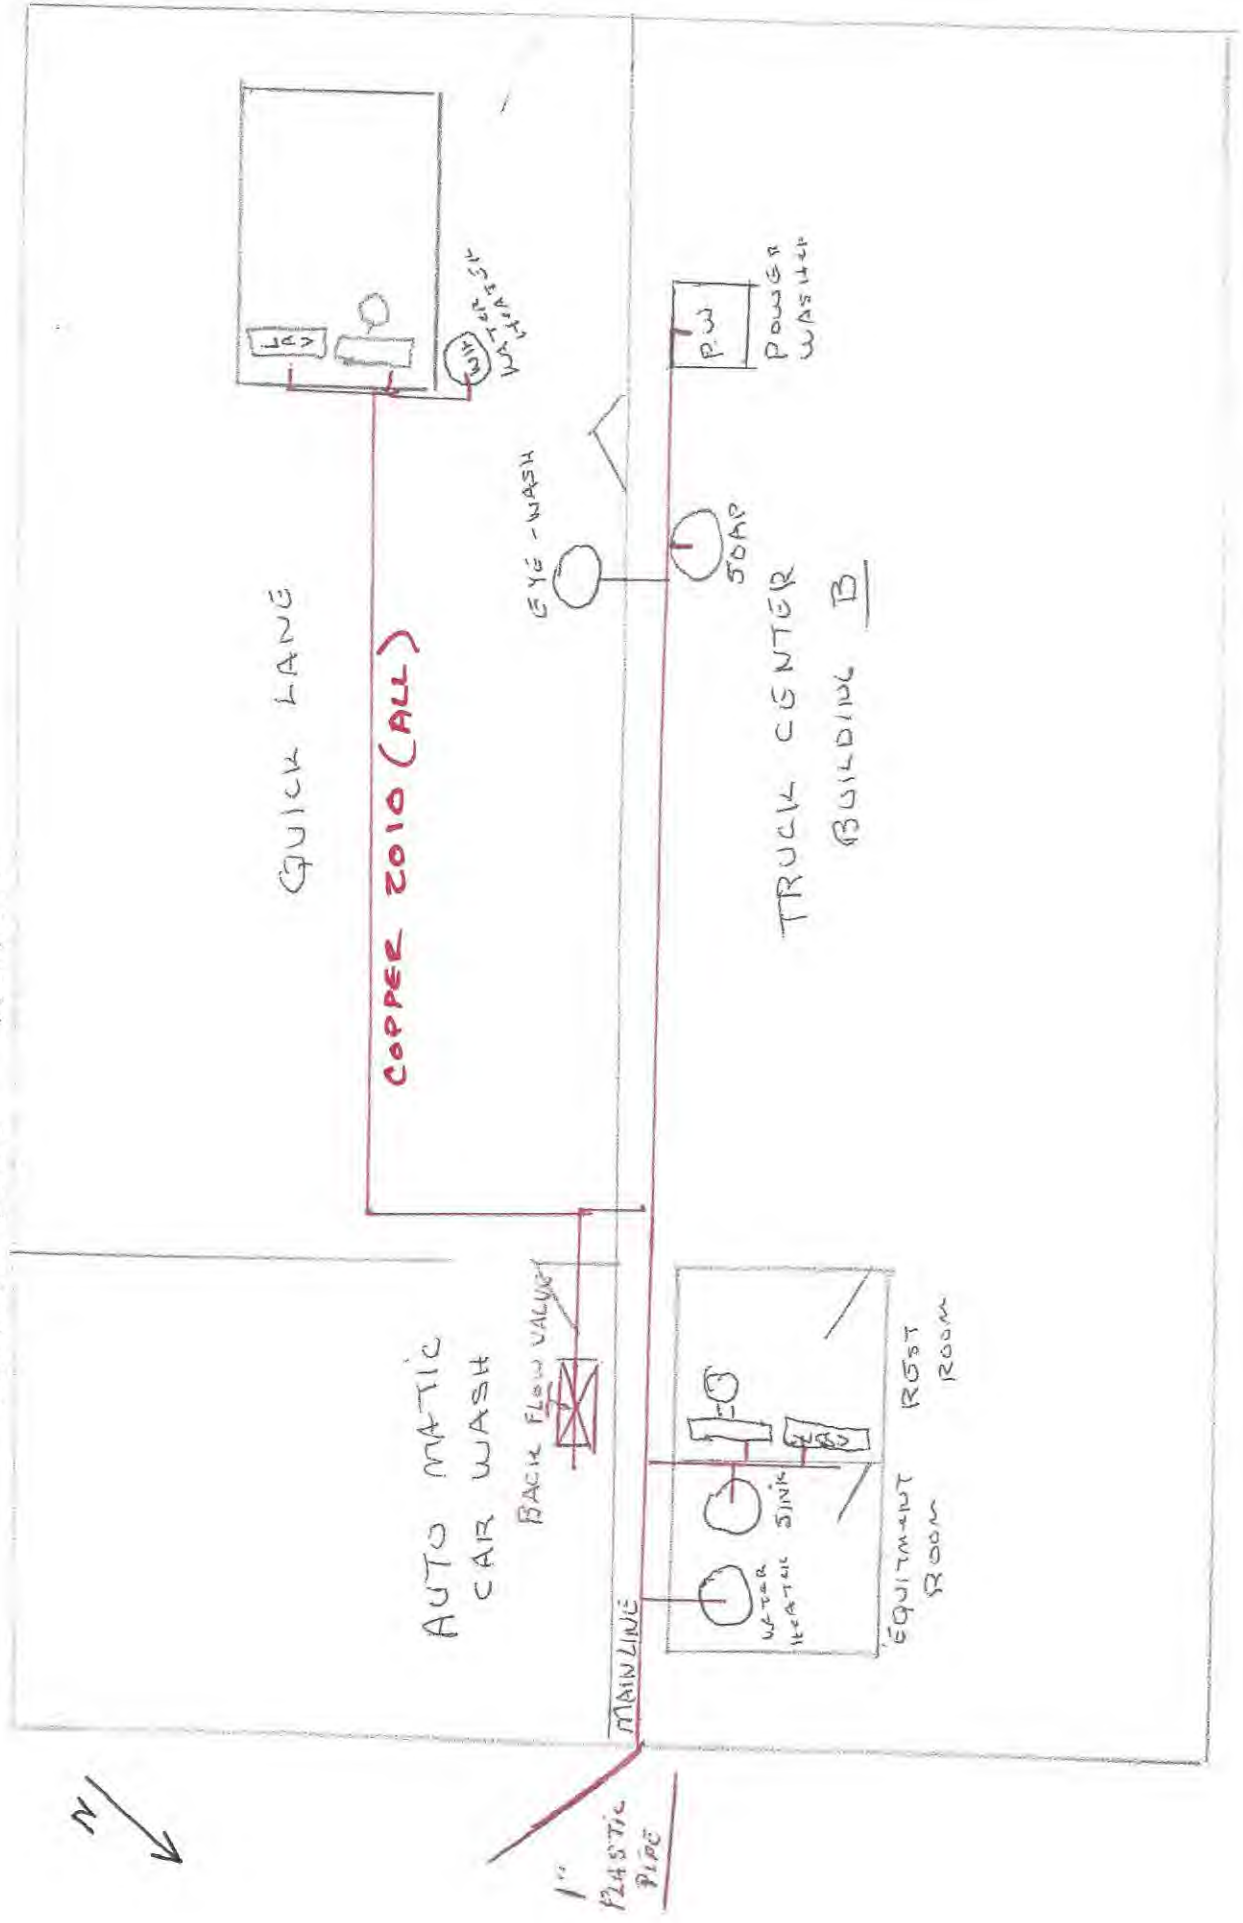

BUCKEYE FORD 4939812

COPPER ALL 1990

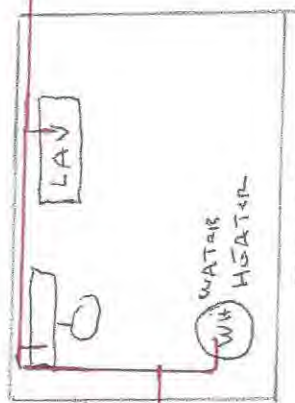

REST ROOM

3/4" COPPER  
FEED  
LINE

Hose  
FAUCET

Hose  
FAUCET

BUILDING C  
BODY SHOP

