

RE: Hillside MHP
Report
Drinking Water Program
Richland County
PWS ID: OH7002012

LEGEND

HIGHEST RISK — Copper pipes with potentially lead solder

All homes pre - 1998 and could contain lead solder

Lead/Copper Sample Sites

Non vacant lot (Home)


Vacant Lot (no Home)

NON LEAD

NO INFO



LOWEST RISK

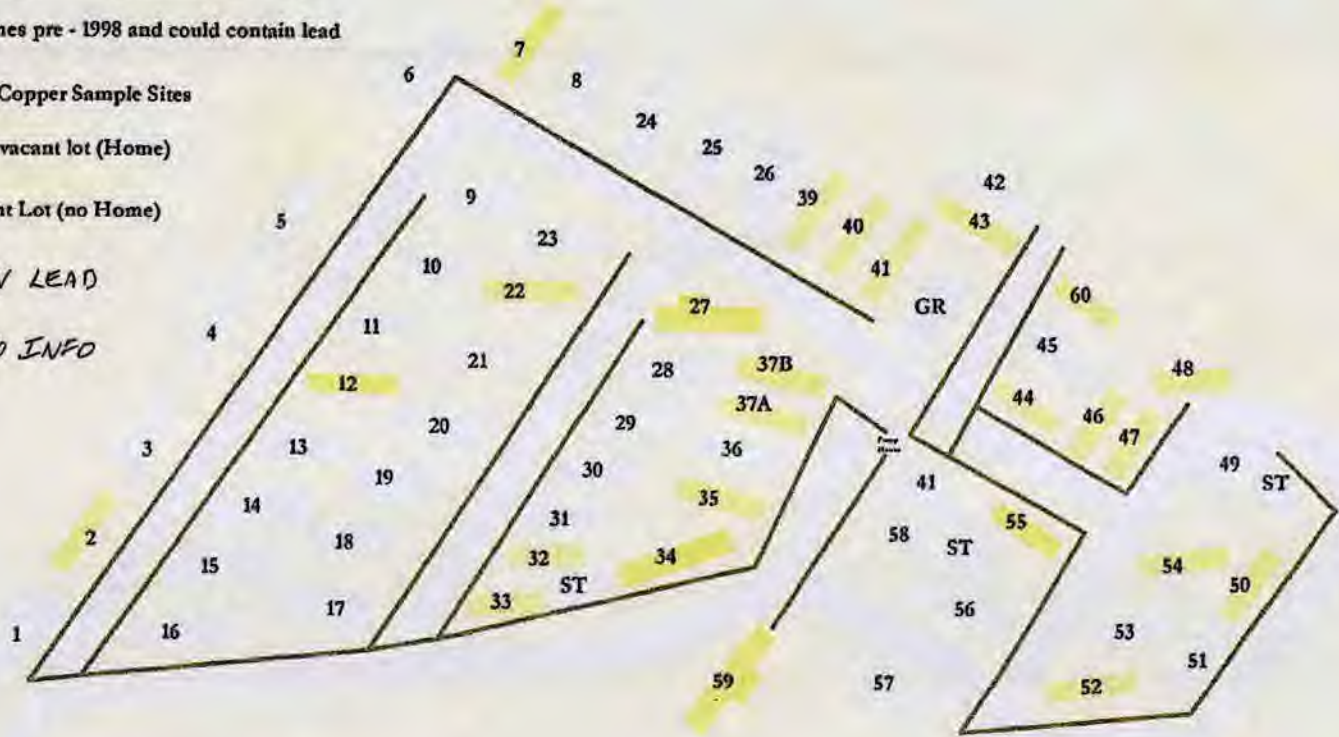

Ashland Rd

US-42 W



Ashland Rd

HILLSIDE MHP

PWS# OH 7002012

FACILITY ID# 7057665

CLASS A Community

2075 ASHLAND RD.

MANSFIELD, OH 44905

OWNER MIKE YOH 419-707-2552

RECEIVED

MAR 06 2017

DDAGW - NWDO

RECEIVED
REC
MAR 06 2017
MAR
DDAGW - NWDO
DDAG

Hillside MHP
PWS # OH7002012 Facility ID: 7057665
Class A Community
2075 Ashland Road
Mansfield, OH 44905
Mike Yoh, Owner (419) 707-2552
Lynn Moon, Maintenance (419) 610-7993

The complex and trailers were all built before 1998, and therefore, possible lead in the plumbing fittings and fixtures does exist. Because it is practically impossible to determine the lead content of an installed fixture, fitting or pipe, it should be assumed that the manufacture or installation date is the primary indicator of the lead content. Therefore, the characteristics of buildings and piping solder or fixtures would be buildings in Ohio built prior to 1998 or that use plumbing material or solder manufactured before 1998 may have materials with greater than 8% lead and are at a higher risk of contributing lead to the drinking water than materials manufactured after 1998. In addition, buildings built and plumbing materials manufactured after 2014 were required to have less than 0.25% lead by weight and have the lowest risk for contributing lead to the drinking water. It should be noted however that, although prohibited, some use of leaded solder or leaded components may have occurred after the prohibitions became effective.

The service line is plastic from the well to the building. The distribution system consists of approximately 25% copper and 75% plastic water lines. These lines were installed prior to 1998. After review of the historical maintenance records and talking with maintenance personnel, there is no evidence of lead lines, but the situation of them existing is still present.

Operator of Record:

Michael Fry (419) 560-0384
Lyn Moon (419) 610-7993