


PRIDE OF THE HILLS

8991 EAST LINCOLNWAY
ORRIVILLE, OH 44667

ALL COPPER INSIDE
BEFORE 1982

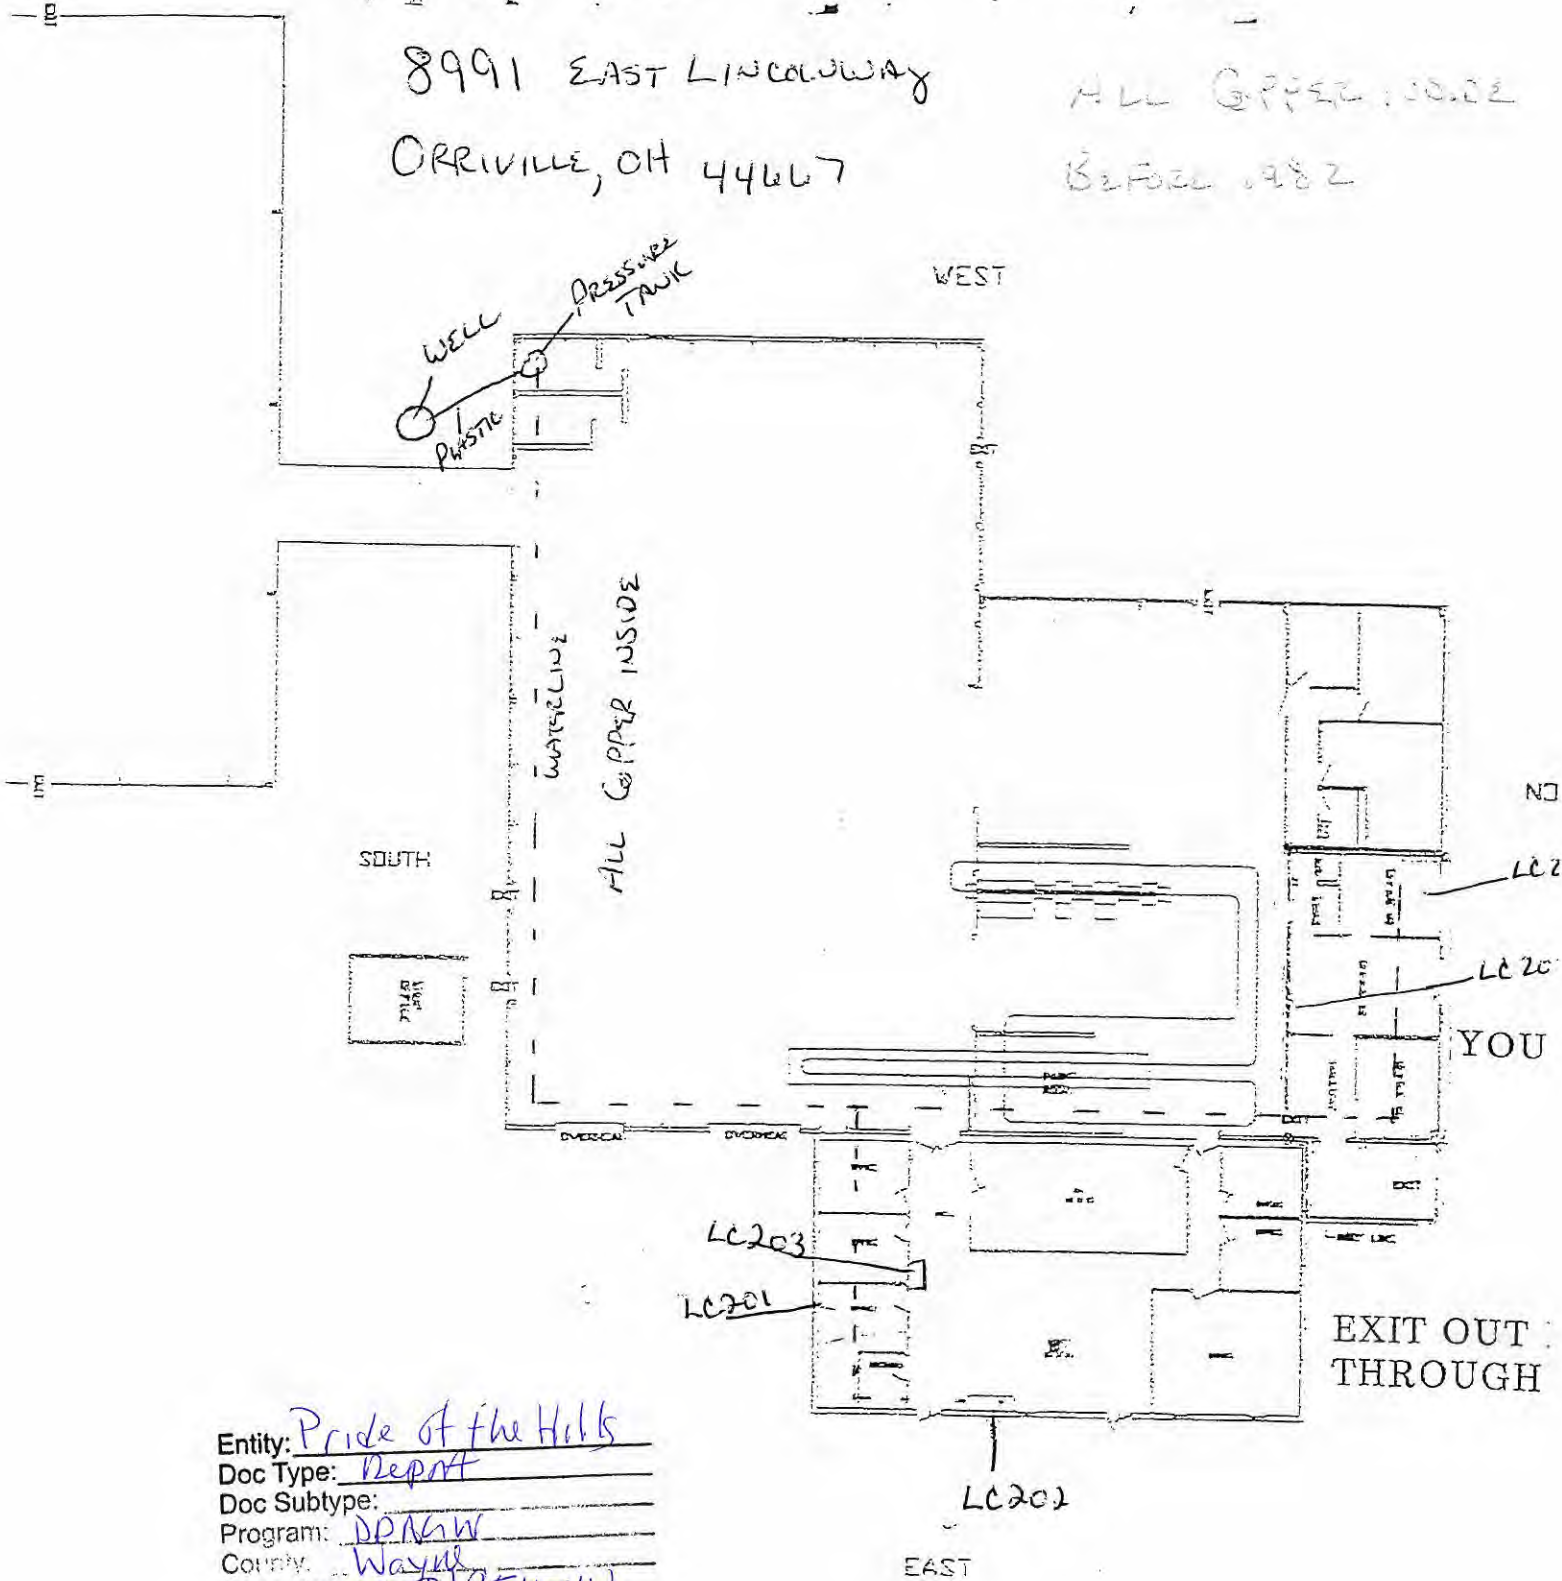

Entity: Pride of the Hills
Doc Type: Report
Doc Subtype: _____
Program: DPAGW
County: Wayne
Secondary ID: 078557112