

Lead & Copper Mapping Project

PWS Name: Metzenbaum Transportation Garage

PWS #: OH 2876312

Year Built: 2011

Service Line Material: Non-Lead

If you have any questions, please contact:


Clearwater Operations & Maintenance

10180 Queens Way #3

Chagrin Falls, OH 44023

440-708-0266

clearwater@clearwaterops.com

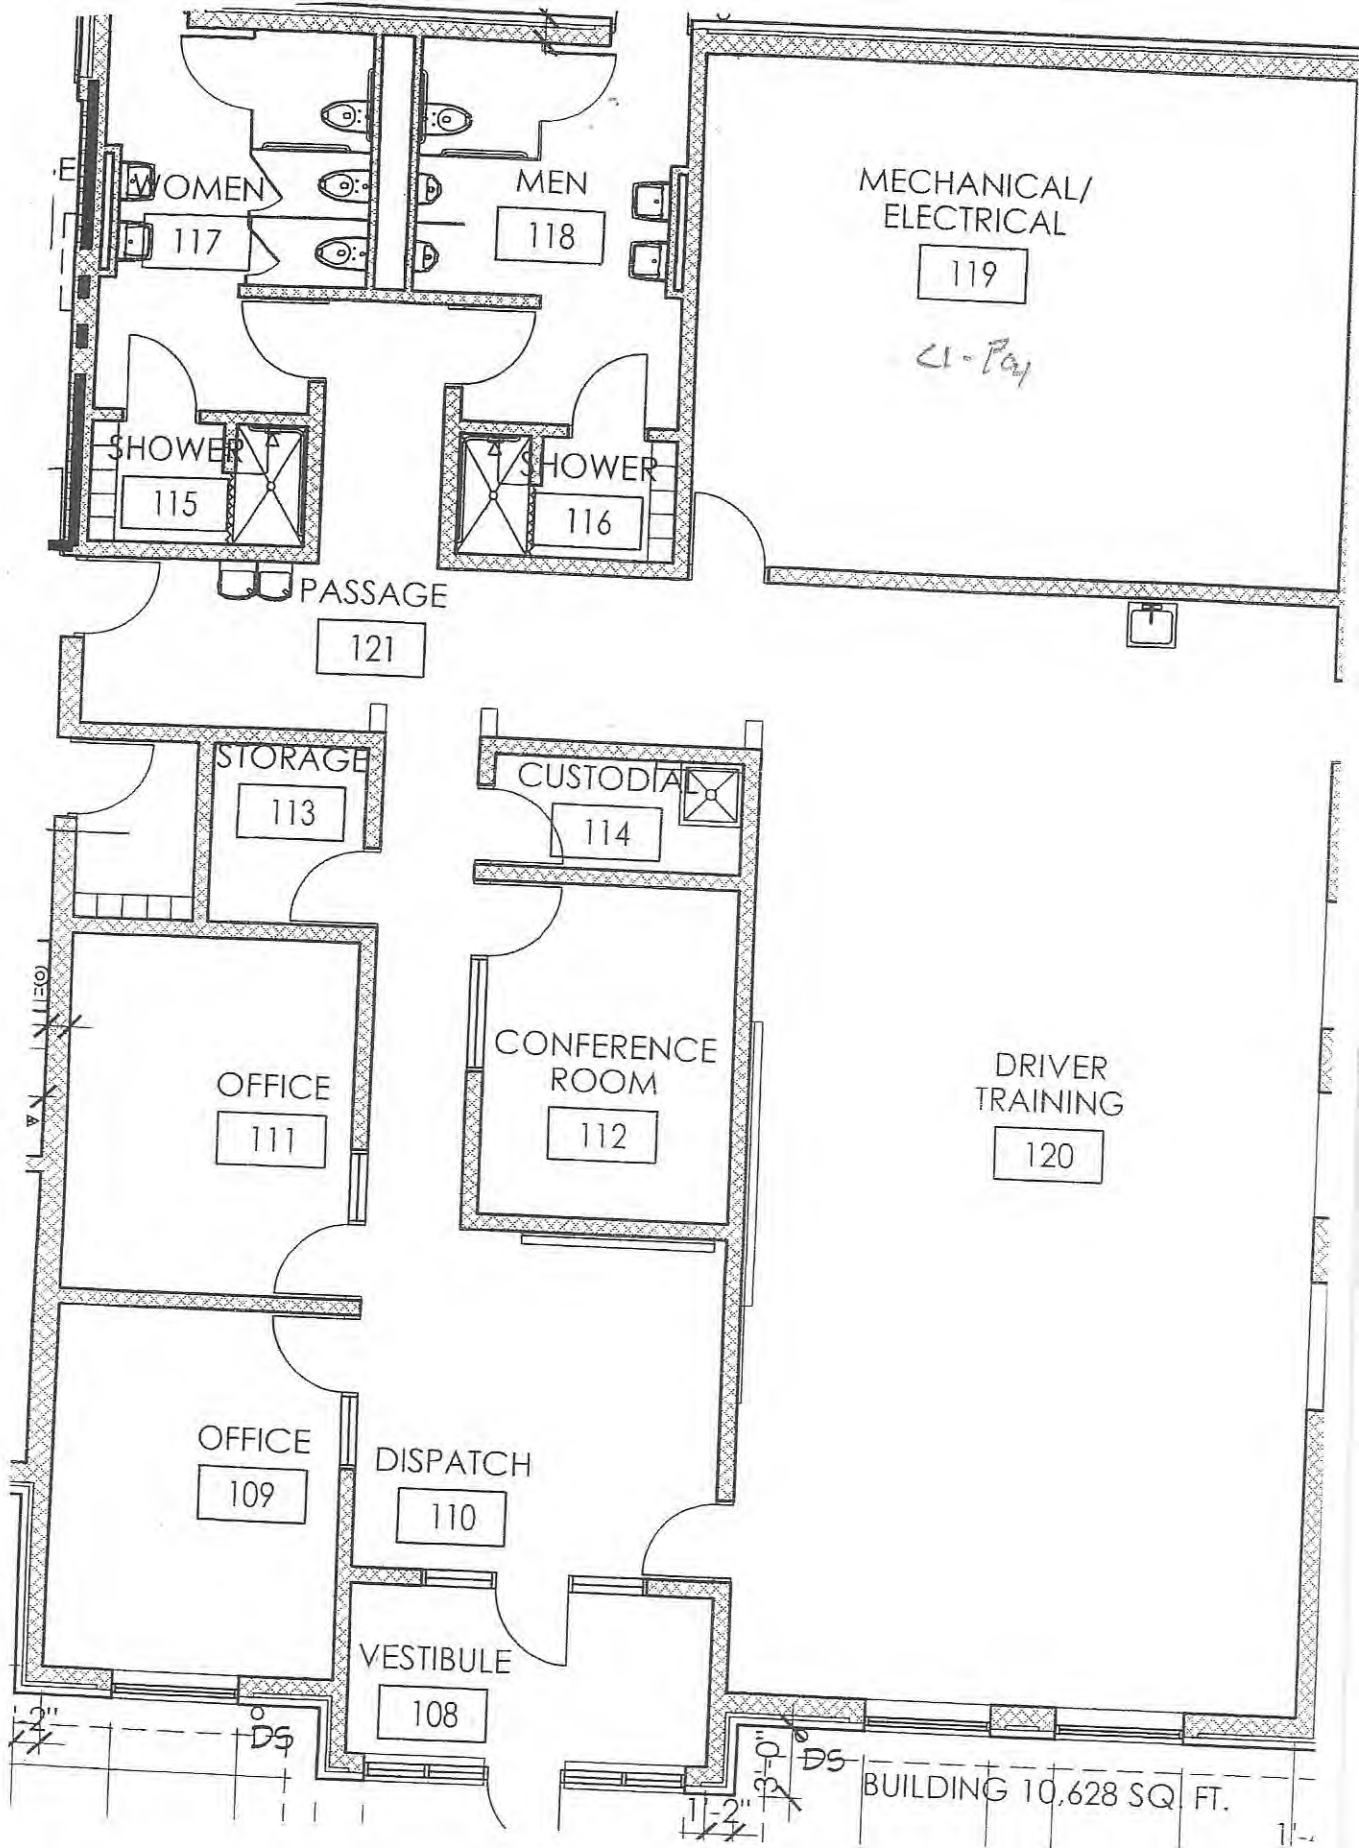

TRANSPORTATION
1975



Metzenbaum
Transportation
Garage

