



City of Martins Ferry Ohio

Water Treatment Plant
400 N. 1st Street, Martins Ferry, Ohio 43935
Phone (740)633-1378 Fax (740) 633-0608

February 27, 2017

The Martins Ferry Water System serves both residential and commercial buildings with a vast age range. Our water main lines are made up of various types of pipe in all sizes from 2" to 20". The following explanation will give details to the attached map:

- The green shaded areas of our system are considered "low risk" areas. This is because our water mains have been replaced and all lead service lines have been replaced as well. We have no information about the plumbing fixtures inside these structures.
- The yellow shaded areas of our system are considered "high risk/ no information" areas. We have little or no information on our joints, service lines and plumbing fixtures within the structures.
- The purple squares on our system are the 23 lead monitoring points that were submitted in 2014. (there is a list of all addresses attached with this report)


Martins Ferry is currently sending out informational pamphlets to all customers about their service lines and plumbing fixtures so we can update our map in the future.

All employees of Martins Ferry Water are being trained to look for lead service lines and/or leaded joints in our system.

We will be doing our lead sampling again in June 2017.

RECEIVED
MAR 6 2017
Ohio Environmental
Protection Agency
Southeast District

Martins Ferry Water Distribution

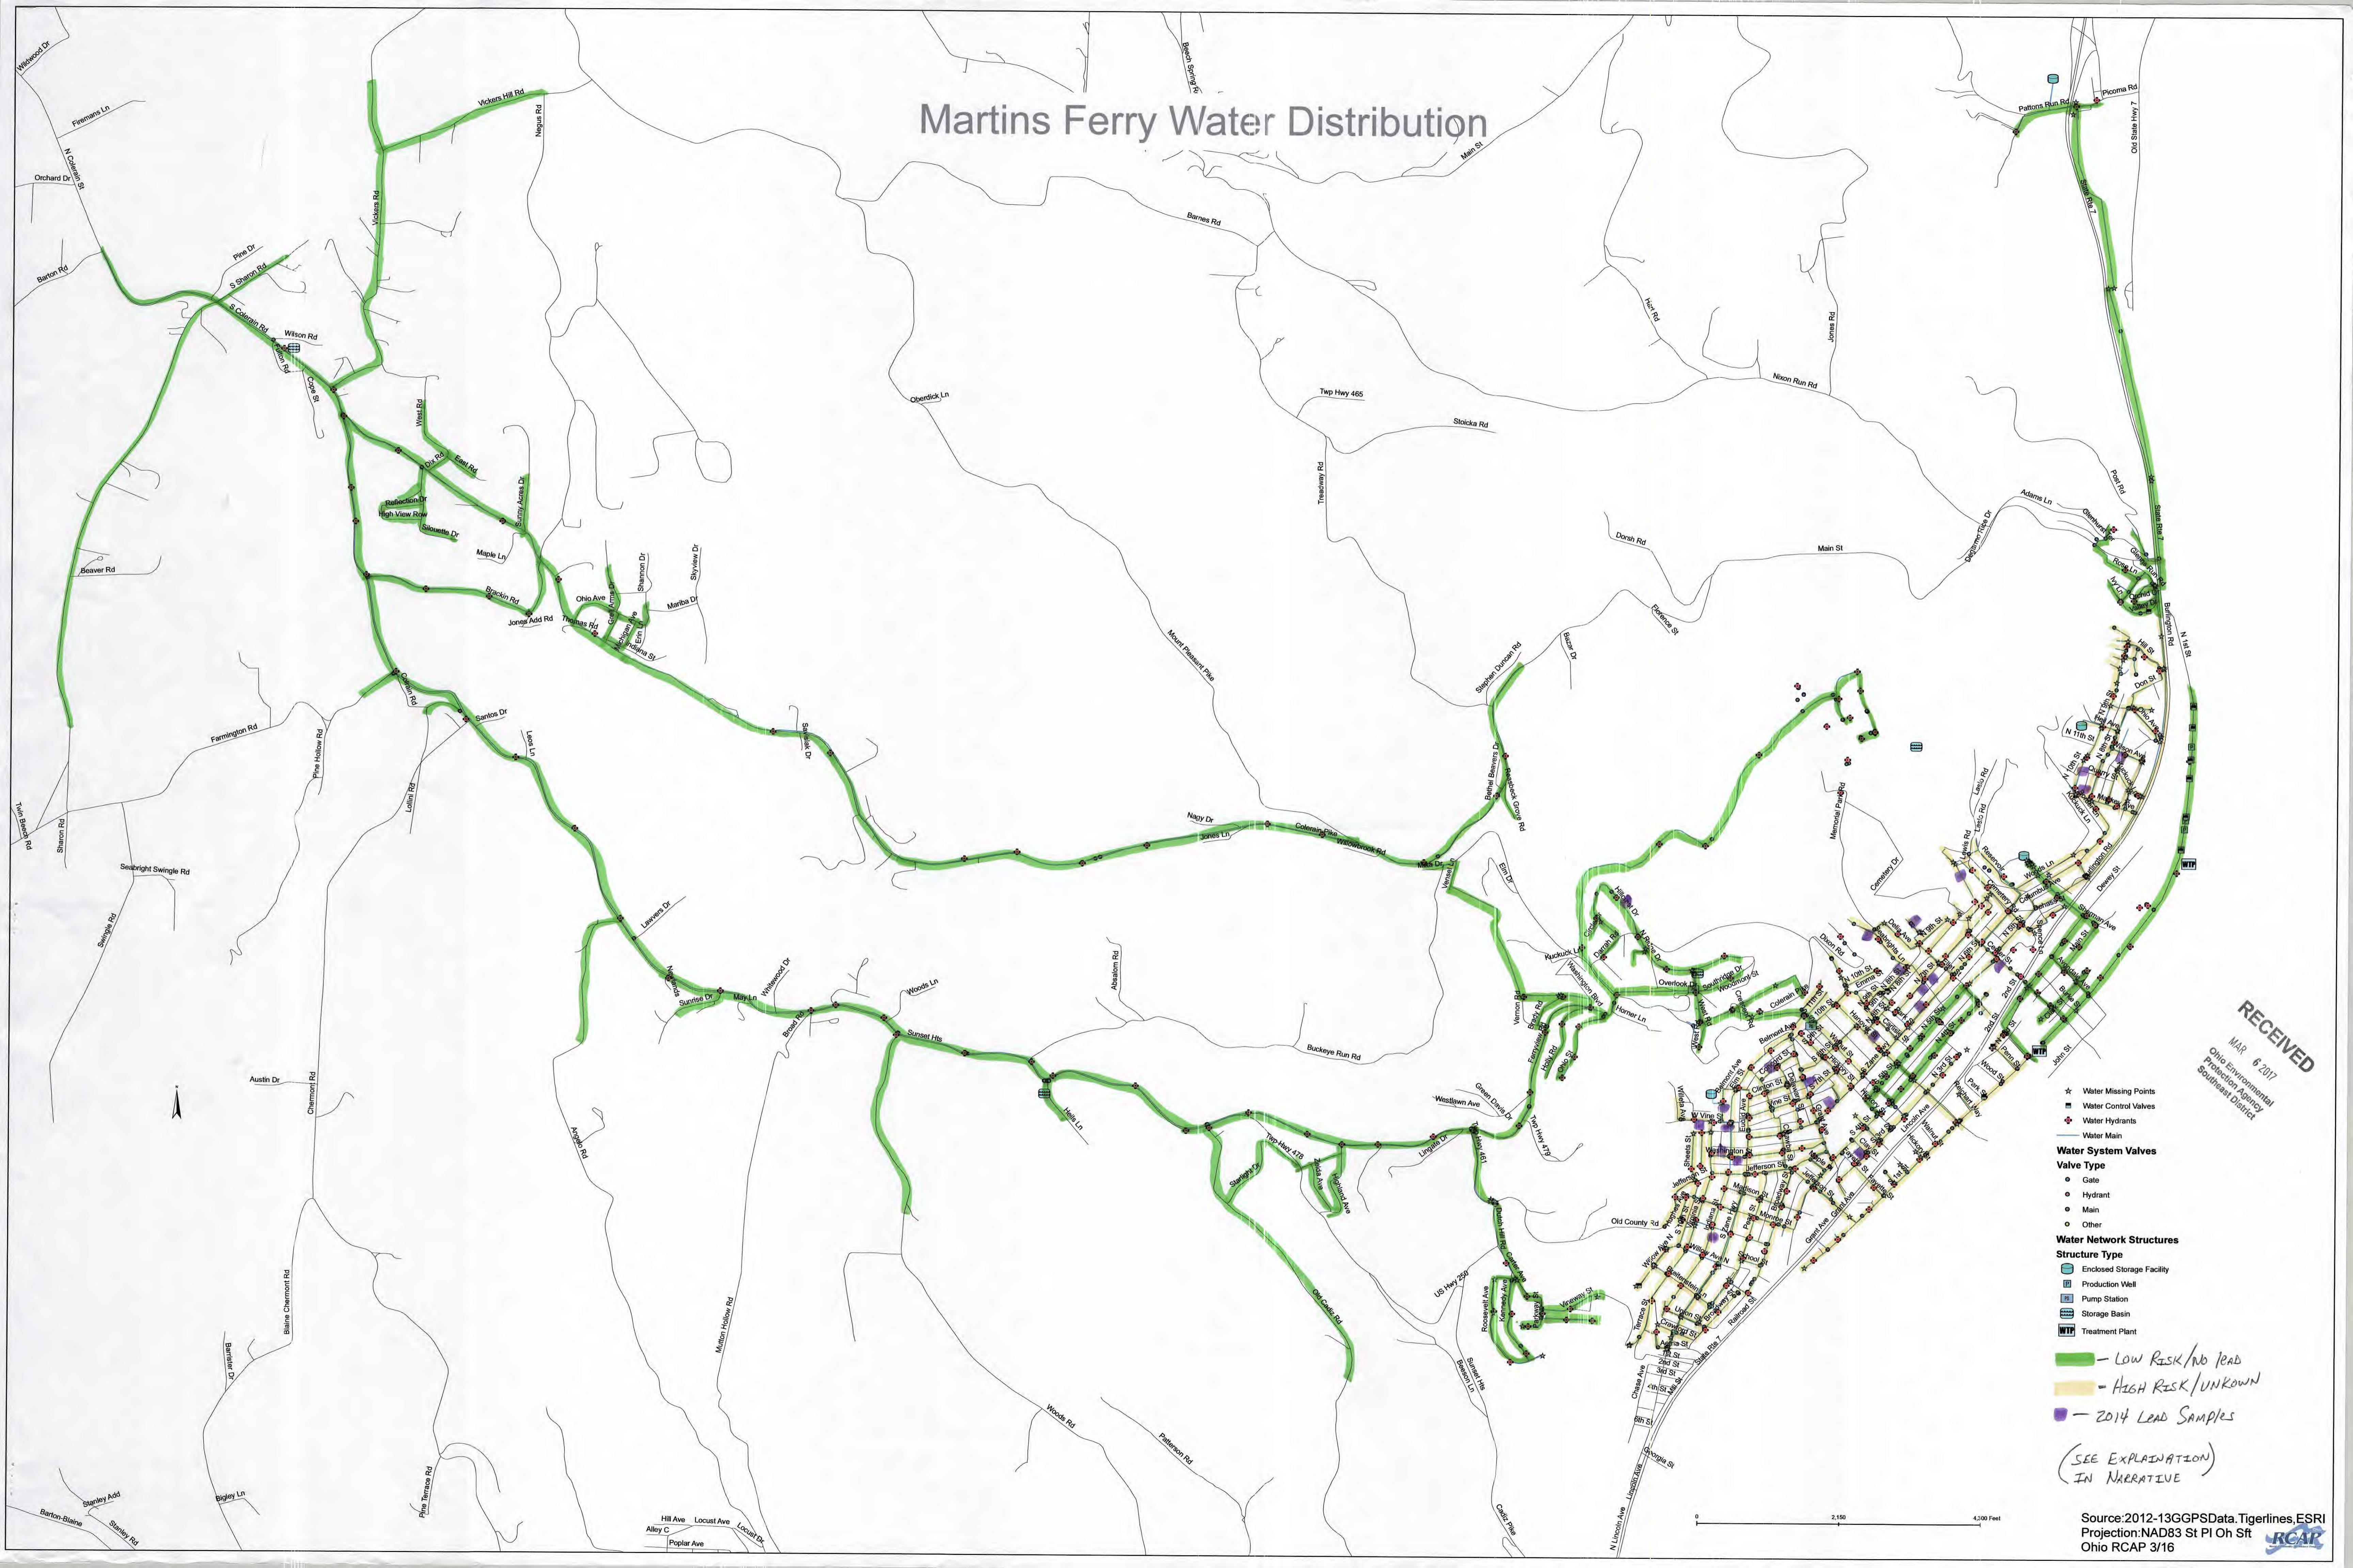

RECEIVED
MAR 6 2017
Ohio Environmental
Protection Agency
Southeast District

- ★ Water Missing Points
- Water Control Valves
- ◆ Water Hydrants
- Water Main
- Water System Valves**
- Valve Type**
- Gate
- Hydrant
- Main
- Other
- Water Network Structures**
- Structure Type**
- Enclosed Storage Facility
- Production Well
- Pump Station
- Storage Basin
- WTP Treatment Plant
- Low Risk/No Lead
- High Risk/Unknown
- 2014 Lead Samples

(SEE EXPLANATION)
IN NARRATIVE

0 2,150 4,300 Feet

