

MAR 02 2017

VERIFICATION FORM FOR COMMUNITY PUBLIC WATER SYSTEMS CLAIMING NO LEAD SERVICE LINES OHIO EPA NEDC

The owner or operator of all community public water systems must identify and map areas of their distribution system that are known or are likely to contain lead service lines. Systems must submit a copy of the applicable map to the Ohio Department of Health and the Ohio Department of Job and Family Services. Systems must also submit a report to the director containing at least both of the following: (1) The applicable map with narrative, and (2) A list of sampling locations used to collect samples as required by Ohio Revised Code (ORC) Section 6109.121 and any rules adopted thereunder, including contact information for the owner and occupant of each sampling site.

Should a water system determine no lead service lines exist in their distribution system, they must provide information stating they reviewed, at the minimum, historical permit records and local ordinances, distribution maintenance records and information pertaining to installation dates or materials for all services lines. This information must be verified below.

I HEREBY CERTIFY THAT THE FOLLOWING METHOD(S) WERE USED TO DETERMINE NO LEAD SERVICE LINES EXIST IN THIS WATER SYSTEM'S DISTRIBUTION SYSTEM, AS REQUIRED BY ORC 6109.121(F):

LEAD SERVICE LINE VERIFICATION	
This PWS states they have no lead service lines and has reviewed the following information (select one or more of the following):	
<input checked="" type="checkbox"/>	Historical permit records and/or local ordinances
<input checked="" type="checkbox"/>	Distribution maintenance records (i.e. meter replacement, waterline break repairs)
<input checked="" type="checkbox"/>	Information pertaining to installation dates for all service lines (i.e. after 1986 when lead services lines were banned)
<input type="checkbox"/>	Service line material of all service lines is known (i.e. all service lines are known to be PVC)

Elaine Zahurak 3/1/17
 Signature of Responsible Person Date

Elaine Zahurak
 Printed Name and Title of Responsible Person

PWS NAME: Nelson Ledge Estates
 PWS ID: OH 6702412
 COUNTY: Portage


For Ohio EPA use only: Date Verification Rec'd: _____


Entity: Nelson Ledges Estates
 Doc Type: Report
 Doc Category: _____
 Program: SDACW
 County: Portage
 Secondary ID: 116702412

EDA in color 4

Water Flow

WATER FLOW

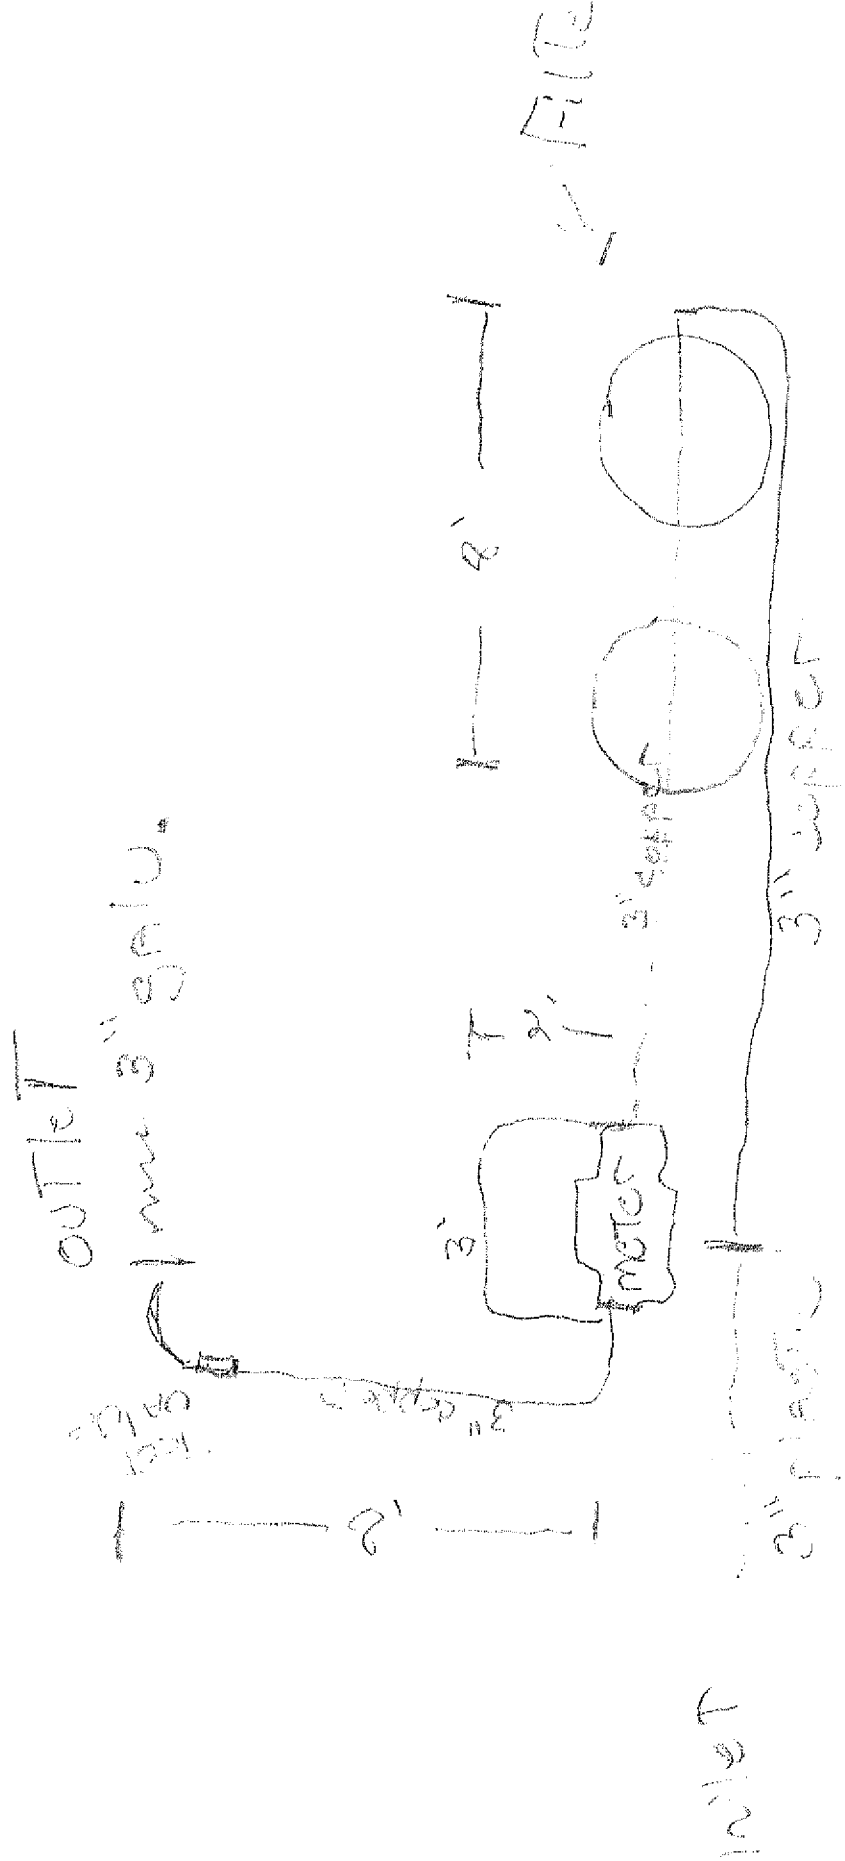

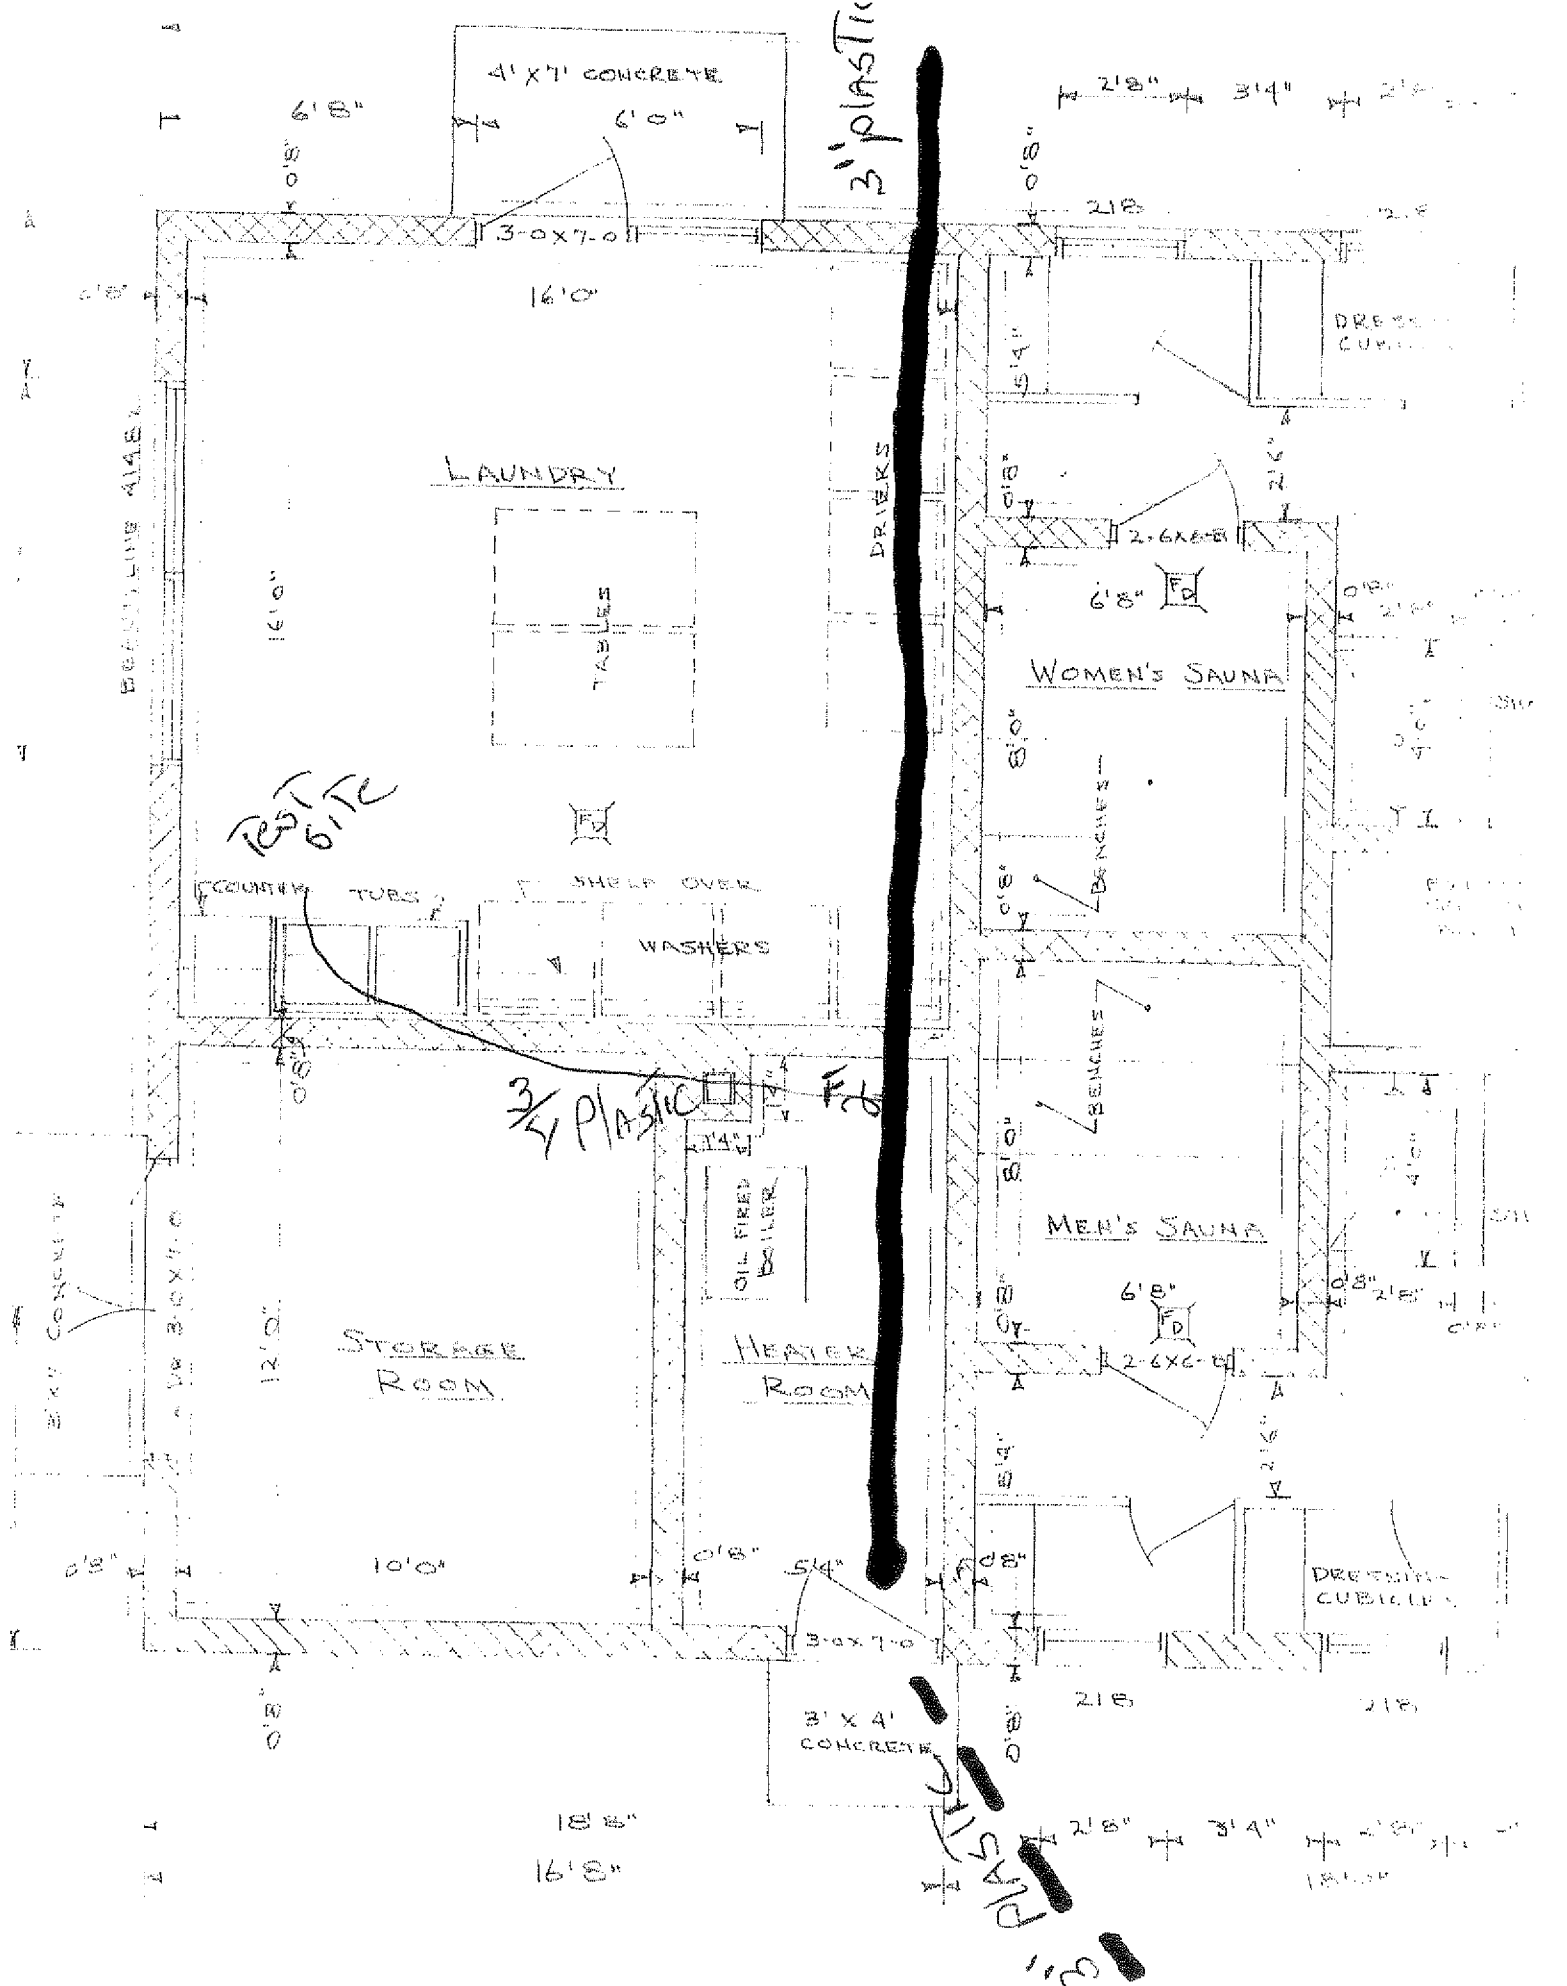

4' X 7' CONCRETE
6' 0"

3' PLASTIC

2' 8" 3' 4" 2' 8"

1

6' 0"

3-0 X 7-0

0' 8"

2' 8"

2' 8"

BEAUTY LINE ALBER

16' 0"

LAUNDRY

TABLES

DRIERS

5' 4"

DRESSING CUBICLES

TEST BIT

6' 8" FD

WOMEN'S SAUNA

COUNTERTOPS

SHIELD OVER

WASHERS

6' 0"

6' 0"

3/4 PLASTIC

2 1/2" CONCRETE

12' 0"

STORAGE ROOM

OIL FIRED BOILER

HEATER ROOM

MEN'S SAUNA

6' 8" FD

0' 8"

10' 0"

0' 8"

5' 4"

5' 4"

5' 4"

DRESSING CUBICLES

0' 8"

3' X 4' CONCRETE

2' 8"

2' 8"

18' 8"

16' 8"

3' PLASTIC

2' 8"

3' 4"

2' 8"

18' 8"


RECEIVED

N.E. PORTAGE COUNTY SANITARY SEWER DISTRICT
PART OF O.L. 36, NELSON TWP.
NELSON LEDGE ESTATES
PROJECT NO. _____

BANCROFT ROAD

GARRETTSVILLE - PARKMAN

ROAD S.R.282

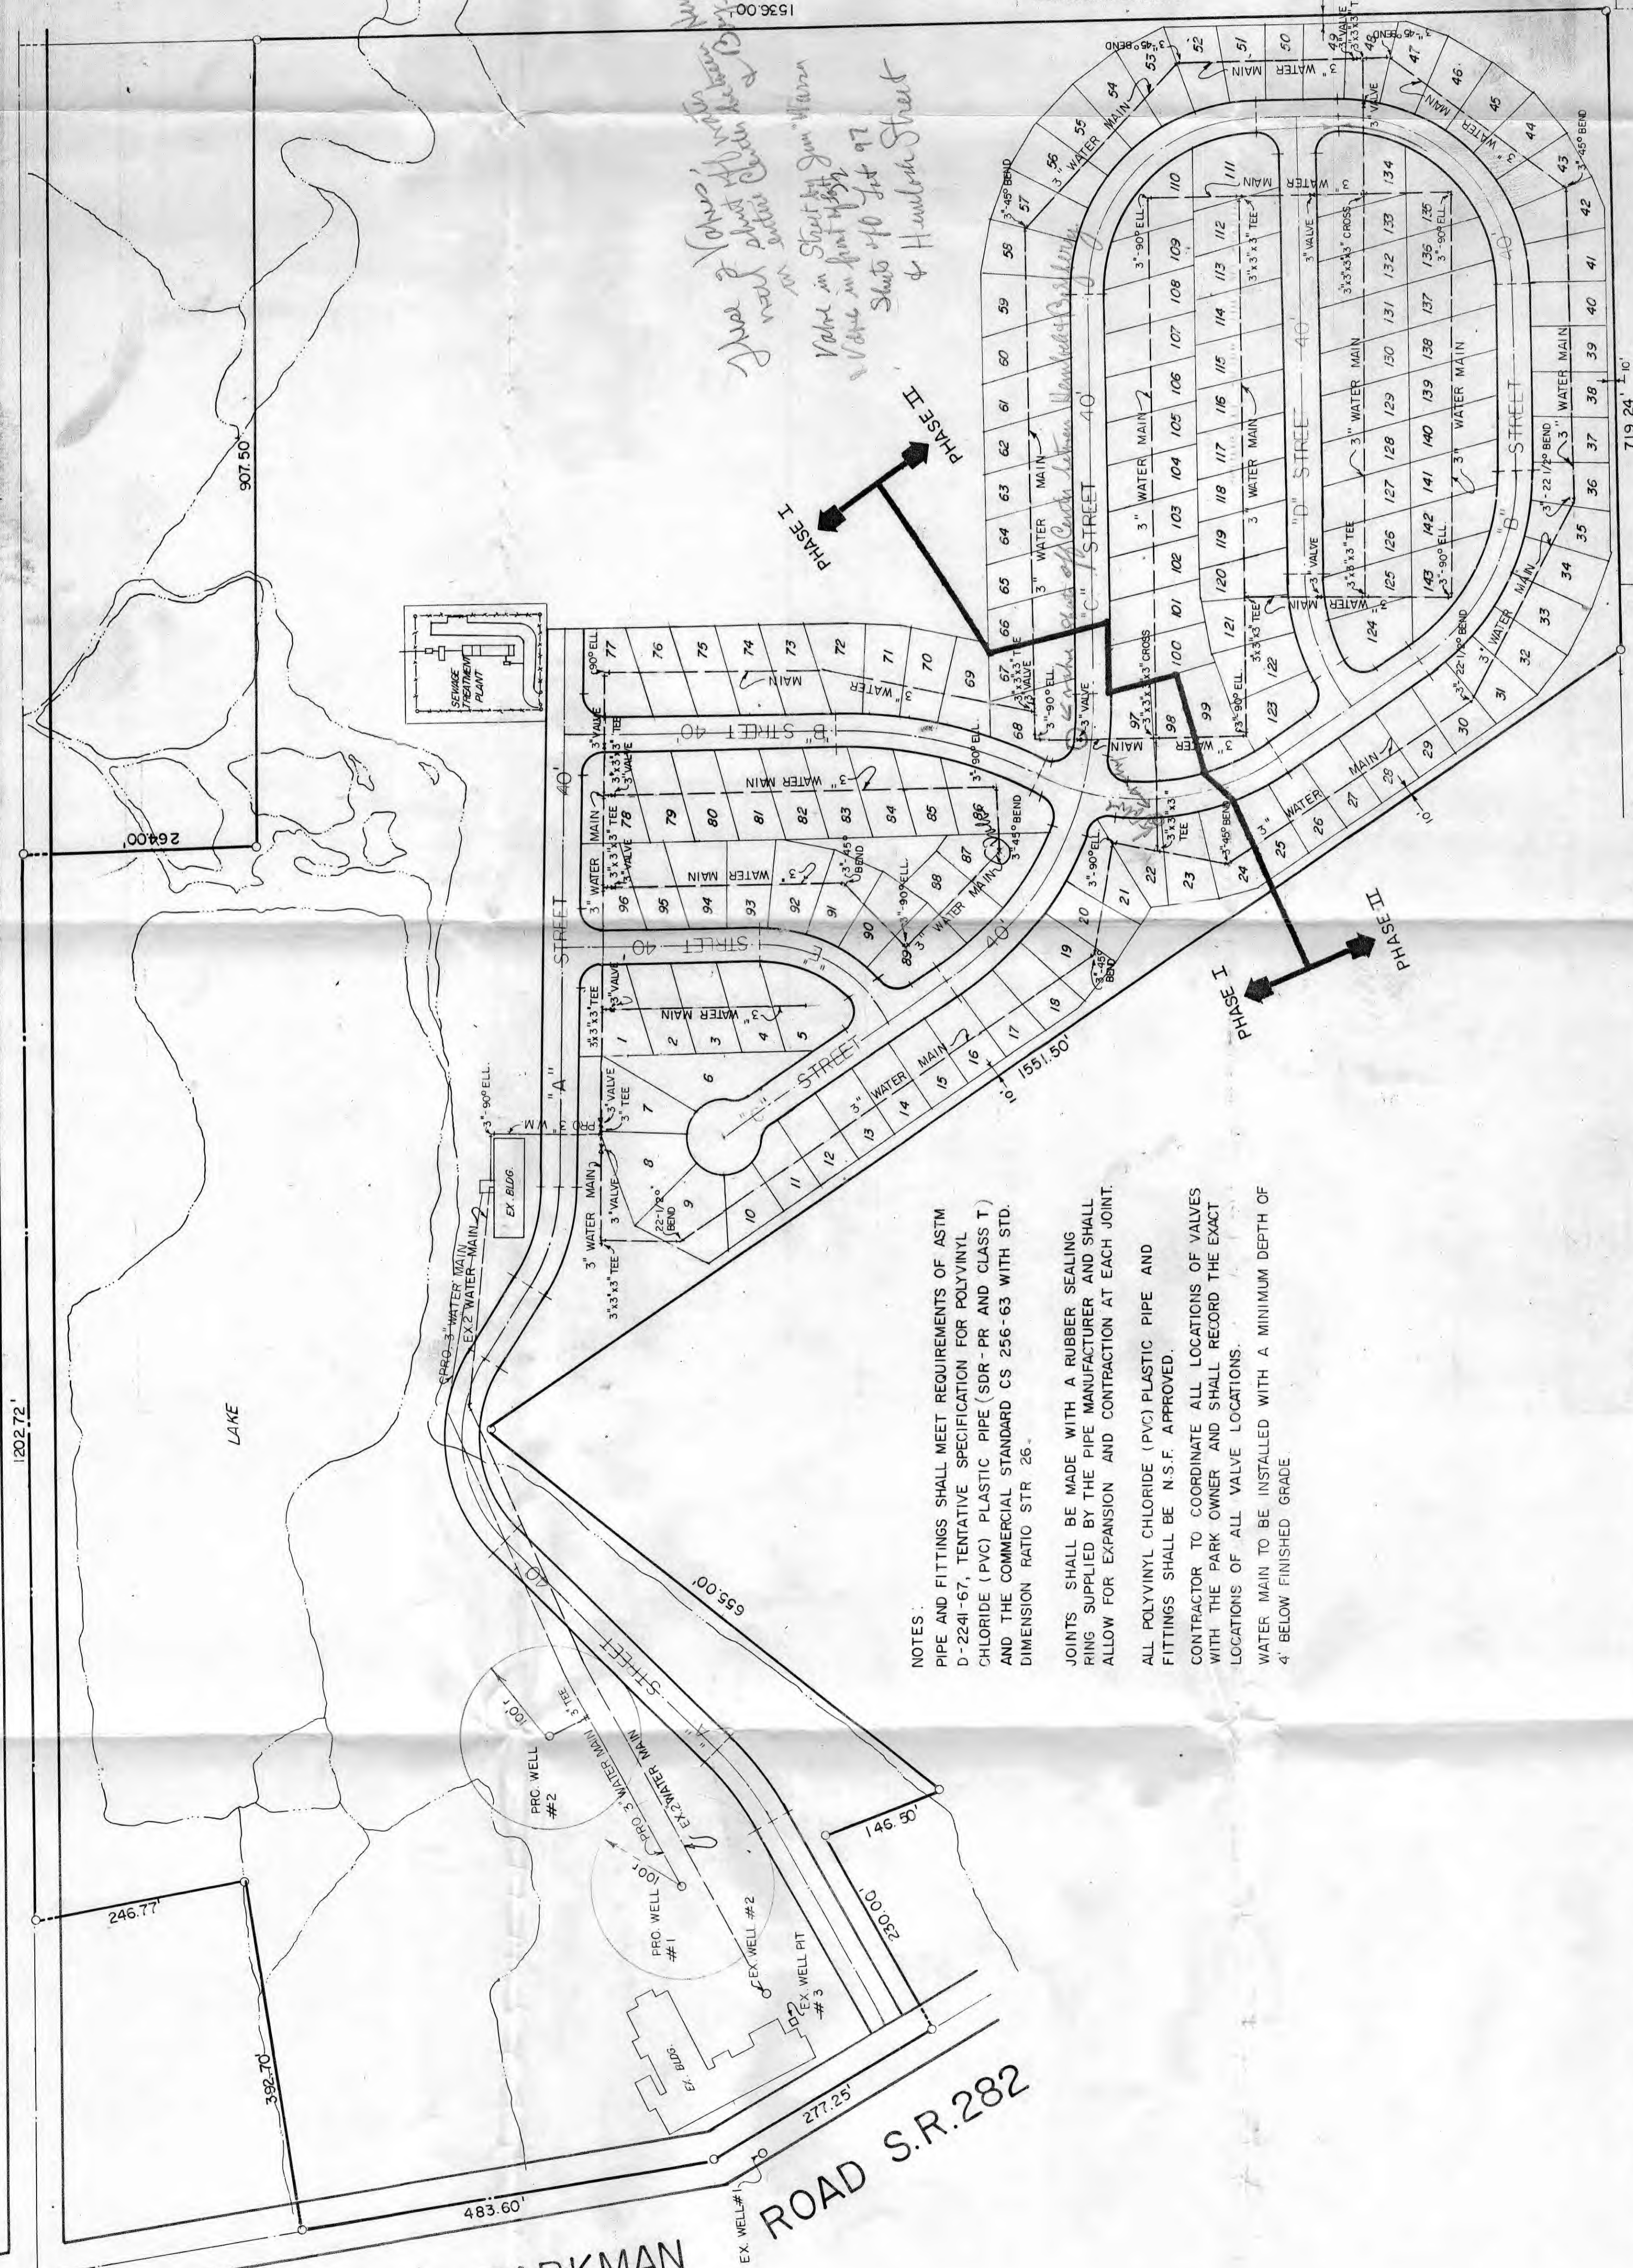

NOTES:

ALL PIPE AND FITTINGS SHALL MEET REQUIREMENTS OF ASTM D-2241-67, TENTATIVE SPECIFICATION FOR POLYVINYL CHLORIDE (PVC) PLASTIC PIPE (SDR - PR AND CLASS T) AND THE COMMERCIAL STANDARD CS 256-63 WITH STD. DIMENSION RATIO STR 26.

JOINTS SHALL BE MADE WITH A RUBBER SEALING RING SUPPLIED BY THE PIPE MANUFACTURER AND SHALL ALLOW FOR EXPANSION AND CONTRACTION AT EACH JOINT.

ALL POLYVINYL CHLORIDE (PVC) PLASTIC PIPE AND FITTINGS SHALL BE N.S.F. APPROVED.

CONTRACTOR TO COORDINATE ALL LOCATIONS OF VALVES WITH THE PARK OWNER AND SHALL RECORD THE EXACT LOCATIONS OF ALL VALVE LOCATIONS.

WATER MAIN TO BE INSTALLED WITH A MINIMUM DEPTH OF 4' BELOW FINISHED GRADE

SEWERAGE APPROVED
STATE OF OHIO DEPARTMENT OF HEALTH
AS EVIDENCED BY COPY OF LETTER OF APPROVAL HERETO ATTACHED

BENCH MARK:
TOP OF IRON PIPE AT THE CENTERLINE
INTERSECTION OF STATE ROUTE 282
AND BANCROFT ROAD
U.S.G.S. ELEV. 956.21

TRAILER PARK APPROVED
STATE OF OHIO DEPARTMENT OF HEALTH
AS EVIDENCED BY COPY OF LETTER OF APPROVAL HERETO ATTACHED

WATER SUPPLY APPROVED
STATE OF OHIO DEPARTMENT OF HEALTH
AS EVIDENCED BY COPY OF LETTER OF APPROVAL HERETO ATTACHED

RECEIVED
MAY 12 1972
OHIO DEPARTMENT OF HEALTH

Handwritten notes:
Value in Street at Jun. 11/71
Value in front of lot 97
Shuts off Hancock Street

GENERAL PLAN OF WATER SYSTEM	SCALE: 1" = 100'	DRAWN BY: eib	SHEET 5
OWNER / DEVELOPER IRENE WORK • GARRETTSVILLE, OHIO	DATE: NOV., 1971	CHECKED BY:	
ROBERT C. WINEBRENNER & ASSOCIATES CONSULTING ENGINEERS 1050 NORTH MAIN STREET AKRON, OHIO		REVISED:	
			FILE NO. 500