


RE: Manufactured Housing Enterprises
Report
Drinking Water Program
Williams County
PWS ID: OH8636412

MANUFACTURED HOUSING ENTERPRISES, INC.
09302 US RT 6
BRYAN, OH 43506

RECEIVED

MAR 03 2017

DDAGW - NWDO

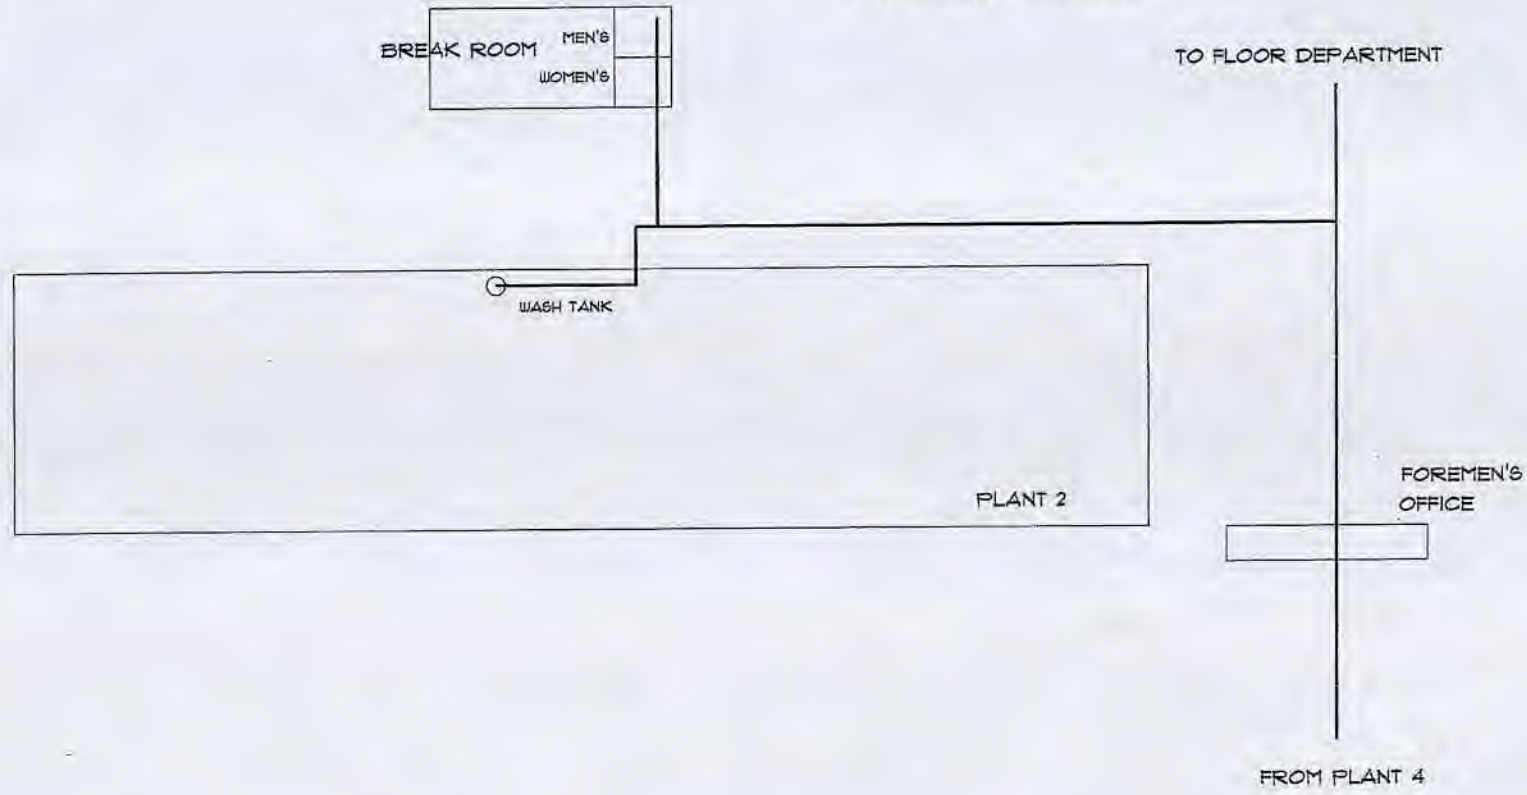


WH -WATER HEATER
— -WATER LINE- UN-LEADED




MHE INC. PLANT 2

MANUFACTURED HOUSING ENTERPRISES, INC.
09302 US RT 6
BRYAN, OH 43506

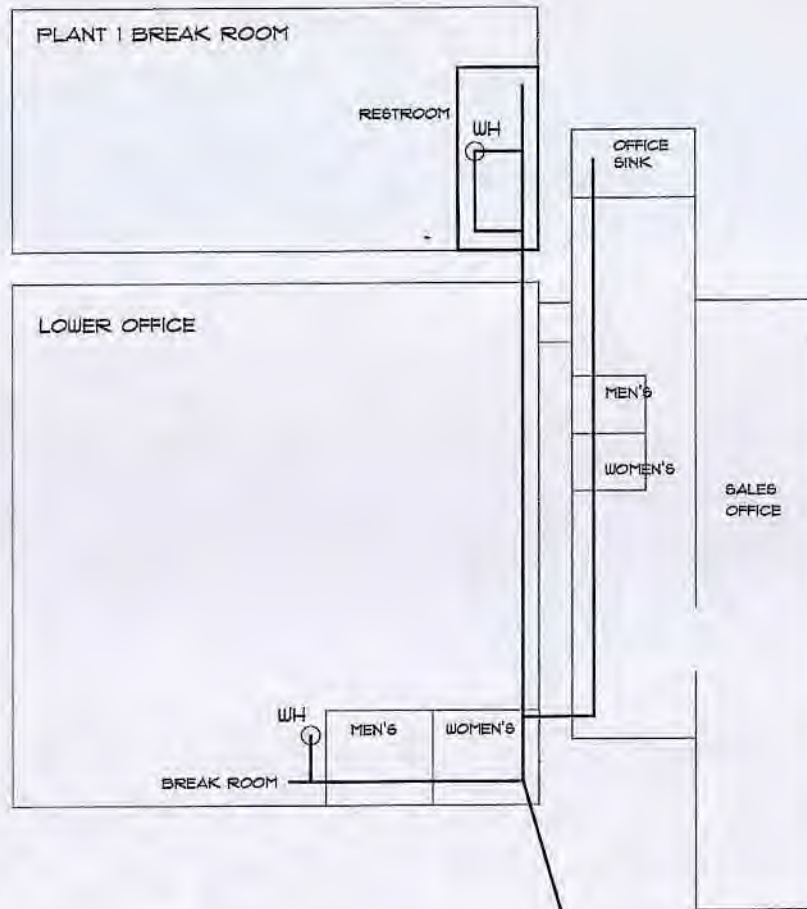

RECEIVED
MAR 03 2017
DDAGW - NWDO

WH -WATER HEATER
— -WATER LINE- UN-LEADED

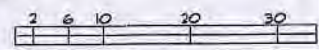

MHE INC. FRONT OFFICE


MANUFACTURED HOUSING ENTERPRISES, INC.
09302 US RT 6
BRYAN, OH 43506




RECEIVED

MAR 03 2017

DDACW - NWDO

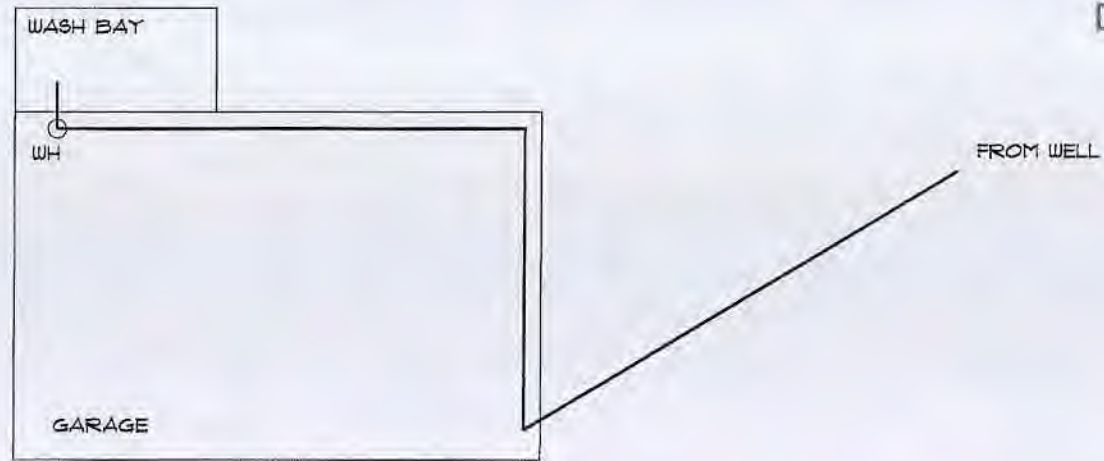

WH -WATER HEATER
— -WATER LINE- UN-LEADED

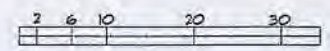

MHE INC. GARAGE

MANUFACTURED HOUSING ENTERPRISES, INC.
09302 US RT 6
BRYAN, OH 43506




TO FOREMAN'S OFFICE

RECEIVED

MAR 03 2017

DDAGW - NWDO

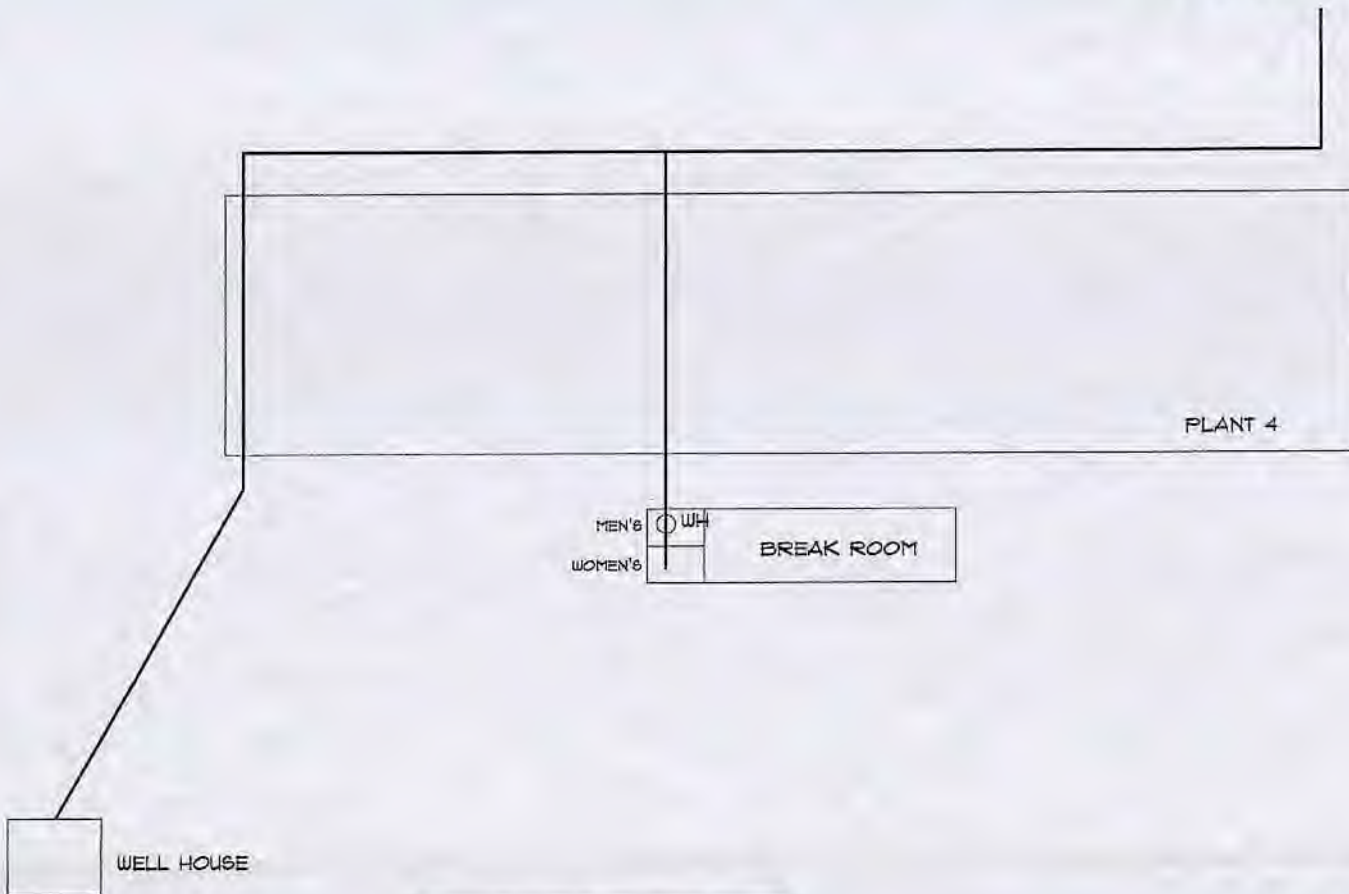

WH - WATER HEATER
— - WATER LINE - UN-LEADED



MHE INC.

PLANT 4


MANUFACTURED HOUSING ENTERPRISES, INC.
09302 US RT 6
BRYAN, OH 43506




RECEIVED

MAR 03 2017

DDAGW - NWDO

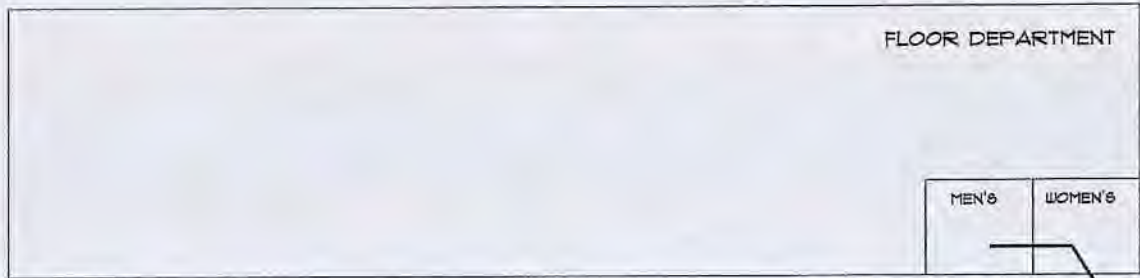

FROM FOREMEN'S OFFICE

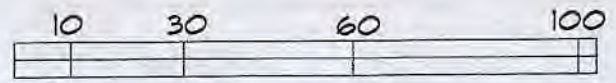

WH -WATER HEATER
— -WATER LINE- UN-LEADED

MHE INC. FLOORS