

3001
S.E. 11

2017 MAR -6 PM 1:25

Village of Quaker City
Facility ID# 3001011
March 5, 2017

Michael Carper
Ohio EPA
P.O. Box 1049
Columbus, Ohio 43216-1049

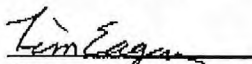
Re: Verification Form for PWS claiming no lead service lines.

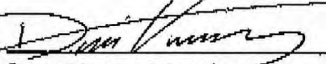
Dear Michael Carper,

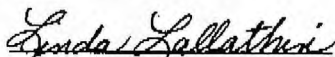
Any written documentation for the claim of no lead service lines has previously been destroyed by flooding in our village or by other means. We have the word of Patric Tracy, our Operator of Record, that in the 8-10 years of his employment here, and for previous years that he worked with Robert Stephen (deceased), there were no lead lines found during the numerous water line breaks. The water lines were installed by the WPA in 1935, and copper was used in our village.

Please find the attached documents which should provide the information needed.

Village of Quaker City
Board of Public Affairs


Tim Eagon, President


Dave Vargo, Member


Linda Lallathin, Clerk

Enc./Isl (2)

VERIFICATION FORM FOR COMMUNITY PUBLIC WATER SYSTEMS CLAIMING NO LEAD SERVICE LINES

The owner or operator of all community public water systems must identify and map areas of their distribution system that are known or are likely to contain lead service lines. Systems must submit a copy of the applicable map to the Ohio Department of Health and the Ohio Department of Job and Family Services. Systems must also submit a report to the director containing at least both of the following: (1) The applicable map with narrative, and (2) A list of sampling locations used to collect samples as required by Ohio Revised Code (ORC) Section 6109.121 and any rules adopted thereunder, including contact information for the owner and occupant of each sampling site.

Should a water system determine no lead service lines exist in their distribution system, they must provide information stating they reviewed, at the minimum, historical permit records and local ordinances, distribution maintenance records and information pertaining to installation dates or materials for all services lines. This information must be verified below.

I HEREBY CERTIFY THAT THE FOLLOWING METHOD(S) WERE USED TO DETERMINE NO LEAD SERVICE LINES EXIST IN THIS WATER SYSTEM'S DISTRIBUTION SYSTEM, AS REQUIRED BY ORC 6109.121(F):

LEAD SERVICE LINE VERIFICATION
<p>This PWS states they have no lead service lines and has reviewed the following information (select one or more of the following):</p> <ul style="list-style-type: none"> <input type="checkbox"/> Historical permit records and/or local ordinances <input type="checkbox"/> Distribution maintenance records (i.e. meter replacement, waterline break repairs) <input type="checkbox"/> Information pertaining to installation dates for all service lines (i.e. after 1986 when lead services lines were banned) <input type="checkbox"/> Service line material of all service lines is known (i.e. all service lines are known to be PVC)

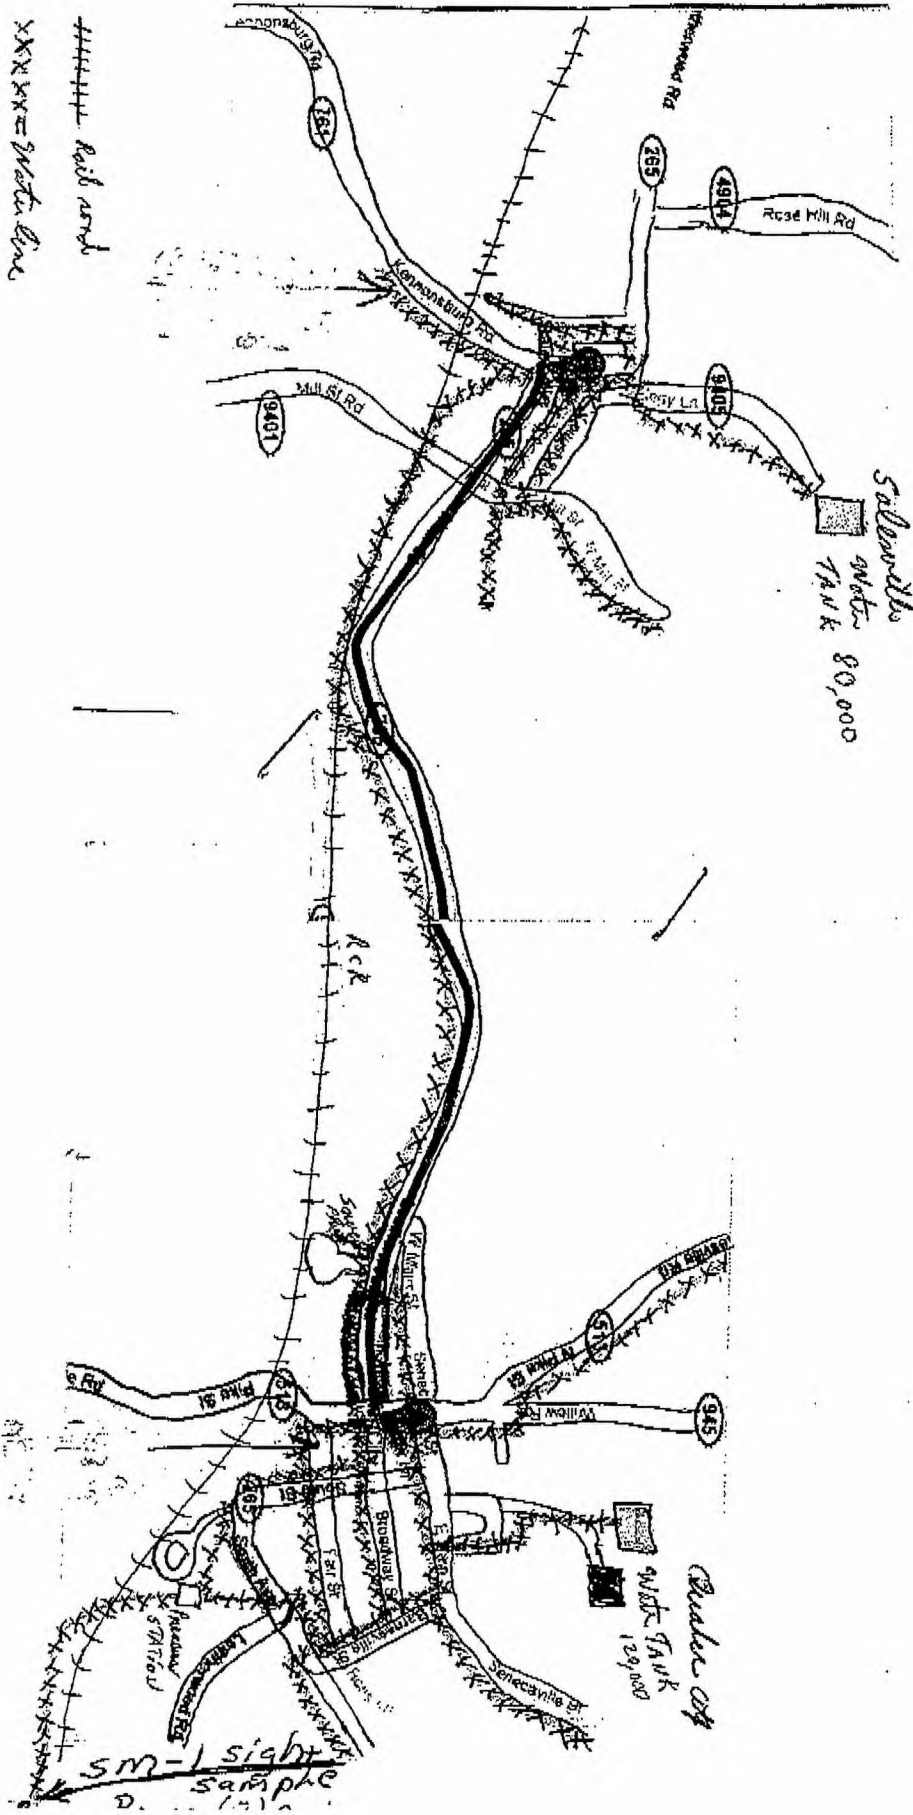
 ANON P. TRACY 3-1-17
 Signature of Responsible Person Date

 ANON P. TRACY
 Printed Name and Title of Responsible Person


<p>For Ohio EPA use only:</p> <p>Date Verification Rec'd: _____</p>
--

2017 MAR - 6 PM 1:25



2017 MAR -6 PM 1:25

SEPA

Ohio (https://livingnewdeal.org/us/oh/?post_type=projects) » Quaker City
(https://livingnewdeal.org/us/oh/quaker-city-oh/?post_type=projects)

WATER SYSTEM – QUAKER CITY OH ([HTTPS://LIVINGNEWDEAL.ORG/PROJECTS/WATER-SYSTEM-QUAKER-CITY-OH/](https://livingnewdeal.org/projects/water-system-quaker-city-oh/))

Project type: Utilities and Infrastructure (<https://livingnewdeal.org/new-deal-categories/infrastructure/>), Water supply (<https://livingnewdeal.org/new-deal-categories/infrastructure/water-supply/>)

New Deal Agencies: Public Works Administration (PWA) (<https://livingnewdeal.org/new-deal-agencies/public-works-administration-pwa/>)

Started: 1935 (https://livingnewdeal.org/start_years/1935/)

Completed: 1935 (https://livingnewdeal.org/completion_years/1935/)

DESCRIPTION

A waterworks construction project was undertaken in Quaker City, Ohio with the assistance of federal Public Works Administration (PWA) funds. The PWA supplied a \$31,000 loan and \$11,975 grant toward the project, whose total cost was \$43,632. Work occurred between February and July 1935.

(PWA Docket No. OH 2743)

2017 MAR -6 PM 1:25

5 PM