



Bethany Christian
Day School
15535 Church Rd
Dalton OH
44618
330 857 0612

Building
Built Prior
To 1998
Service lines
are ~~sewer~~

Entity: Bethany Christian School
Doc Type: RSPAT
Doc Subtype:
Program: PDAGN
County: Wayne
Secondary ID: OH 9531A
SDC in cold

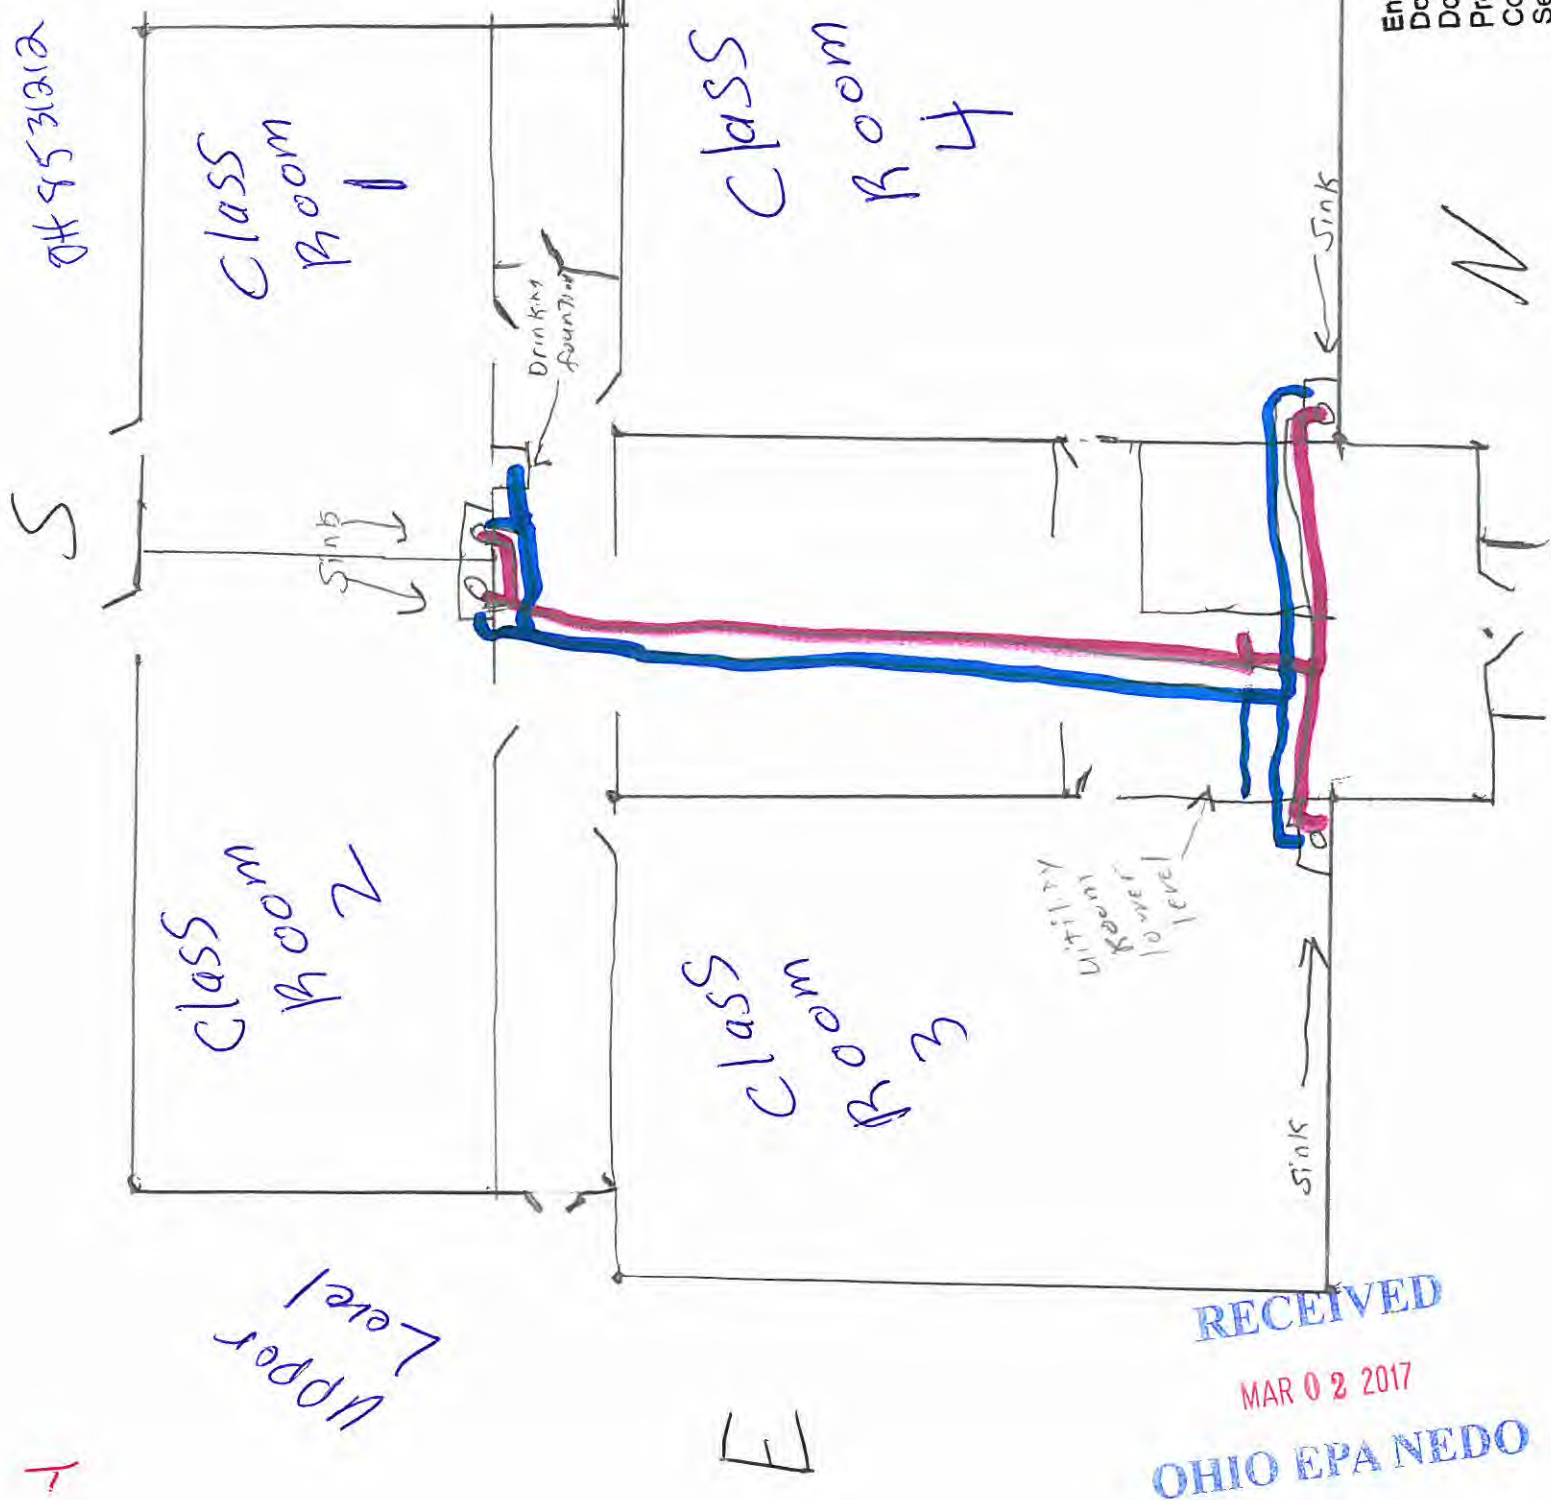

RECEIVED
MAR 02 2017
OHIO EPA NEDO

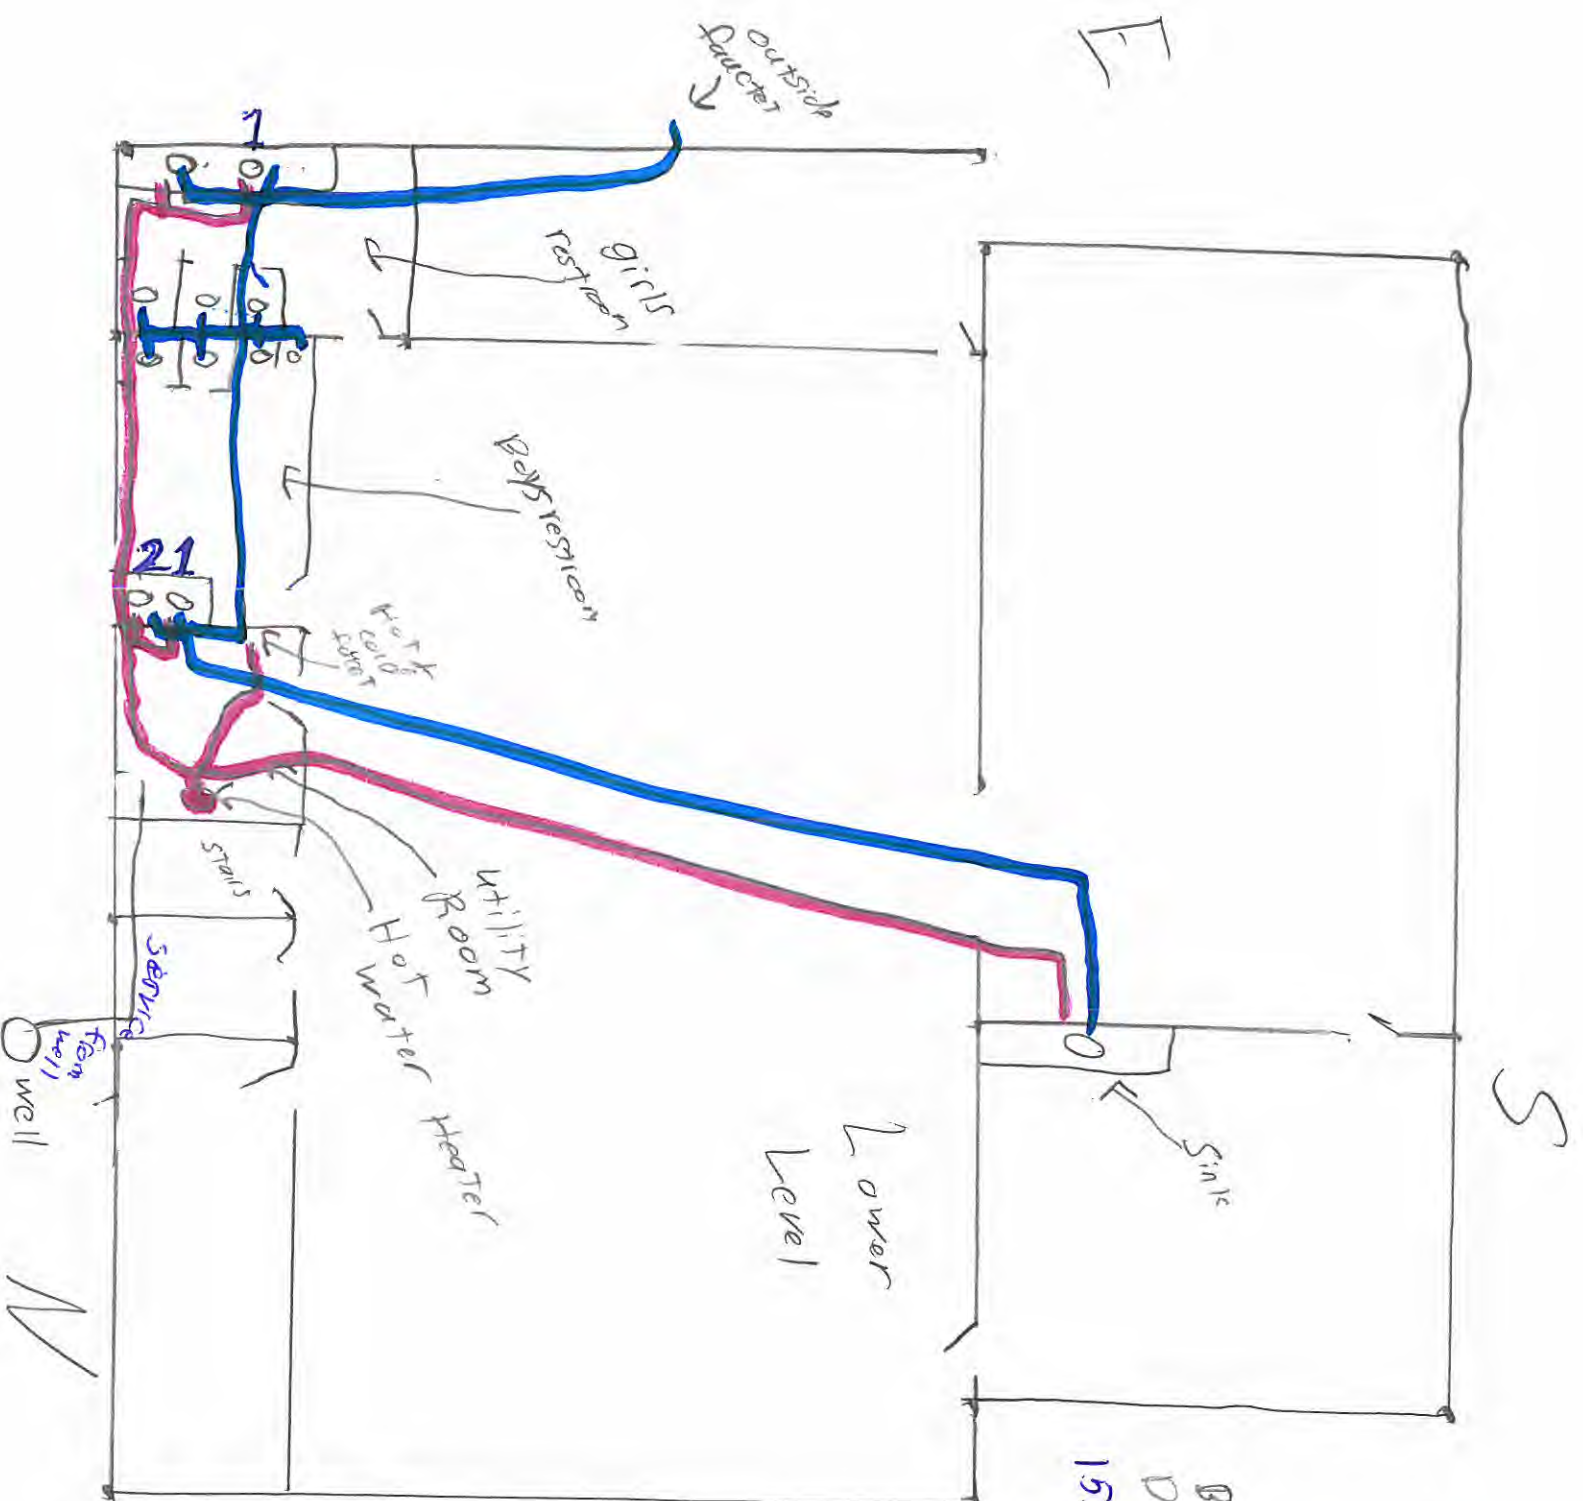

Red Hotwater

Blue cold water

BETHANEY CHRISTIAN
 DAY SCHOOL
 15535 Church Rd

Building
 Built Prior
 1998
 Service Lines
 are Copper